IREDELL COUNTY HEALTH DEPARTMENT

STATESVILLE 704-878-5305 MOORESVILLE 704-664-5281

IMPROVEMENT PERMIT / CERTIFICATE OF COMPLETION / OPERATION PERMIT / EXISTING SYSTEM INSPECTION

PROPERTY DESCRIPTION NO. 0606779 DATE 5/30/97 TAX MAP NO. 4627968090 Watershed: [X] Yes [ ] No

OWNER OR CONTRACTOR E.J. Beasley JR PHONE: Business _____ Home 704 933-1104 WS-IV

ADDRESS 1520 S. Cannon Blvd. Kannapolis, NC 28081

LOCATION Quiet Cove TR Ridge Top TL Greenbay TL Molly Rex at point

SUBDIVISION Mill Creek BLOCK / SECTION 10 LOT 101 LOT AREA .75Acre SITE CLASS D.S. DESIGN FLOW 240gpd L.T.A.R. Existing

Septic Tank: 1000 Gallons; STB 794 Date 4/2/97

Pump Tank: _____ Gallons; PT _____ Date _____

Pump Make: _____ Model _____ Serial No. _____

Nitrification Field: No Fields 1 Square Feet 750 Linear Feet ≈250

No Lines Exist Trench Width System Max Trench Bottom Depth _____ Gravel Depth _____

[ ] New System [X] Repair System Type: I, [II], III, IV, V, VI

~~System Description:~~ _____

Repair System Description: Gravity Conv.

Maintenance Agreement Required: [ ] Yes [X] No

[X] House/Mod. Home No. Bedrooms 2

[ ] Mobile Home No. Bathrooms ____

[ ] Business No. Employees ____

[ ] Other _____


[X] Slab [X] Crawl Space [ ] Basement w/plumbing [ ] Basement wo/plumbing

Water Supply: [X] Individual [ ] Community [ ] Public

Comments: Existing System Inspection - Drainfield working well at time of inspection. No problems observed with drainfield at time of inspection. Approved for 2 Bedrooms

Comments: Septic tank was to close to proposed addition. Existing tank removed & new tank installed >5' from building foundations (existing & proposed) Existing D-box & Drainfield was tied into

INITIAL SITE SKETCH ≈ 1:60

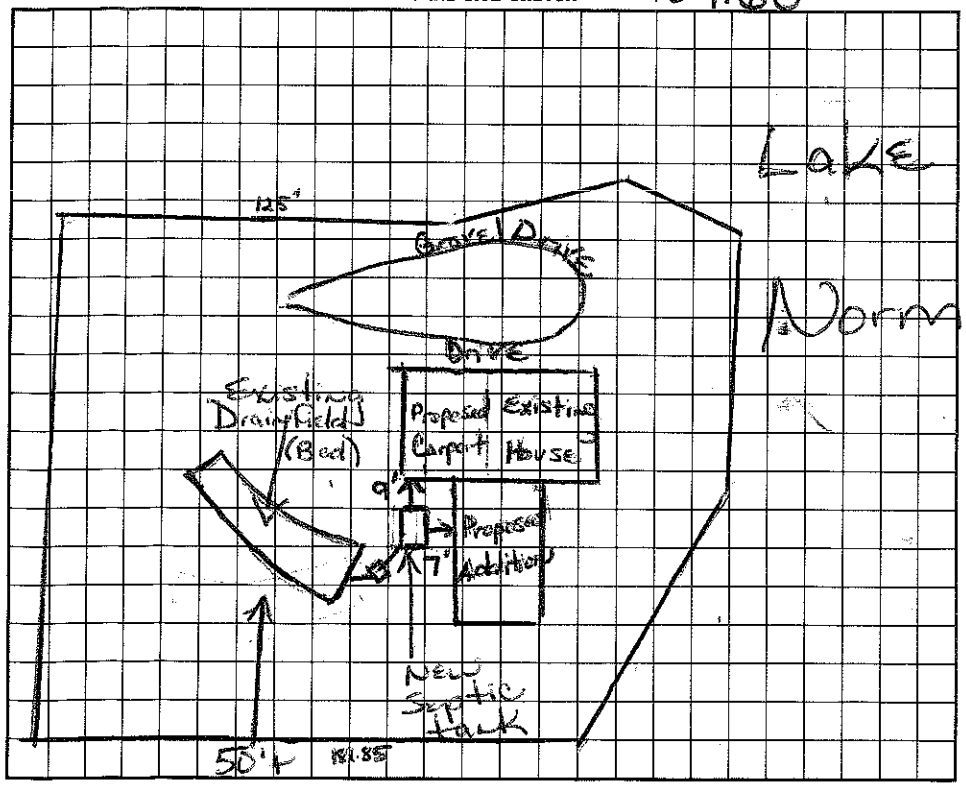

AS BUILT SKETCH

I understand that this permit can be suspended or revoked if any false information is supplied toward securing the permit/any unauthorized changes are made to the site/any unauthorized changes are made in the installation of the system. Improvement Permit is valid for 60 months from date of issuance.

Signed: Jesse Beasley

Repair

Improvement Permit by: Marion H. Dotson date 5/30/97

Existing System Inspection by: Marion H. Dotson date 5/30/97

Installed by: Kannapolis Septic Service Co.

Certificate of Completion by: _____ date _____

Operation Permit by: _____ date _____

HEALTH DEPT. COPY: WHITE INSPECTION COPY (FINAL): GREEN OWNER COPY (FINAL): YELLOW INSPECTION COPY (INITIAL): PINK OWNER COPY (INITIAL): GOLD