375 10:30

IREDELL COUNTY HEALTH DEPARTMENT

STATESVILLE 704-878-5305 MOORESVILLE 704-664-5281

IMPROVEMENT PERMIT / AUTHORIZATION TO CONSTRUCT / OPERATION PERMIT / EXISTING SYSTEM INSPECTION

PERMIT# 113535 PIN# ~~4627-88-5496.037~~ 4627-96-9653 DATE Oct 22, 03

OWNER OR CONTRACTOR Greenbay Forest LLC / COPPERSTONE BLDRS. PHONE: Business ______ Home ______

ADDRESS P.O. Box 3608, Mooresville, N.C. 28117

LOCATION 150 West, TL Paradise Peninsula, TL Greenbay near end on left (next to Springs Shores)

SUBDIVISION Greenbay Forest BLOCK / SECTION ______ LOT 37 LOT AREA 1.30 Ac SITE CLASS. PS DESIGN FLOW 480 gpd L.T.A.R. .025

Septic Tank: 1000 Gallons; STB 3/2 Date 8-22-06
Pump Tank: 1000 Gallons; PT 2/1 Date 11-13-06
Pump Make: Myers Model ME50 Serial No. ______
Nitrification Field: No Fields 1 Square Feet 640 / 960 Linear Feet 320
No Lines ~5 Trench Width 3/4" min 8" over, 36" max 9" ce Max Trench Bottom Depth 36" Gravel Depth NA

☑ New System ☐ Repair System Type: I, II, III, (IV), V, VI
System Description: LPPBBS
Repair System Description: LPPBBS
Maintenance Agreement Required: ☑ Yes ☐ No

☑ House/Mod. Home ☐ Mobile Home ☐ Business ☐ Other ______
No. Bedrooms 4 No. Bathrooms 4 No. Employees ______
☐ Slab ☑ Crawl Space ☐ Basement w/plumbing ☐ Basement wo/plumbing


Water Supply: ☑ Individual ☐ Public ☐ Community

Comments:/Conditions: initial system drainfield and repair area must be within rear 200' of lot; soils getting worse/changing to unsuitable as you approach the street


Comments:/Conditions: Checked tanks & lines 12/19/06 MD

1" = 50'

INITIAL SITE SKETCH

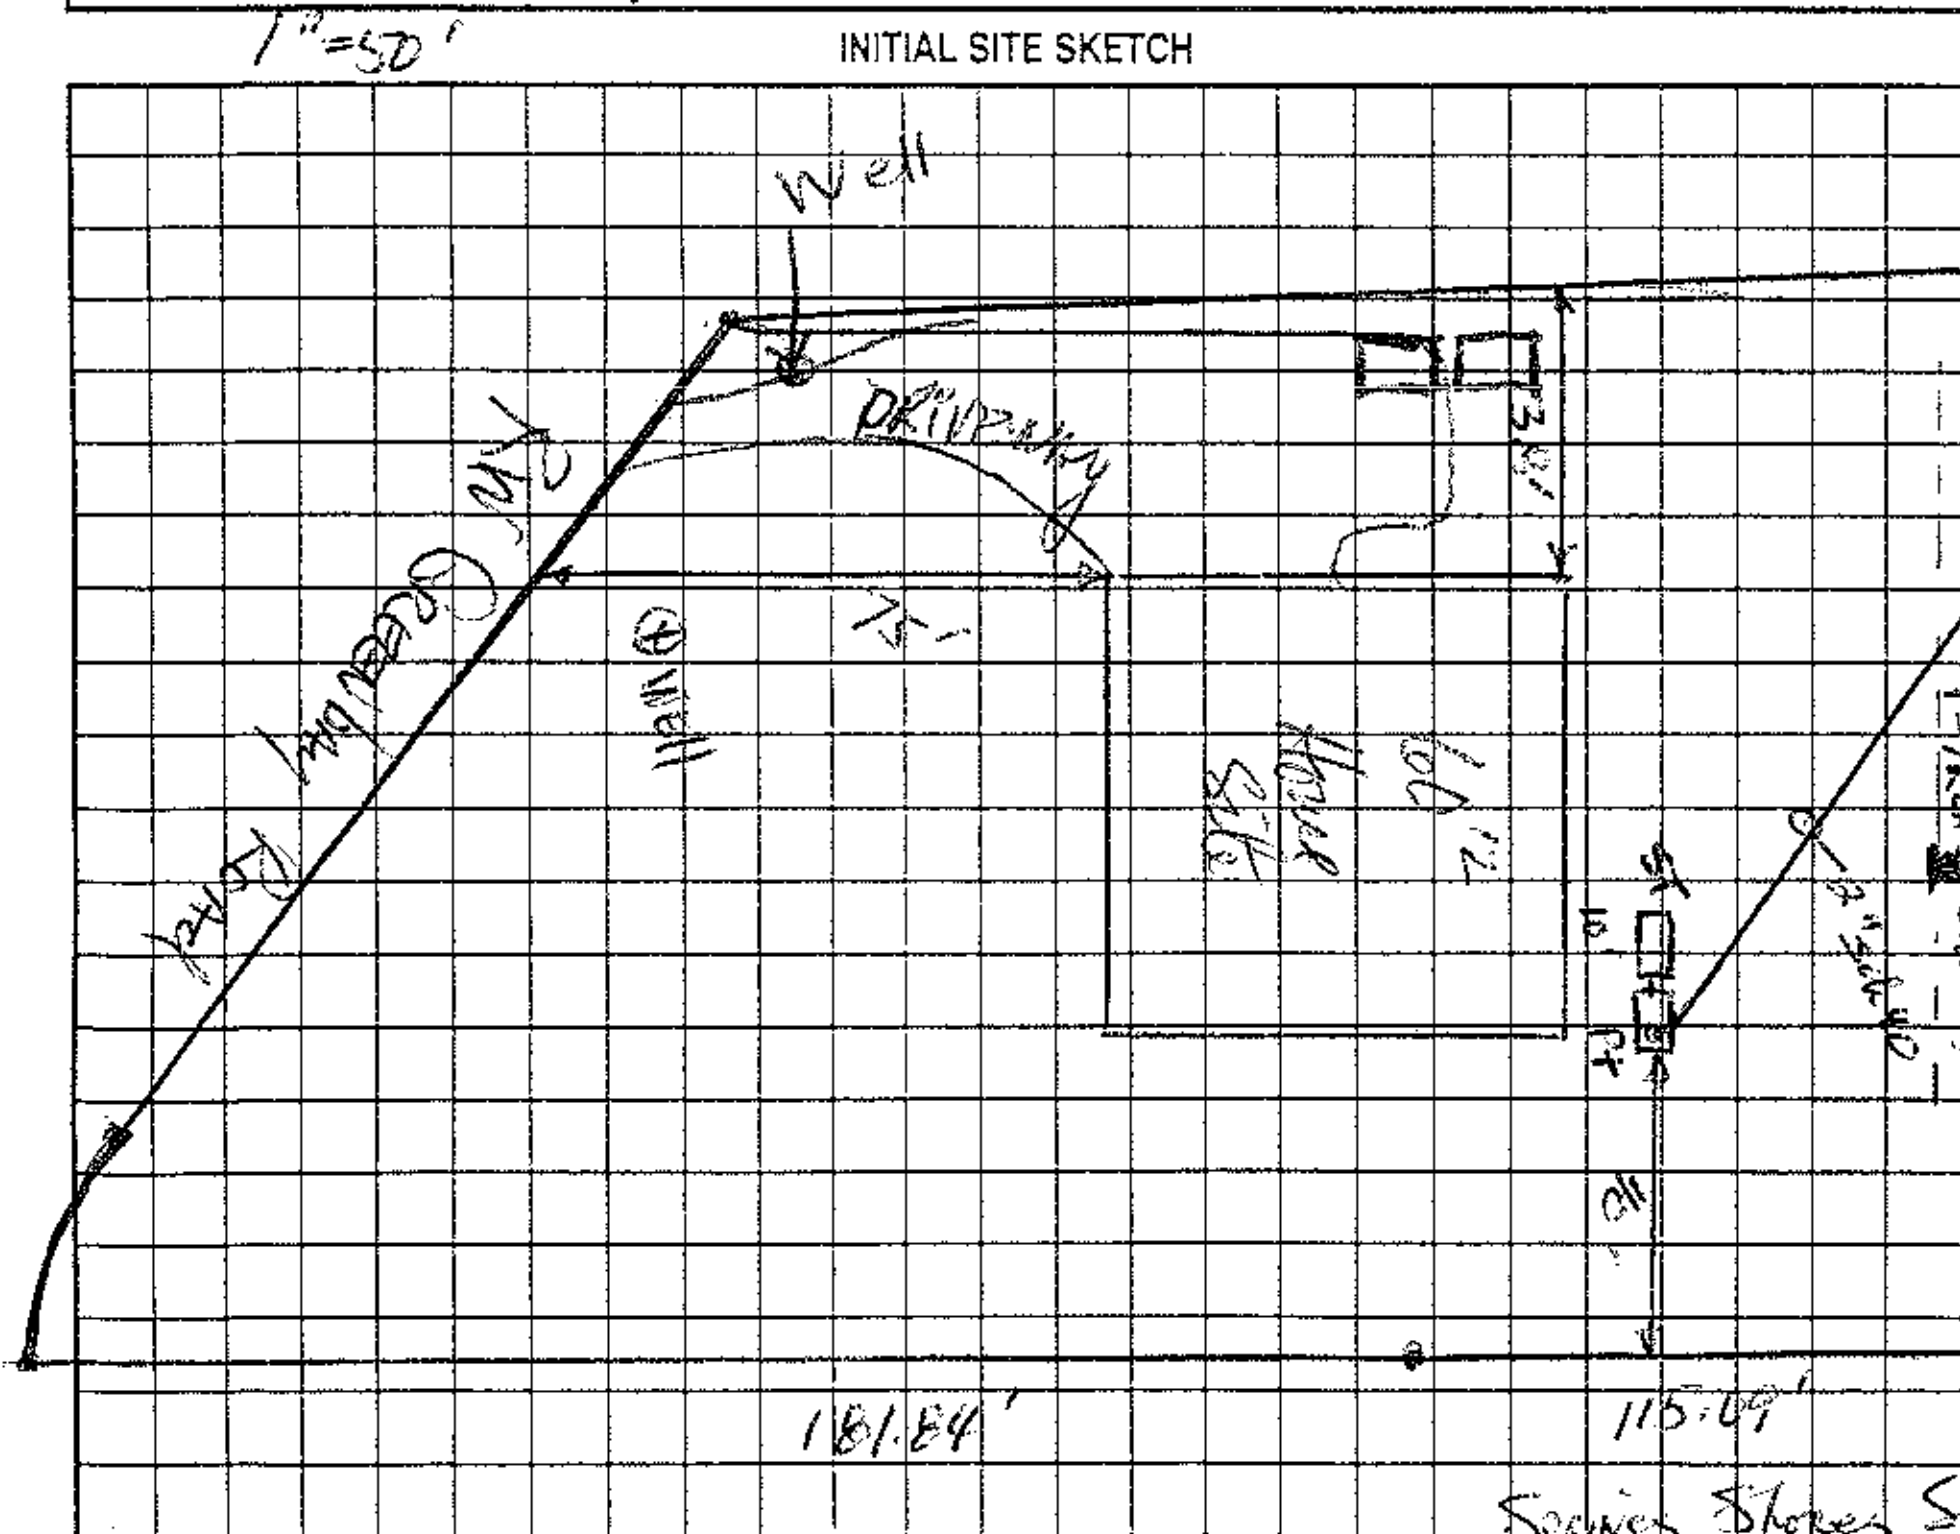

AS BUILT SKETCH

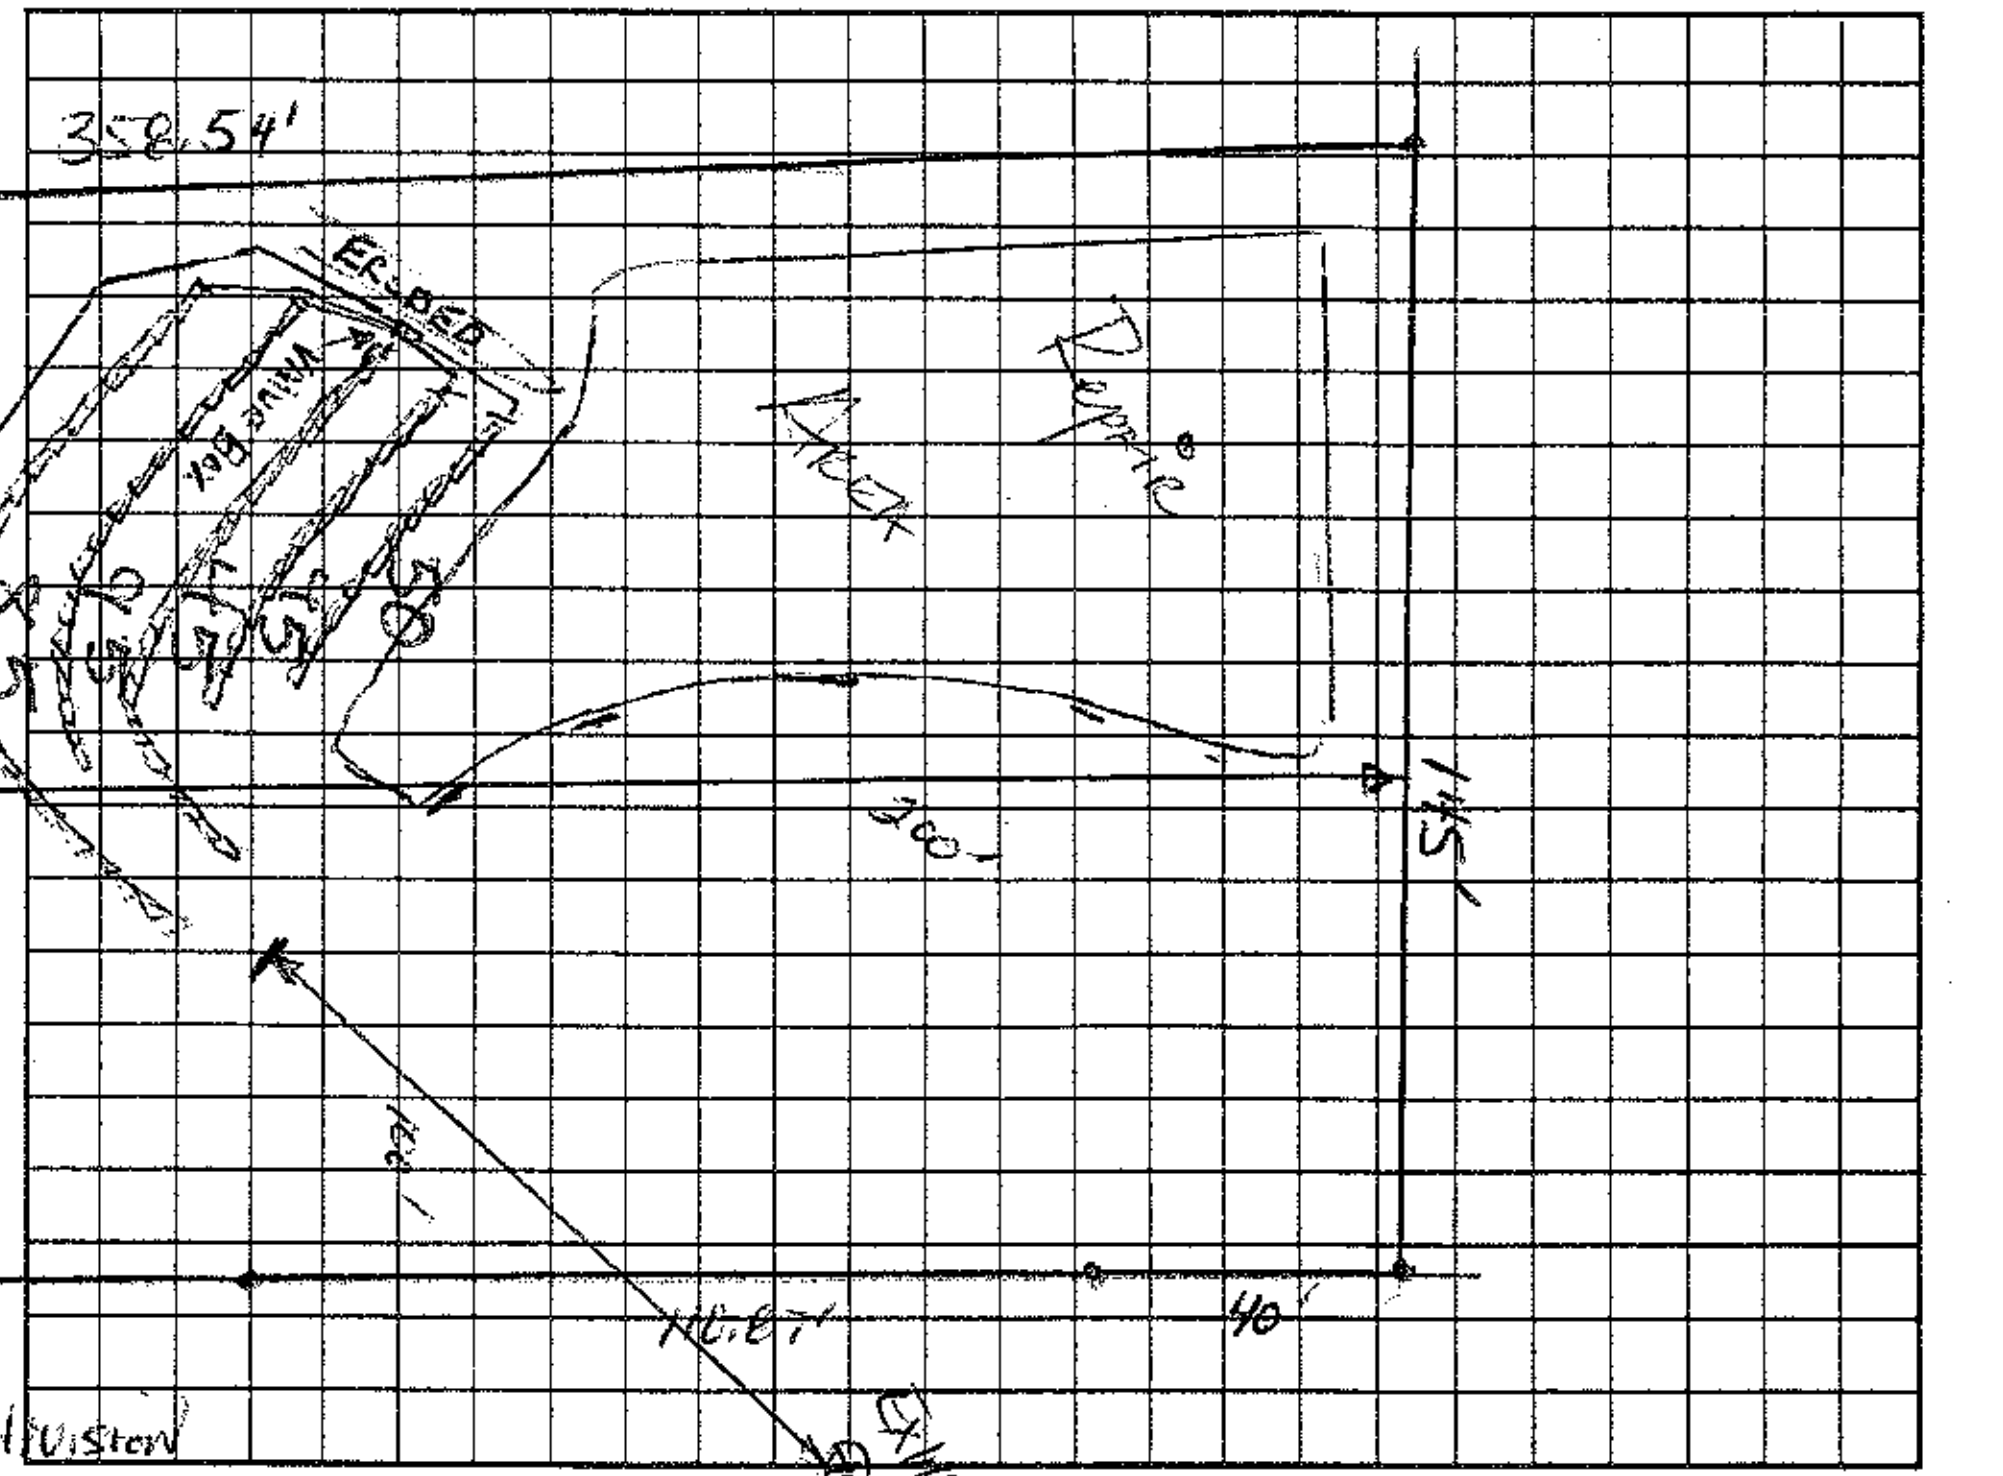

Permit can be suspended or revoked if any false information is supplied toward securing the permit/any unauthorized changes are made to the site/any unauthorized changes are made in the installation of the system. Improvement Permit with plat valid without expiration. Improvement Permit with site plan valid for sixty months. Authorization to Construct is valid for a period equal to that of Improvement Permit – not to exceed sixty months.

Signed: [signature] date 10-30-03 Installed by: R&H

Improvement Permit by: [signature], RS date 10-22-03 Operation Permit by: [signature] RS date 2/28/07

Authorization to Construct by: [signature] RS date 4/7/06 Existing System Inspection by: ______ date ______

HEALTH DEPT. COPY: WHITE OWNER COPY (FINAL): YELLOW OWNER COPY (INITIAL): PINK