IREDELL COUNTY HEALTH DEPARTMENT

STATESVILLE 704-878-5305 ~~MOORESVILLE 704-664-5281~~

IMPROVEMENT PERMIT / AUTHORIZATION TO CONSTRUCT / OPERATION PERMIT / EXISTING SYSTEM INSPECTION

PERMIT # 153688 PIN # 4627976073 DATE 11/24/08

OWNER or APPLICANT MICHAEL WILLIAMS PHONE: Business 704-660-1423 Home:

OWNER or APPLICANT ADDRESS 413 GREENBAY RD.

LOCATION / DIRECTIONS 150W TL QUIET COVE TR RIDGETOP TR GREENBAY, # 413 ON (R)

SUBDIVISION GREENBAY FOREST BLOCK / SECTION LOT # 30 LOT AREA ~1.2AC DESIGN FLOW 480 L.T.A.R. .3 INITIAL / .2 REPAIR

Septic Tank 1000 Gallons: STB Date

Pump Tank Gallons: PT

Pump Make EXISTING SYSTEM Model Serial #

Nitrification Field No Fields No Lines 5 Linear Feet 533

Trench Width Max. Trench Bottom Depth Gravel Depth 12" ☒ GRAVITY ☐ PRESSURE

☐ New System ☐ Repair ☐ Expansion System Type I (II) III IV V VI

System Description:

Repair System Description:

Maintenance Agreement Required ☐ YES ☒ NO

☒ Residence No. Bedrooms 4

☐ Business No. Persons

☐ Other No. Employees

☐ Slab ☒ Crawl Space

☐ Basement w/plumbing ☐ Basement w/o plumbing


Water Supply: ☒ Private ☐ Public ☐ Community

Comments / Conditions

Comments / Conditions

INITIAL SITE SKETCH

AS BUILT SKETCH

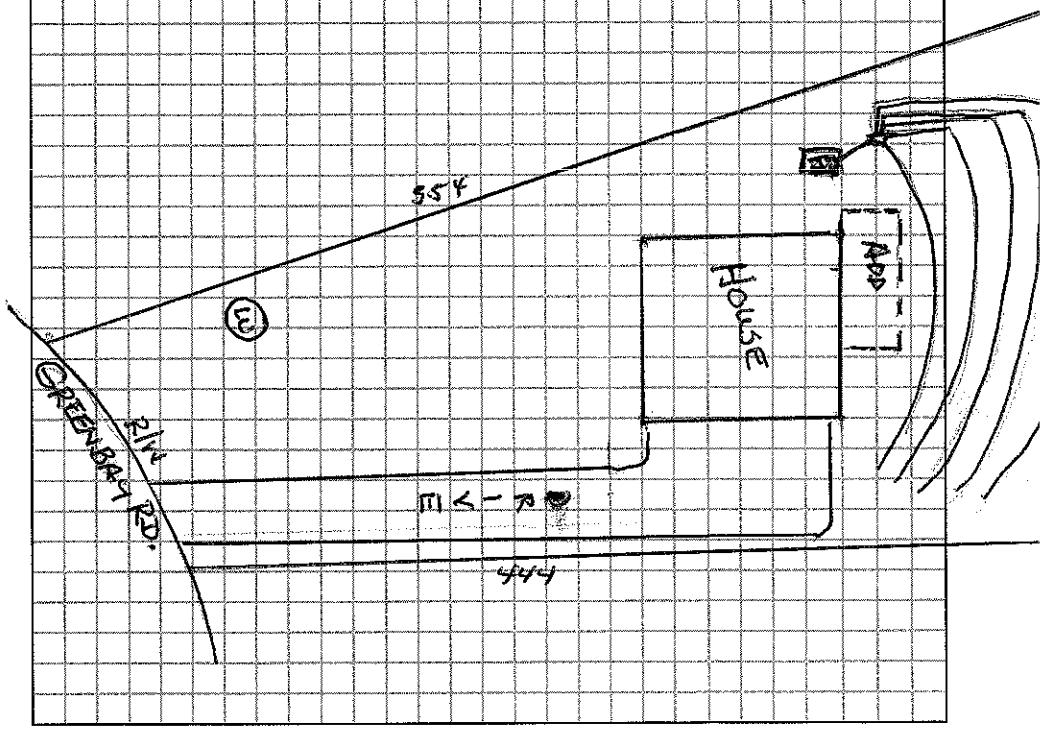

Permit can be suspended or revoked if any false information is supplied toward securing the permit / any unauthorized changes are made to the site / any unauthorized changes are made in the installation of the system.

☐ *IMPROVEMENT PERMIT w / plat valid without expiration.* ☐ *IMPROVEMENT PERMIT w / site plan valid for 60 mos.* ☐ *AUTHORIZATION TO CONSTRUCT valid for period equal to IMPROVEMENT PERMIT-not to exceed 60 mo.*

Owner / Applicant Signature: Eleanor M. Williams Date 11/25/08

Improvement Permit by: Date

Authorization to Construct by: Date

YOU SHOULD CONTACT A LOCATOR SERVICE PRIOR TO ANY EXCAVATION.

Installed by:

Operation Permit by: Date:

Existing System Inspected by: Wesley Sparks R.S. Date: 11/24/08

WHITE COPY Environmental Health YELLOW COPY (Final) Owner / Applicant PINK COPY (Initial) Owner / Applicant