IREDELL COUNTY HEALTH DEPARTMENT

STATESVILLE 704-878-5305 MOORESVILLE 704-664-5281

IMPROVEMENT PERMIT / CERTIFICATE OF COMPLETION / OPERATION PERMIT / EXISTING SYSTEM INSPECTION

PROPERTY DESCRIPTION NO. 071686 DATE 2/19/98 TAX MAP NO. 4627998097 Watershed: [X] Yes [ ] No (WSIVCA)

OWNER OR CONTRACTOR Rebecca Taylor PHONE: Business _____ Home 664-5761

ADDRESS 108 Landover Lane Mooresville, NC. 28115

LOCATION 150 West on (L) just past Quest Cove Lane

SUBDIVISION SHELTON MARTHA BLOCK/ SECTION _____ LOT 3 LOT AREA 1.29 Ac SITE CLASS. PS DESIGN FLOW 100 L.T.A.R. .25

Septic Tank: 1000 Gallons; STB 794 Date 2/26/98

Pump Tank: 1000 Gallons; PT 27 Date 2/25/98

Pump Make: _____ Model _____ Serial No. _____

Nitrification Field: No Fields 1 Square Feet 400 Linear Feet 200

No Lines 4 Trench Width 36" Max Trench Bottom Depth 36" Gravel Depth 12"

[X] New System [ ] Repair System Type: I, II, (III) IV, V, VI

System Description: PRES MAN - CONVENTIONAL

Repair System Description: SAME

Maintenance Agreement Required: [ ] Yes [X] No

[ ] House/Mod. Home No. Bedrooms _____

[ ] Mobile Home No. Bathrooms _____

[X] Business No. Employees 4

[ ] Other RETAIL CAR SALES


[X] Slab [X] Crawl Space [ ] Basement w/plumbing [ ] Basement wo/plumbing

Water Supply:
[X] Individual
[ ] Community
[ ] Public


Comments: Retail Sales Only - Not approved for any type of Food or Beverage Sales!

Comments:

INITIAL SITE SKETCH

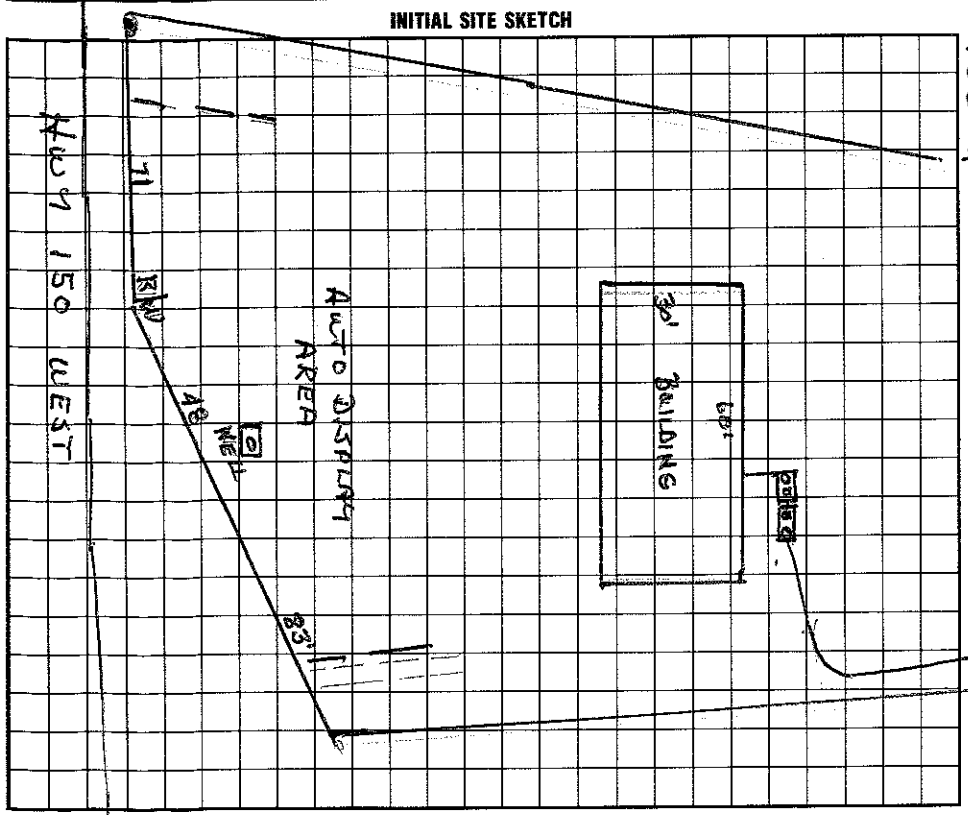

AS BUILT SKETCH

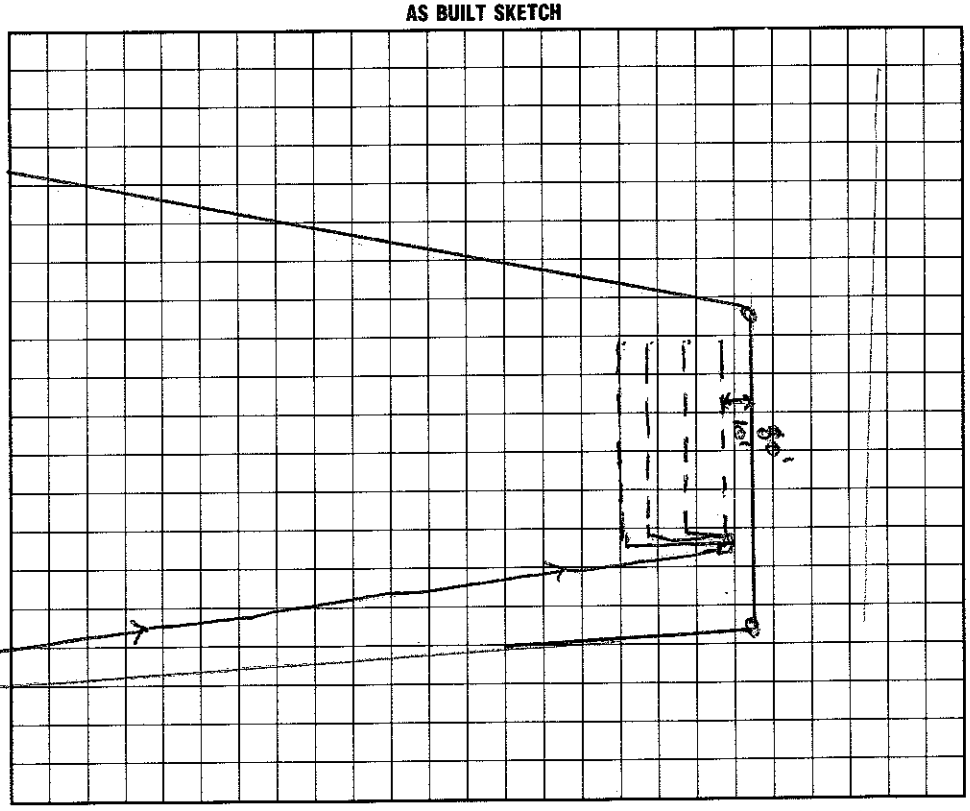

I understand that this permit can be suspended or revoked if any false information is supplied toward securing the permit/any unauthorized changes are made to the site/any unauthorized changes are made in the installation of the system.

R & L Taylor

by: Wesley Sparks RS. date 2/19/98

Inspection by: Wesley Sparks RS. date 2/19/98

Installed by: Lavon Benton

Certificate of Completion by: Wesley Sparks RS. date 7/28/98

Operation Permit by: Wesley Sparks RS. date 7/28/98

PT. COPY: WHITE INSPECTION COPY (FINAL): GREEN OWNER COPY (FINAL): YELLOW INSPECTION COPY (INITIAL): PINK OWNER COPY (INITIAL): GOLD