IREDELL COUNTY HEALTH DEPARTMENT

AUTHORIZATION TO CONSTRUCT

STATESVILLE 704-878-5305 MOORESVILLE 704-664-5281

IMPROVEMENT PERMIT / ~~CERTIFICATE OF COMPLETION~~ / OPERATION PERMIT / EXISTING SYSTEM INSPECTION

PROPERTY DESCRIPTION NO. 066597 DATE 5/5/97 TAX MAP NO. 4628 30 6055 Watershed: ☑ Yes ☐ No

OWNER OR CONTRACTOR KENNETH DEALER HOMES PHONE: Business 704-662-6400 Home

ADDRESS PO BOX 1370 NO CORNELIUS NC 28031

LOCATION 150 W - TL MARINER PT LN - 12TH LOT ON RT

SUBDIVISION PINNACLE SHORES BLOCK / SECTION III LOT 12 LOT AREA .75 AC SITE CLASS. C5 DESIGN FLOW 480 GPD L.T.A.R. .3 GPD/FT2

Septic Tank: 1000 Gallons; STB 794 Date 8/18/97

Pump Tank: Gallons; PT Date

Pump Make: Model Serial No.

Nitrification Field: No Fields 1 Square Feet 1200 Linear Feet 400

No Lines 5 @ 80' Trench Width 36" Max Trench Bottom Depth 36" Gravel Depth N/A

☑ New System ☐ Repair System Type: I, II, ⓘ, IV, V, VI

System Description: GRAVITY CHAMBERED OR SIMILAR

Repair System Description: PUMP PANEL

Maintenance Agreement Required: ☐ Yes ☑ No

☑ House/Mod. Home ☐ Mobile Home ☐ Business ☐ Other

No. Bedrooms 4 No. Bathrooms 4 No. Employees


☐ Slab ☐ Crawl Space ☑ Basement w/plumbing ☐ Basement wo/plumbing

Water Supply: ☐ Individual ☑ Community ☐ Public


Comments: DRIVE SHALL NOT CUT THROUGH REPAIR AREA. KEEP SYSTEM 50' FROM LAKE AND 10' FROM HOME.

Comments:

INITIAL SITE SKETCH 1" = 50'

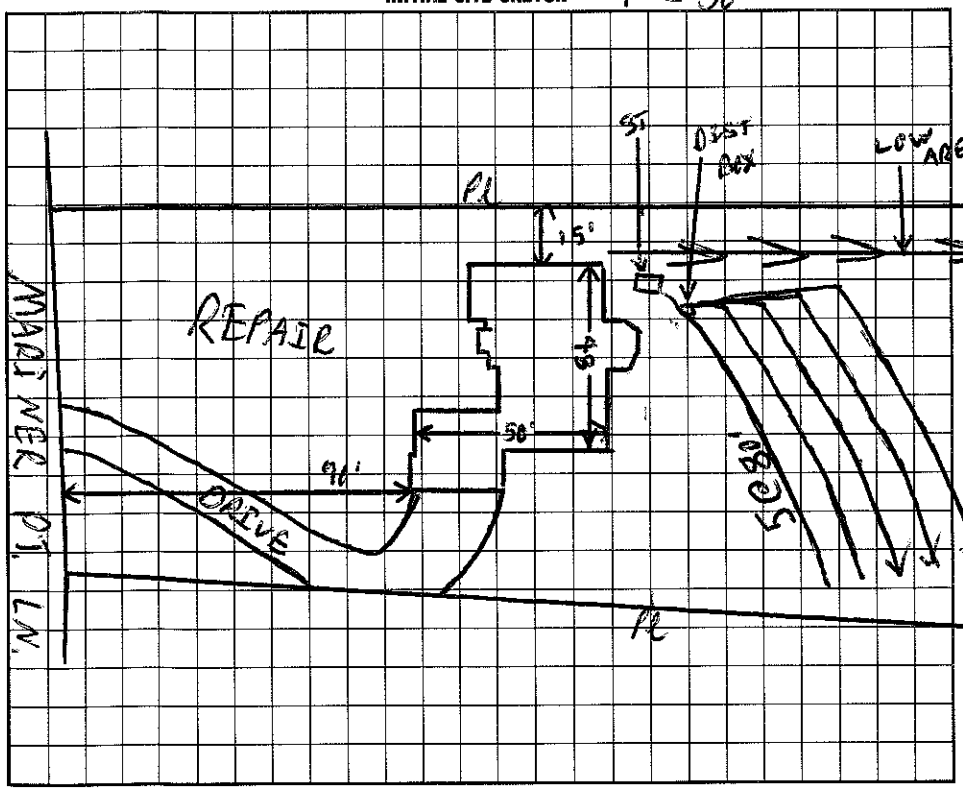

AS BUILT SKETCH

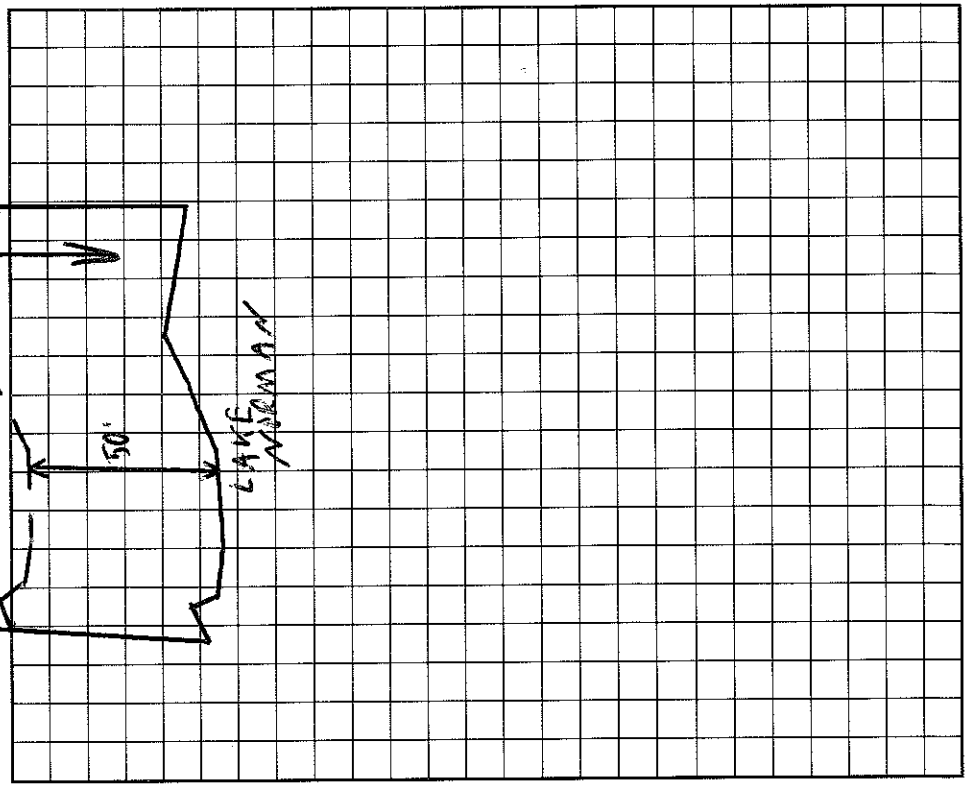

I understand that this permit can be suspended or revoked if any false information is supplied toward securing the permit/any unauthorized changes are made to the site/any unauthorized changes are made in the installation of the system. Improvement Permit is valid for 60 months from date of issuance.

Signed: Barbara Martin

Improvement Permit by: C. Ray Tuten date 5/5/97

AUTHORIZATION

~~Existing System Inspection by:~~ C. Ray Tuten date 5/5/97

Installed by: Tim Simmons

Certificate of Completion by: Wesley Sparks RS date 10/23/97

Operation Permit by: Wesley Sparks RS date 10/23/97

TO CONSTRUCT HEALTH DEPT. COPY: WHITE INSPECTION COPY (FINAL): GREEN OWNER COPY (FINAL): YELLOW INSPECTION COPY (INITIAL): PINK OWNER COPY (INITIAL): GOLD