IREDELL UNTY HEALTH DEPARTMENT

STATESVILLE 704-878-5305 MOORESVILLE 704-664-5281

IMPROV NT PERMIT / AUTHORIZATION TO CONSTRUCT / OPERATION PERMIT / EXISTING SYSTEM INSPECTION

PERMIT # N/A PIN # 4628306125 DATE 6-6-2011

OWNER or APPLICANT Juanita Mabry PHONE: Business 704 408-1416 Home:

OWNER or APPLICANT ADDRESS 160 Mariner Pt. Ln Mooresville NC 28117

LOCATION / DIRECTIONS Hwy 150 West TL Mariner Pt. Ln. (B4 (Catawba/Iredell Bridge) house on right

SUBDIVISION Pinnacle Shores BLOCK / SECTION 3 LOT # 11 LOT AREA .76Ac DESIGN FLOW 480gpd L.T.A.R. .3-.35

Existing: Septic Tank 1000 Gallons: STB Date

Pump Tank 1000 Gallons: PT Date

Pump Make Model Serial #

Nitrification Field No Fields 1 No Lines 1 Linear Feet ~80ft

Trench Width 36" Max. Trench Bottom Depth 36" Gravel Depth N/A ☐ GRAVITY ☒ PRESSURE

☐ New System ☐ Repair ☒ Expansion System Type I II (III) V V VI

System Description: Pump-PM-25% Reduction

Repair System Description: Pump Panel Block

Maintenance Agreement Required ☐ YES ☒ NO

☒ Residence No. Bedrooms 4

☐ Business No. Persons

☐ Other No. Employees

☐ Slab ☐ Crawl Space


☐ Basement w/plumbing ☐ Basement w/o plumbing

Water Supply ☐ Private ☒ Public ☒ Community

Comments / Conditions: Add 1-80ft line to existing Drainfield. Relocate Pressure Manifold to highest line. Keep septic at least 10ft from PL

Comments / Conditions: Note: Ok to install Drainline closer to existing field if desired. 6/22/2011 Checked new line, set pressure

INITIAL SITE SKETCH

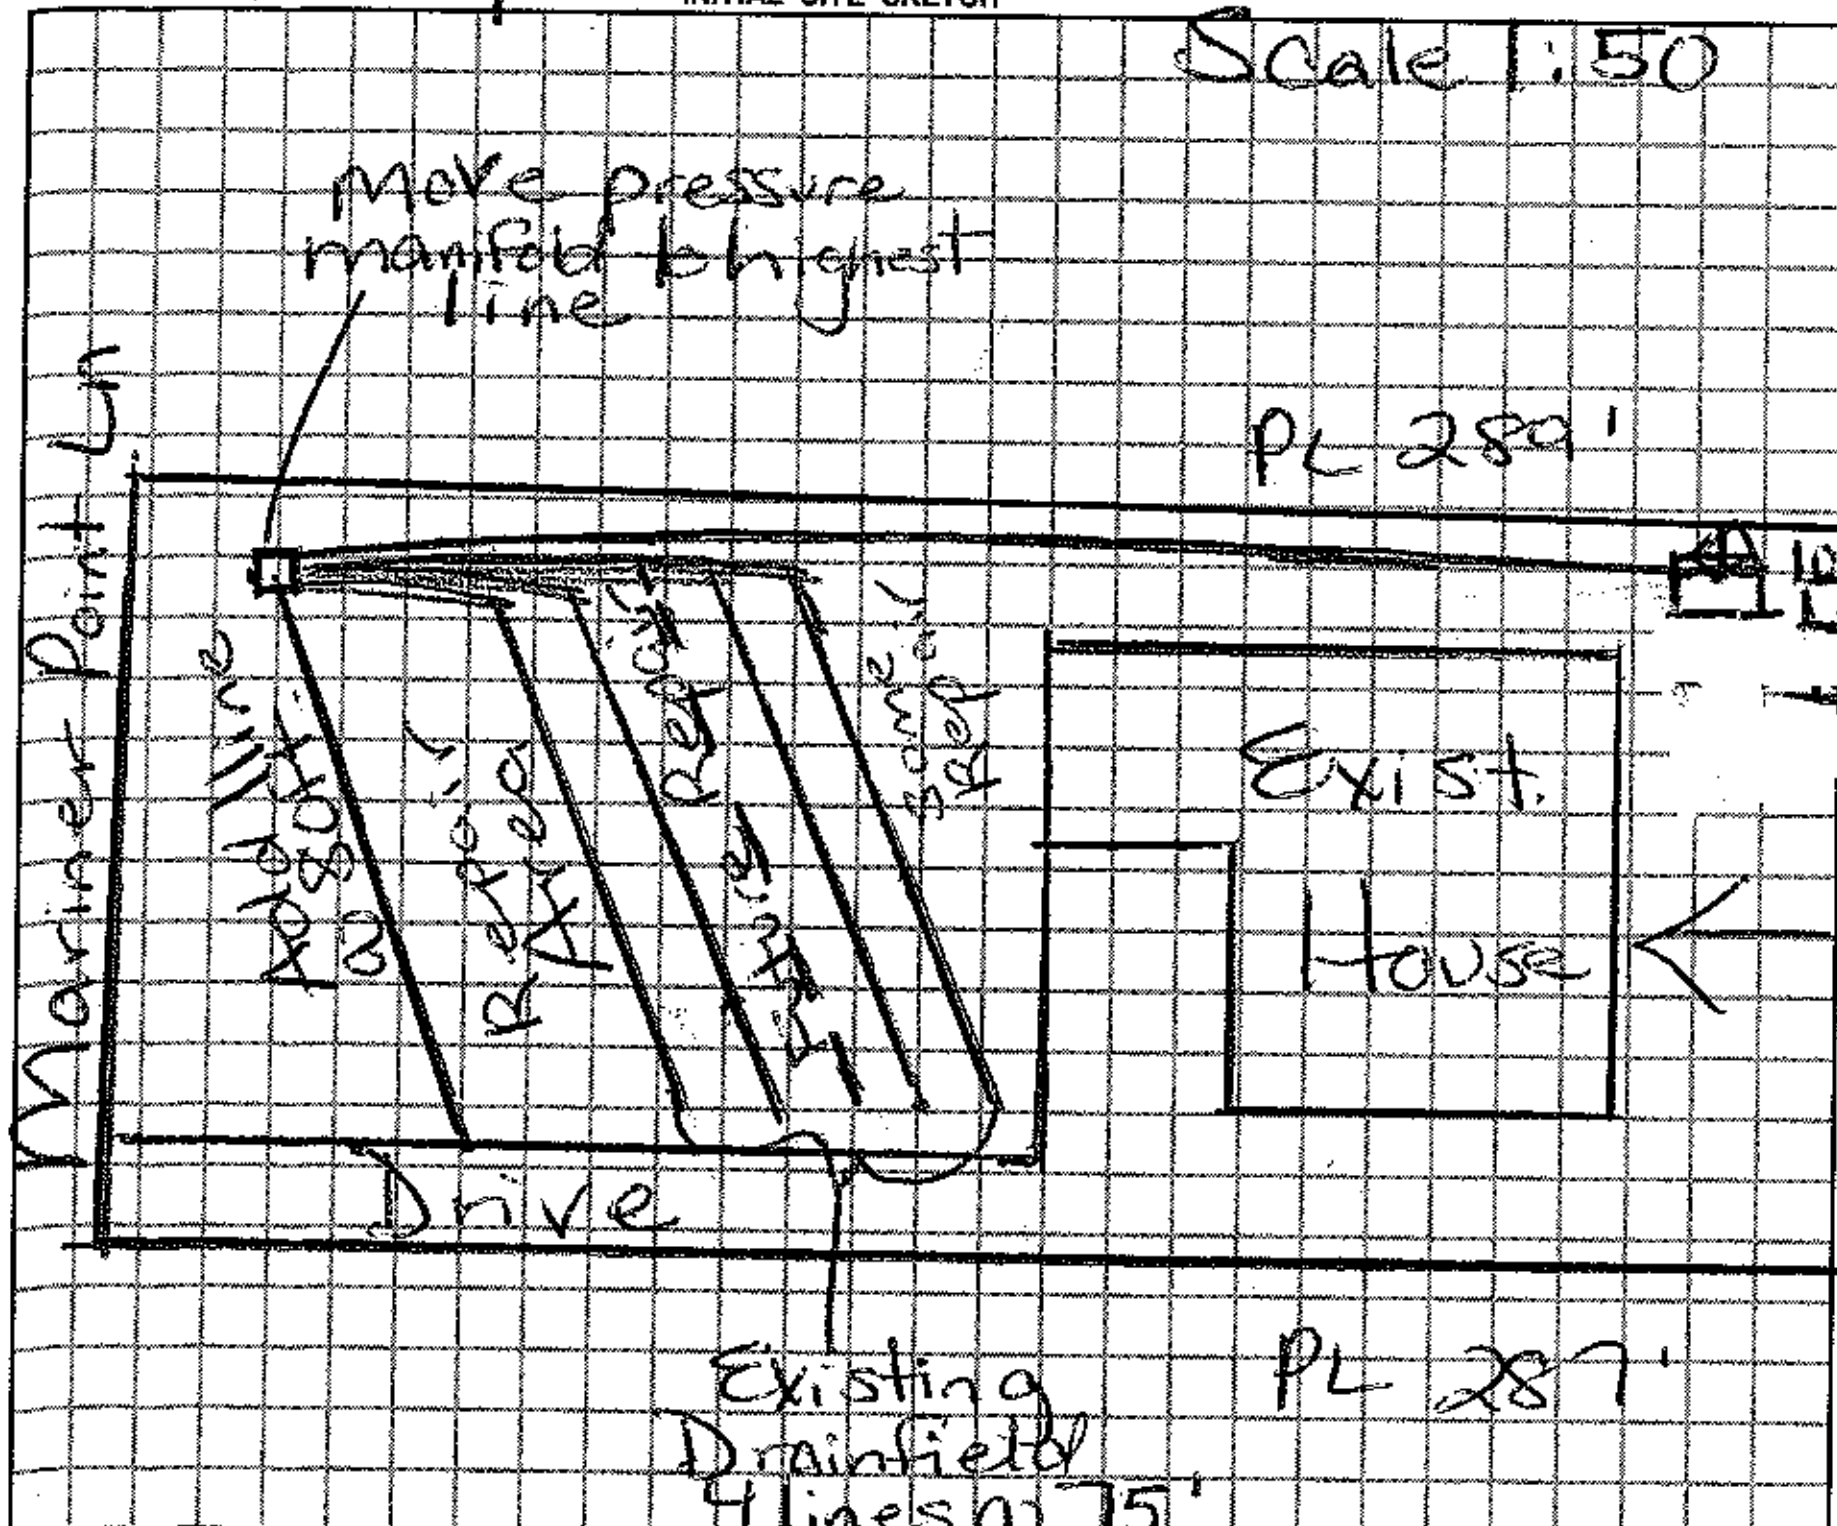

AS BUILT SKETCH

Permit can be suspended or revoked if any false information is supplied toward securing the permit / any unauthorized changes are made to the site / any unauthorized changes are made in the installation of the system.

☐ *IMPROVEMENT PERMIT w / plat valid without expiration* ☐ *IMPROVEMENT PERMIT w / site plan valid for 60 mos.* ☐ *AUTHORIZATION TO CONSTRUCT valid for period equal to IMPROVEMENT PERMIT-not to exceed 60 mo.*

Owner / Applicant Signature: [signature] Date 6-7-11

Improvement Permit by: [signature] Date 6/6/2011

Authorzation to Construct by: [signature] Date 6/6/2011

Installed by: Larry Henkle

Operation Permit by: [signature] REHS Date: 6/22/2011

Existing System Inspected by: Date:

YOU SHOULD CONTACT A LOCATOR SERVICE PRIOR TO ANY EXCAVATION.

WHITE COPY Environmental Health YELLOW COPY (Final) Owner / Applicant PINK COPY (Initial) Owner / Applicant