IREDELL COUNTY HEALTH DEPARTMENT

STATESVILLE 704-878-5305 MOORESVILLE 704-664-5281

$130

IMPROVEMENT PERMIT / AUTHORIZATION TO CONSTRUCT / OPERATION PERMIT / EXISTING SYSTEM INSPECTION

PERMIT# 118096 PIN# 4628-30-6125

OWNER OR CONTRACTOR Robin Hoover Builders PHONE: Business 704-634-8102 Home DATE 2/9/04

ADDRESS PO Box 657 Denver NC 28037

LOCATION Hwy 150 W, Lt Mariners Pt, on Rt 160 Mariners Pt

SUBDIVISION Pinnacle Shores BLOCK / SECTION 3 LOT 11 LOT AREA 0.764c SITE CLASS PS DESIGN FLOW 360 L.T.A.R. 0.3

Septic Tank: 1000 Gallons; STB 794 Date 9-13-04

Pump Tank: 1000 Gallons; PT 283 Date 9-14-04

Pump Make: Goulds Model WE0712HH Serial No.

Nitrification Field: No Fields 1 Square Feet 900 Linear Feet 300

No Lines 4@75 Trench Width 36" Max Trench Bottom Depth 36" Gravel Depth —

☒ New System ☐ Repair System Type: I, II, III, IV, V, VI (II)

System Description: PM 25% Reduction

Repair System Description: Pump 25% Reduction

Maintenance Agreement Required: ☐ Yes ☒ No

☒ House/Mod. Home No. Bedrooms 3

☐ Mobile Home No. Bathrooms 3

☐ Business No. Employees

☐ Other

☐ Slab ☐ Crawl Space ☐ Basement w/plumbing ☒ Basement wo/plumbing

Water Supply: ☐ Individual ☐ Public ☒ Community

Comments:/Conditions:

1"=50'


Comments/Conditions:

10/25 ST moved to 10' off PL


Lines Checked 10/25/04

Checked Press, elect & alarm 10/29/04

INITIAL SITE SKETCH

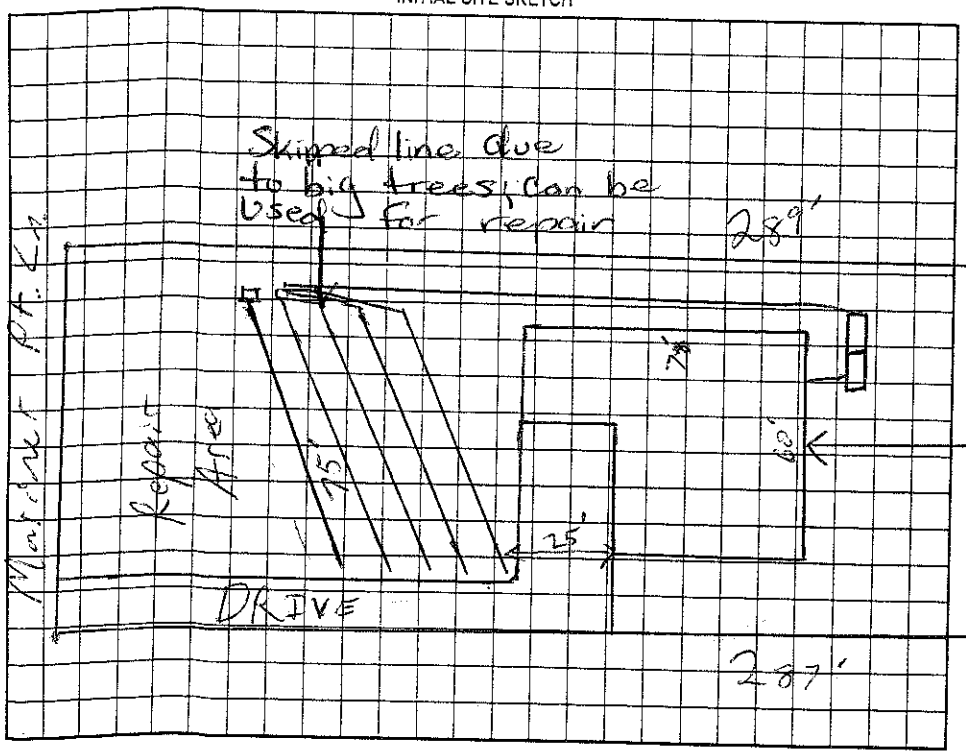

AS BUILT SKETCH

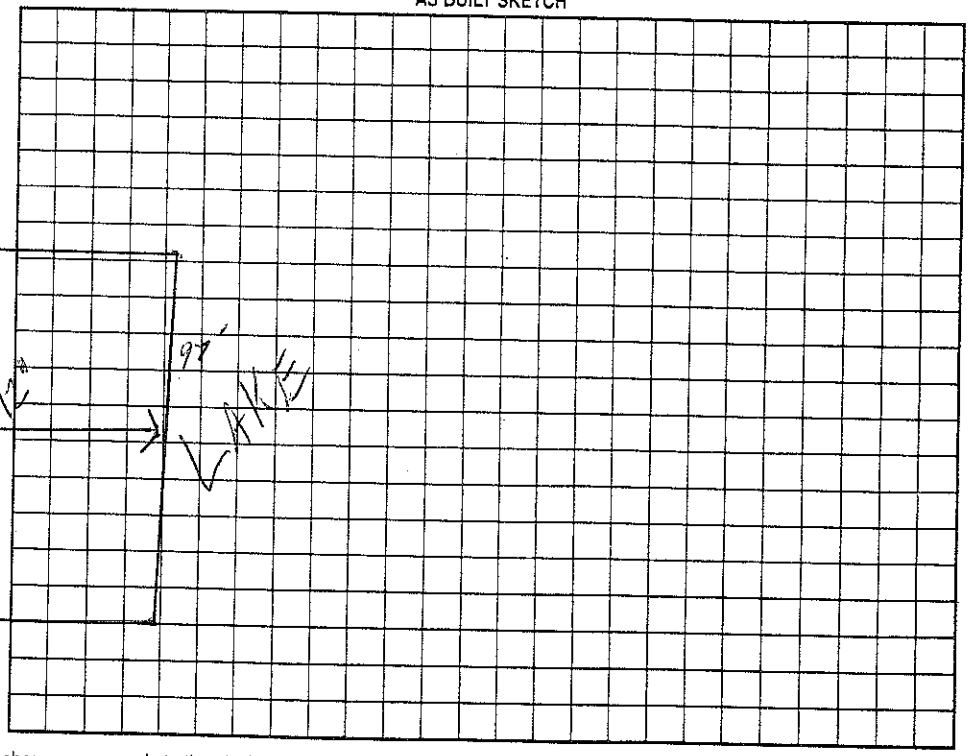

Permit can be suspended or revoked if any false information is supplied toward securing the permit/any unauthorized changes are made to the site/any unauthorized changes are made in the installation of the system. Improvement Permit with plat valid without expiration. Improvement Permit with site plan valid for sixty months. Authorization to Construct is valid for a period equal to that of Improvement Permit – not to exceed sixty months.

Signed: [signature] date 2/10/04

Improvement Permit by: [signature] RS date 2/9/04

Authorization to Construct by: [signature] RS date 2/9/04

Installed by: Larry Hinkle RS

Operation Permit by: [signature] date 10/29/04

Existing System Inspection by: date

HEALTH DEPT. COPY: WHITE OWNER COPY (FINAL): YELLOW OWNER COPY (INITIAL): PINK