IREDELL COUNTY HEALTH DEPARTMENT

Authorization to Construct 1:30

STATESVILLE 704-878-5305 MOORESVILLE 704-664-5281

IMPROVEMENT PERMIT / ~~CERTIFICATE OF COMPLETION~~ / OPERATION PERMIT / EXISTING SYSTEM INSPECTION

PROPERTY DESCRIPTION NO. 069605 DATE 9/24/97 TAX MAP NO. 4628306216 Watershed: [X] Yes [ ] No

OWNER OR CONTRACTOR Michael D. Bliss PHONE: Business 704-892-6253 Home

ADDRESS 7607 Mariner Cove Dr. Cornelius, NC. 28031

LOCATION 156 Mariner Pointe Ln.

SUBDIVISION Peninsula Shore BLOCK / SECTION III LOT 10 LOT AREA .71Ac SITE CLASS. PS DESIGN FLOW 480 L.T.A.R. e3

Septic Tank: 1000 Gallons; STB Date 3/27/98

Pump Tank: 1000 Gallons; PT Date

Pump Make: Model Serial No.

Nitrification Field: No Fields 1 Square Feet 1260~~#~~ Linear Feet 420~~#~~

No Lines 6 Trench Width 36" Max Trench Bottom Depth 36" Gravel Depth SAND.

[X] New System [ ] Repair System Type: I, II, (III) IV, V, VI

System Description: Pressure - CH PLASTIC

Repair System Description: SAME

Maintenance Agreement Required: [ ] Yes [X] No

[X] House/Mod. Home No. Bedrooms 4

[ ] Mobile Home No. Bathrooms 2.5

[ ] Business No. Employees

[ ] Other


[ ] Slab [X] Crawl Space [ ] Basement w/plumbing [ ] Basement wo/plumbing

Water Supply: [ ] Individual [X] Community [ ] Public


Comments:

Comments:

INITIAL SITE SKETCH

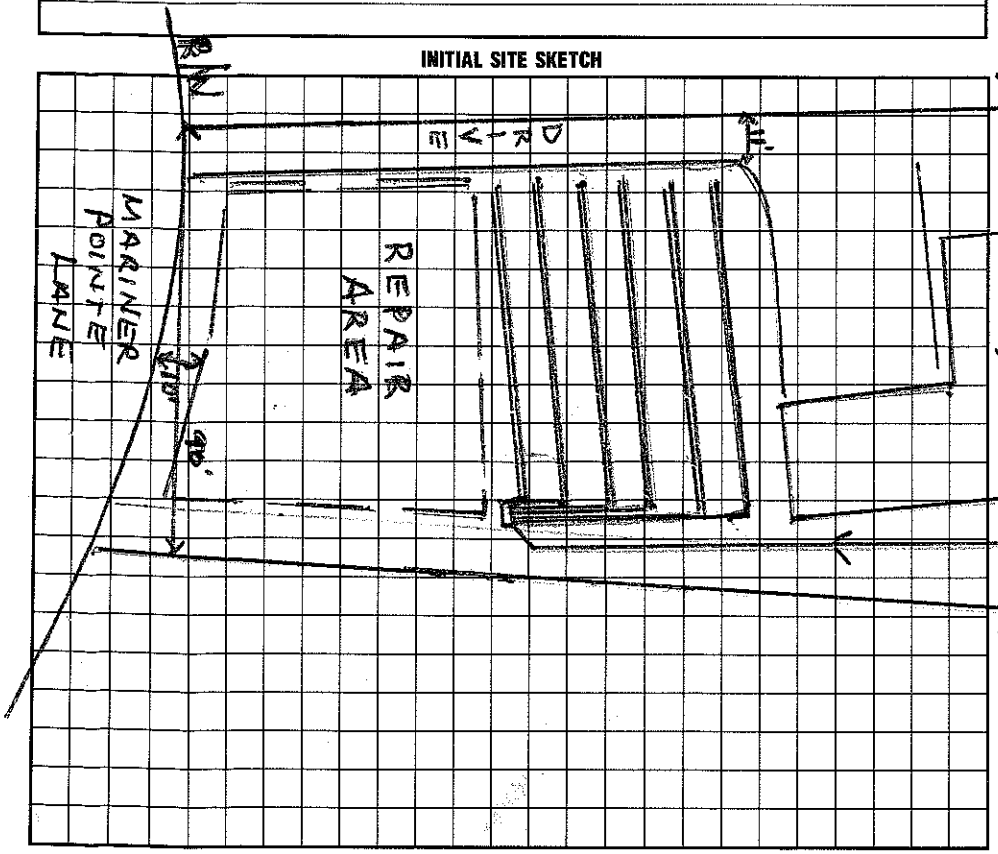

AS BUILT SKETCH

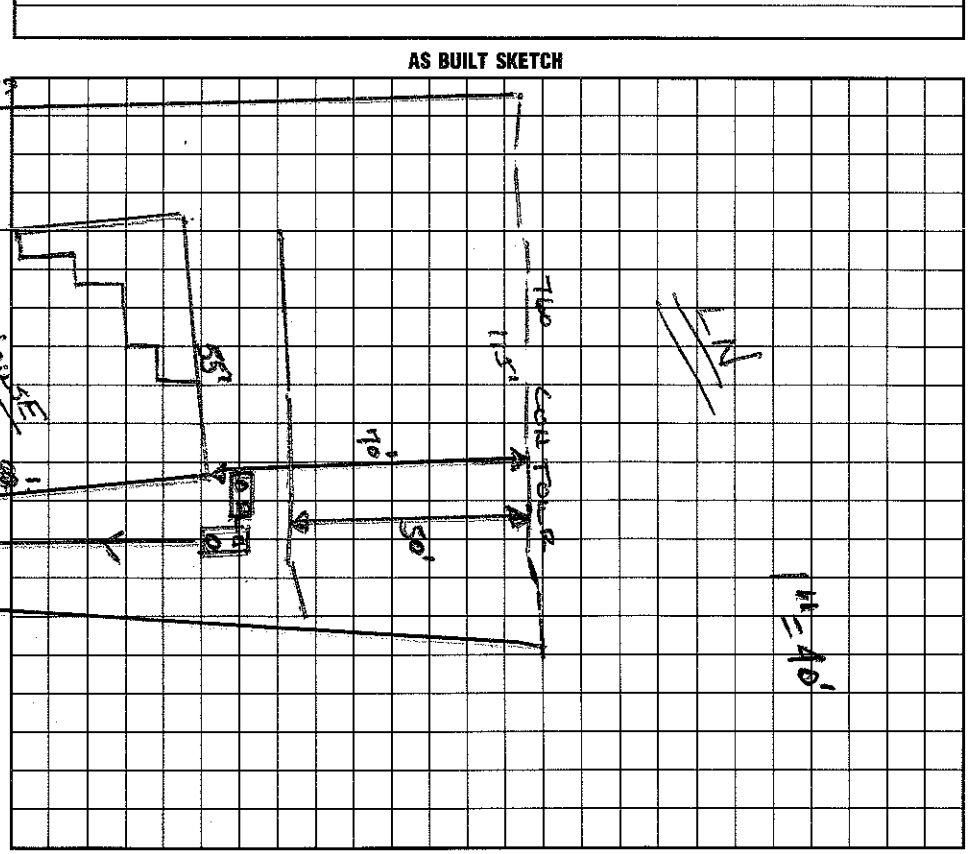

I understand that this permit can be suspended or revoked if any false information is supplied toward securing the permit/any unauthorized changes are made to the site/any unauthorized changes are made in the installation of the system. Improvement Permit is valid for 60 months from date of issuance.

Signed: X Barbara Martin

Improvement Permit by: Wesley Sparks R.S. date 9/24/97

~~Authorization~~ Existing System Inspection by: Wesley Sparks R.S. date 9/24/97

Installed by: Ammons

Certificate of Completion by: Wesley Sparks R.S. date 12/1/98

Operation Permit by: date

HEALTH DEPT. COPY: WHITE INSPECTION COPY (FINAL): GREEN OWNER COPY (FINAL): YELLOW INSPECTION COPY (INITIAL): PINK OWNER COPY (INITIAL): GOLD