4:00

IREDELL COUNTY HEALTH DEPARTMENT

STATESVILLE 704-878-5305 MOORESVILLE 704-664-5281

IMPROVEMENT PERMIT / AUTHORIZATION TO CONSTRUCT / OPERATION PERMIT / EXISTING SYSTEM INSPECTION

PERMIT# 072045 PIN# 4628 30 6315 DATE 3/18/98

OWNER OR CONTRACTOR Henry R. Miller PHONE: Business Home 478-3642

ADDRESS 7841 Seal Pointe Dr. Sherrills Ford, NC. 286730

LOCATION 150 W TL Mariner Pointe Ln to to 9th lot on (R)

SUBDIVISION Pinnacle Shore BLOCK / SECTION 3 LOT 9 LOT AREA .72 Ac SITE CLASS. PS DESIGN FLOW 360 L.T.A.R. .3

Septic Tank: 1000 Gallons; STB 794 Date 12-17-98
Pump Tank: 1000 Gallons; PT 27 Date 12-11-98
Pump Make: Goulds Model 1PLWE05111 Serial No. S01112181
Nitrification Field: No Fields 1 Square Feet 900 Linear Feet 300 *
No Lines 5" @ 5ok Trench Width 36" Max Trench Bottom Depth 36" Gravel Depth SAND

[X] New System [ ] Repair System Type: I, II, (III) IV, V, VI
System Description: PressMan → Ch. Plastic
Repair System Description: Same
Maintenance Agreement Required: [ ] Yes [X] No

[X] House/Mod. Home No. Bedrooms 3
[ ] Mobile Home No. Bathrooms 2.5
[ ] Business No. Employees
[ ] Other


[ ] Slab [X] Crawl Space [X] Basement w/plumbing [ ] Basement wo/plumbing

Water Supply: [ ] Individual [ ] Public [X] Community


Comments:/Conditions: * 25% reduction for Chambered Plastic
Gravelfield
Checked Tanks, lines & pressure 2/10/99 MD

Comments:/Conditions:

INITIAL SITE SKETCH

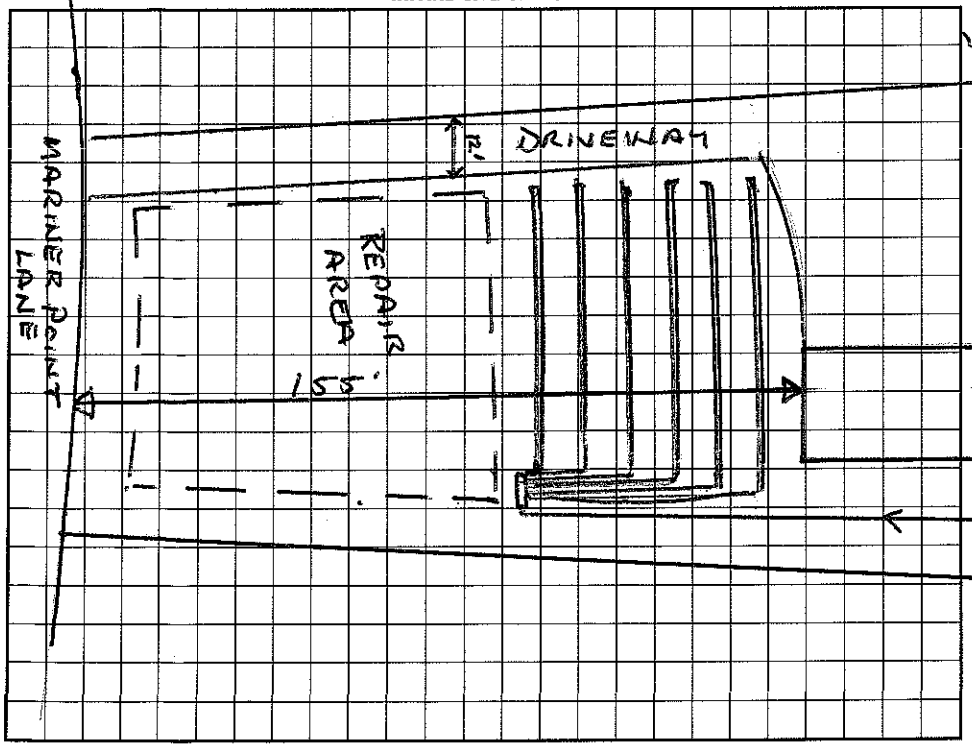

AS BUILT SKETCH

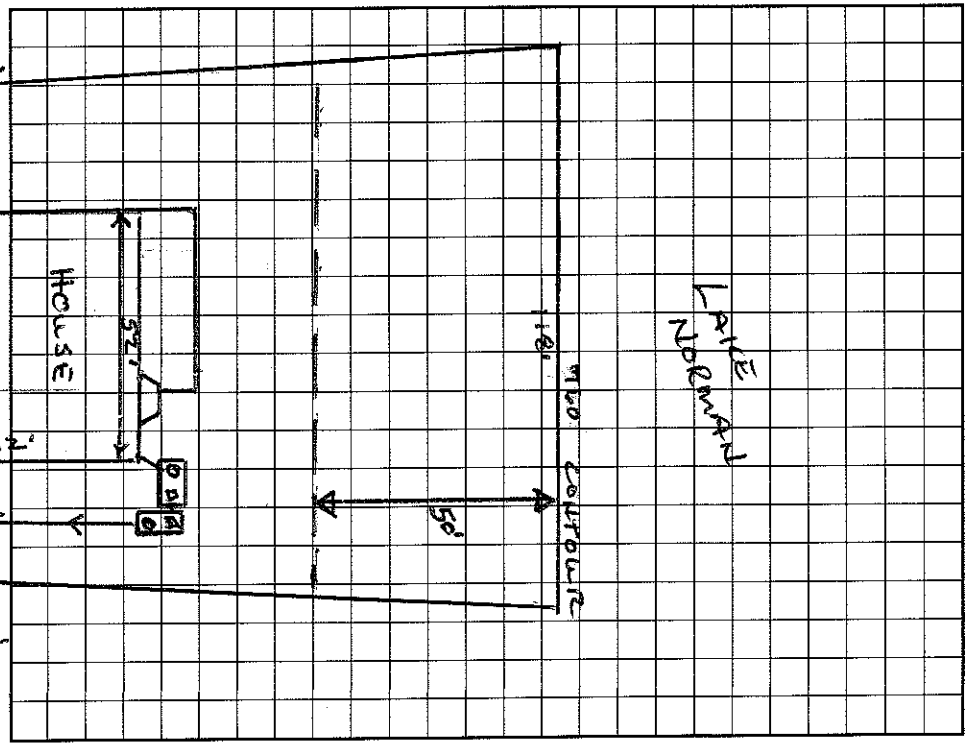

I understand that this permit can be suspended or revoked if any false information is supplied toward securing the permit/any unauthorized changes are made to the site/any unauthorized changes are made in the installation of the system. Improvement Permit with plat valid without expiration. Improvement Permit with site plan valid for sixty months. Authorization to Construct is valid for a period equal to that of Improvement Permit – not to exceed sixty months.

Signed: Donna Miller date

Improvement Permit by: Wesley Sparks R.S. date 3/18/98

Authorization to Construct by: Wesley Sparks R.S. date 3/18/98

Installed by: E.J. Ervin

Operation Permit by: Wesley Sparks R.S. date 3/30/99

Existing System Inspection by: date

HEALTH DEPT. COPY: WHITE INSPECTION COPY (FINAL): GREEN OWNER COPY (FINAL): YELLOW INSPECTION COPY (INITIAL): PINK OWNER COPY (INITIAL): GOLD