# IREDELL COUNTY HEALTH DEPARTMENT

STATESVILLE 704-878-5305 MOORESVILLE 704-664-5281

## IMPROVEMENT PERMIT / AUTHORIZATION TO CONSTRUCT / OPERATION PERMIT / EXISTING SYSTEM INSPECTION

PERMIT# 101520 PIN# 4628-30-6445 DATE 7/30/01

OWNER OR CONTRACTOR George Church (Butch Miller) PHONE: Business 704-664-2845 Home

ADDRESS 109 Harbor Cove Ln. Mooresville NC 28117

LOCATION 150 W to Mariner Pointe Dr. to 8th lot on (R) 148 Mariner Pointe Ln

SUBDIVISION Peninsula Shores BLOCK / SECTION 3 LOT 8 LOT AREA .9 Ac SITE CLASS. PS DESIGN FLOW 360 L.T.A.R. .3

Septic Tank: 1000 Gallons; STB 160 Date 9/30/01
Pump Tank: 1000 Gallons; PT 319 Date 7/01/01
Pump Make: Myers Model SHEF 100 A2 Serial No. 9/01 360
Nitrification Field: No Fields 1 Square Feet 1080* Linear Feet 360*
No Lines ~~5 @ 120'~~ 6 @ 60' Trench Width 3' Max Trench Bottom Depth 3' Gravel Depth No

☒ New System ☐ Repair System Type: I, II, (III) IV, V, VI
System Description: Pres Man. -CH.PLAS on E2Flex
Repair System Description: None
Maintenance Agreement Required: ☐ Yes ☒ No

☒ House/Mod. Home No. Bedrooms 3
☐ Mobile Home No. Bathrooms 2.5
☐ Business No. Employees
☐ Other


☐ Slab ☐ Crawl Space ☒ Basement w/plumbing ☐ Basement wo/plumbing

Water Supply: ☐ Individual ☐ Public ☒ Community


Comments/Conditions: *259e Reduction System

Comments/Conditions:

INITIAL SITE SKETCH

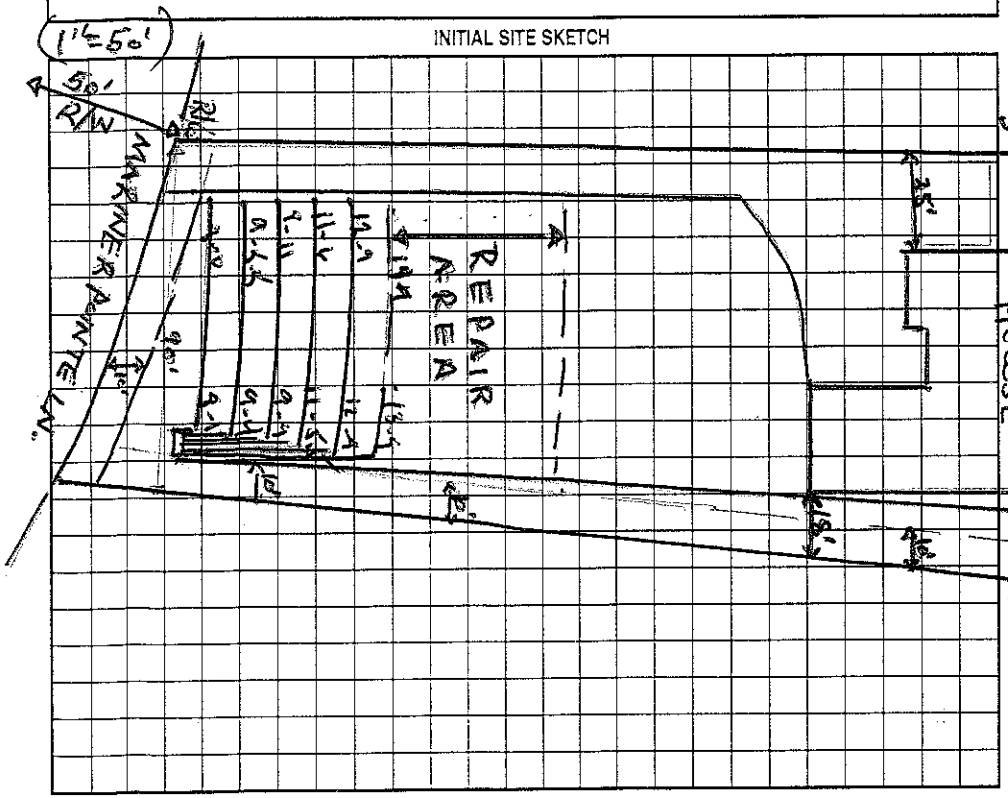


AS BUILT SKETCH

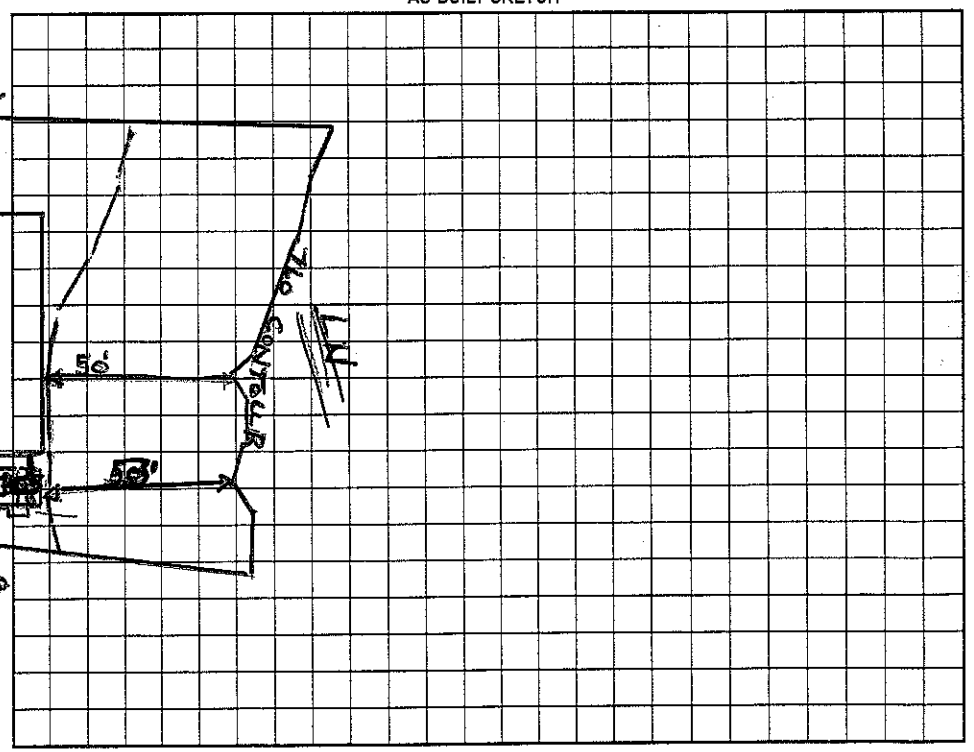


Permit can be suspended or revoked if any false information is supplied toward securing the permit/any unauthorized changes are made to the site/any unauthorized changes are made in the installation of the system. Improvement Permit with plat valid without expiration. Improvement Permit with site plan valid for sixty months. Authorization to Construct is valid for a period equal to that of Improvement Permit – not to exceed sixty months.

Signed: *George Church date

Improvement Permit by: Wesley Sparks RS date 7/30/01

Authorization to Construct by: Wesley Sparks RS. date 7/30/01

Installed by: Macleod Const. Co.

Operation Permit by: Wesley Sparks RS. date 3/19/02

Existing System Inspection by: date

HEALTH DEPT. COPY: WHITE OWNER COPY (FINAL): YELLOW OWNER COPY (INITIAL): PINK