(4,500)

IREDELL COUNTY HEALTH DEPARTMENT

STATESVILLE 704-878-5305 MOORESVILLE 704-664-5281

IMPROVEMENT PERMIT / AUTHORIZATION TO CONSTRUCT / OPERATION PERMIT / EXISTING SYSTEM INSPECTION

PERMIT# 066896 PIN# 4628306566 DATE 1/22/98

OWNER OR CONTRACTOR KENNETH BEALER PHONE: Business 662-1400 Home

ADDRESS PO Box 1370 CORNELIUS NC 28031

LOCATION 150 W - TL MARINER PT LN. - 7TH LOT ON RT

SUBDIVISION PINNACLE SHORES BLOCK / SECTION III LOT 7 LOT AREA .9AC SITE CLASS. PS DESIGN FLOW 480 GPD L.T.A.R. .30 PD/FT²

Septic Tank: 1000 Gallons; STB 704 Date 11/6/97
Pump Tank: 1000 Gallons; PT 571 Date 12/22/97
Pump Make: SHEF50A1 Model HYDROMATIC Serial No. 1-98
Nitrification Field: No Fields 1 Square Feet 533 Linear Feet 270
No Lines 6@45' Trench Width 34" Max Trench Bottom Depth 36" Gravel Depth N/A

☑ New System ☐ Repair System Type: I, II, III, IV, V, VI
System Description: PUMP PANEL
Repair System Description: SAME
Maintenance Agreement Required: ☐ Yes ☑ No

☑ House/Mod. Home No. Bedrooms 4
☐ Mobile Home No. Bathrooms 4
☐ Business No. Employees
☐ Other


☐ Slab ☐ Crawl Space ☑ Basement w/plumbing ☐ Basement wo/plumbing

Water Supply: ☐ Individual ☐ Public ☑ Community


Comments:/Conditions:
* REVISED *

Comments:/Conditions:
LINES - TANKS checked - NO PRESSURE 2/2/97
7.5" diameter = 150 GAL/DOSE

INITIAL SITE SKETCH

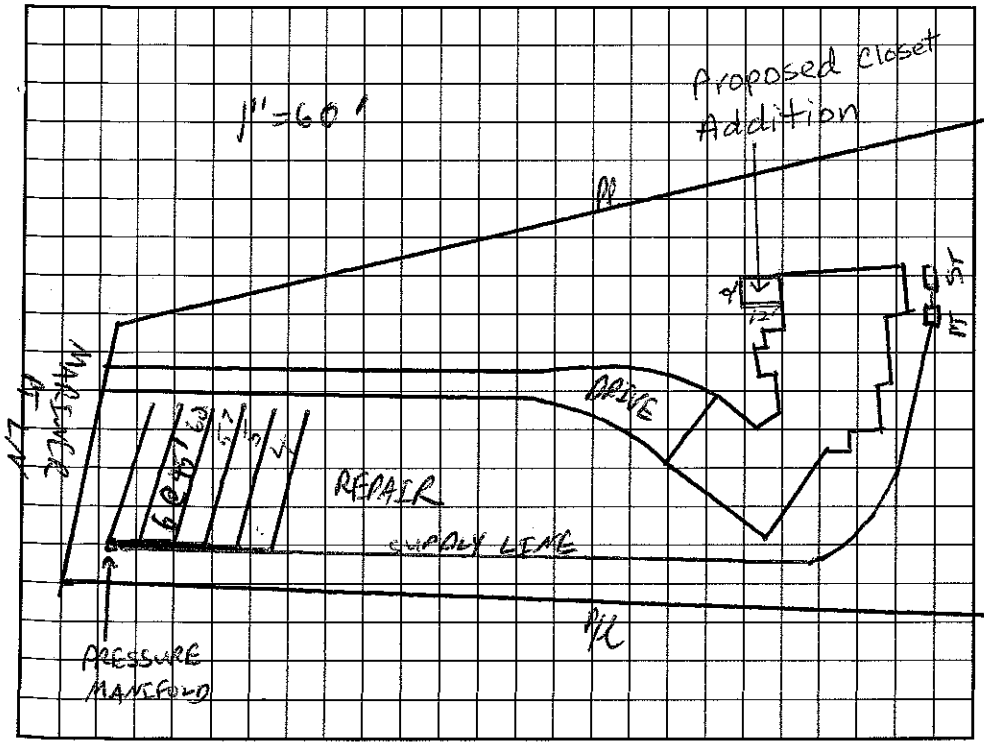

AS BUILT SKETCH

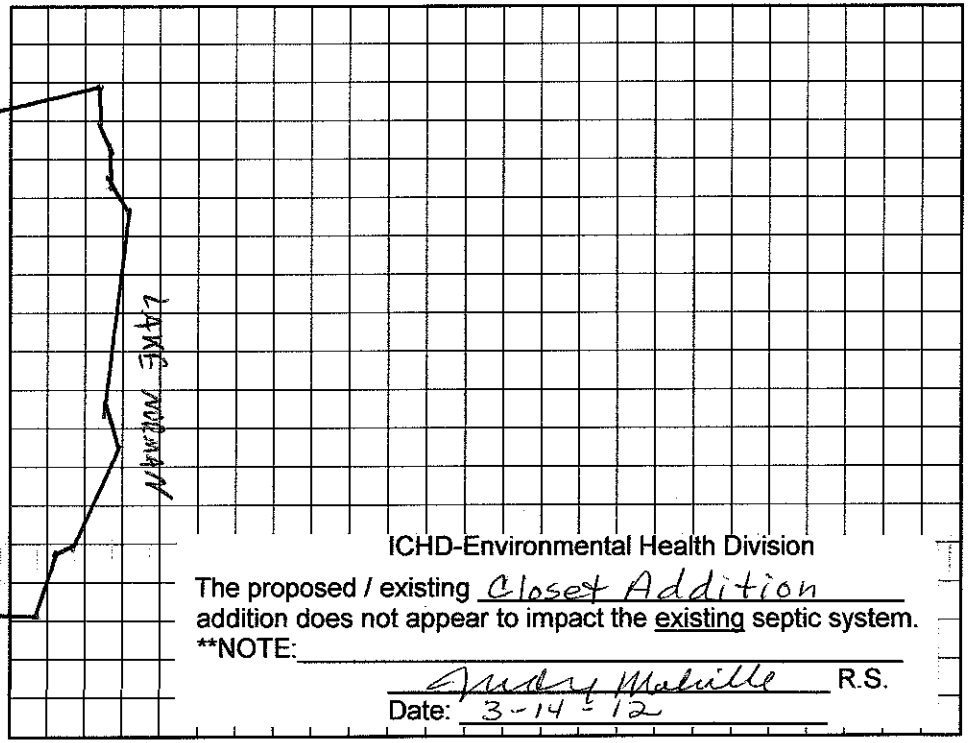

ICHD-Environmental Health Division
The proposed / existing Closet Addition addition does not appear to impact the existing septic system.
**NOTE:
Andrew Melville R.S.
Date: 3-14-12

I understand that this permit can be suspended or revoked if any false information is supplied toward securing the permit/any unauthorized changes are made to the site/any unauthorized changes are made in the installation of the system. Improvement Permit with plat valid without expiration. Improvement Permit with site plan valid for sixty months. Authorization to Construct is valid for a period equal to that of Improvement Permit – not to exceed sixty months.

Signed: Barbara Martin date
Improvement Permit by: [signature] date 1/22/98
Authorization to Construct by: [signature] date 1/22/98

Installed by: TIM AMMONS
Operation Permit by: Wesley Hughes RS date 2/19/98
Existing System Inspection by: Wesley Hughes RS date 2/19/98

HEALTH DEPT. COPY: WHITE INSPECTION COPY (FINAL): GREEN OWNER COPY (FINAL): YELLOW INSPECTION COPY (INITIAL): PINK OWNER COPY (INITIAL): GOLD