IREDELL COUNTY HEALTH DEPARTMENT

STATESVILLE 704-878-5305 MOORESVILLE 704-664-5281

IMPROVEMENT PERMIT / AUTHORIZATION TO CONSTRUCT / OPERATION PERMIT / EXISTING SYSTEM INSPECTION

PERMIT# 072929 PIN# 3367515628 DATE April 20, '98

OWNER OR CONTRACTOR Jon D. Missert PHONE: Business 416 28-30-76116 Home

ADDRESS 5923 Carriage Rd. Charlotte

LOCATION 150 W! TL Mariner Pt Lane on Right

SUBDIVISION Pinnacle Shores BLOCK / SECTION III LOT 6 LOT AREA .8ac SITE CLASS. RS DESIGN FLOW 360gpd L.T.A.R. .3

Septic Tank: 1000 Gallons; STB 760 Date 7-24-98
Pump Tank: Gallons; PT Date
Pump Make: Model Serial No.
Nitrification Field: No Fields 2 Square Feet 1200 Linear Feet 400
No Lines 3+3 Trench Width 36" Max Trench Bottom Depth 36" Gravel Depth 12"

☑ New System ☐ Repair System Type: I II III IV V VI DRW
System Description: gravity conventional and EZ Lay
Repair System Description: pumped conventional
Maintenance Agreement Required: ☐ Yes ☑ No

☑ House/Mod. Home No. Bedrooms 3
☐ Mobile Home No. Bathrooms 2½
☐ Business No. Employees
☐ Other
☐ Slab ☐ Crawl Space ☑ Basement w/plumbing ☐ Basement wo/plumbing


Water Supply: ☐ Individual ☑ Public ☑ Community

Comments:/Conditions: 200' on each subfield

Comments:/Conditions: OKED by builder to change to EZ Lay due to depth and amount of fill soil next to house. 9/25 completed on site. 5 lines approx 160' installed using D-Box/Drop Box and serial distribution

1"=100'

INITIAL SITE SKETCH

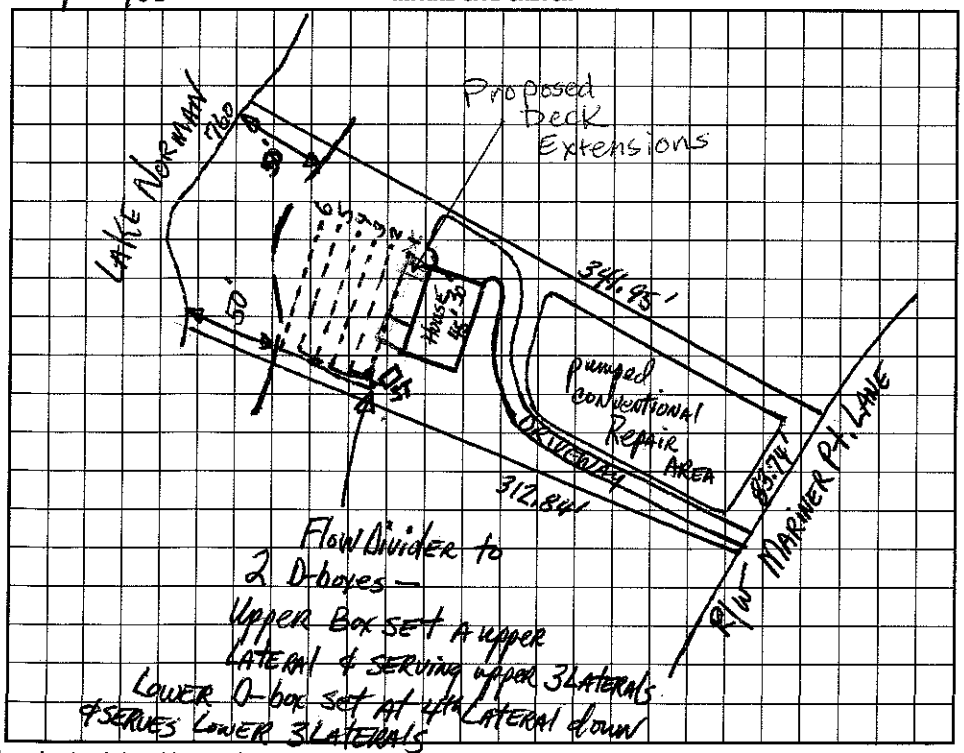

AS BUILT SKETCH

Installed in area substantially as shown except on 5 lines using EZ Lay and serial distribution

The proposed / existing Deck Extension addition does not appear to impact the existing septic system.
**NOTE: Deck foundation shall be min. 5' from septic

Judy Melnik R.S.
Date: March 21, 2013
ICHD-Environmental Health Division

I understand that this permit can be suspended or revoked if any false information is supplied toward securing the permit/any unauthorized changes are made to the site/any unauthorized changes are made in the installation of the system. Improvement Permit with plat valid without expiration. Improvement Permit with site plan valid for sixty months. Authorization to Construct is valid for a period equal to that of Improvement Permit – not to exceed sixty months.

Signed: Don Shelton date 4-21-98
Improvement Permit by: D.R. Hansen, RS date 4-20-98
Authorization to Construct by: D.R. Hansen, RS date 4-20-98

Installed by: Randy Mallory
Operation Permit by: D.R. Hansen, RS date 10-23-98
Existing System Inspection by: date

HEALTH DEPT. COPY: WHITE INSPECTION COPY (FINAL): GREEN OWNER COPY (FINAL): YELLOW INSPECTION COPY (INITIAL): PINK OWNER COPY (INITIAL): GOLD