IREDELL COUNTY HEALTH DEPARTMENT

STATESVILLE 704-878-5305 900.00 MOORESVILLE 704-664-5281

IMPROVEMENT PERMIT / AUTHORIZATION TO CONSTRUCT / OPERATION PERMIT / EXISTING SYSTEM INSPECTION

PERMIT# 023871 PIN# 4628-30-9141 DATE 5/7/07

OWNER OR APPLICANT NICK LEONARD PHONE: Business ______ Home 704-987-6516

ADDRESS 165 MARINER POINT MOORESVILLE, NC. 28117

LOCATION 150 W TL MARINER PT, LAST ON (L) B4 CULDESAC

SUBDIVISION PINNACLE SHORES BLOCK / SECTION 05 LOT 18 LOT AREA ~.8 AC SITE CLASS. PS DESIGN FLOW 480 L.T.A.R. .3

Septic Tank: 1000 Gallons; STB ______ Date ______

Pump Tank: 1000 Gallons; PT ______ Date ______

Pump Make: ______ Model ______ Serial No. ______

Nitrification Field: No Fields 1 Square Feet 870 Linear Feet 290

No Lines 5 Trench Width 3' Max Trench Bottom Depth 3'

☒ New System ☐ Repair ☐ Expansion System Type: I II III (IV) V VI

System Description: LP-PPBPS

Repair System Description: SAME TYPE

Maintenance Agreement Required: ☒ Yes ☐ No

Gravel Depth N/A ☐ Gravity ☒ Pressure ☐ Slab ☐ Crawl Space ☒ Basement w/plumbing ☐ Basement wo/plumbing

☐ House/Mod. Home ☐ Mobile Home ☐ Business ☐ Other


No. Bedrooms 4 No. Persons ____ No. Employees ____

Water Supply: ☐ Individual ☐ Public ☒ Community


Comments:/Conditions:

Comments:/Conditions:

INITIAL SITE SKETCH (1" = 50')

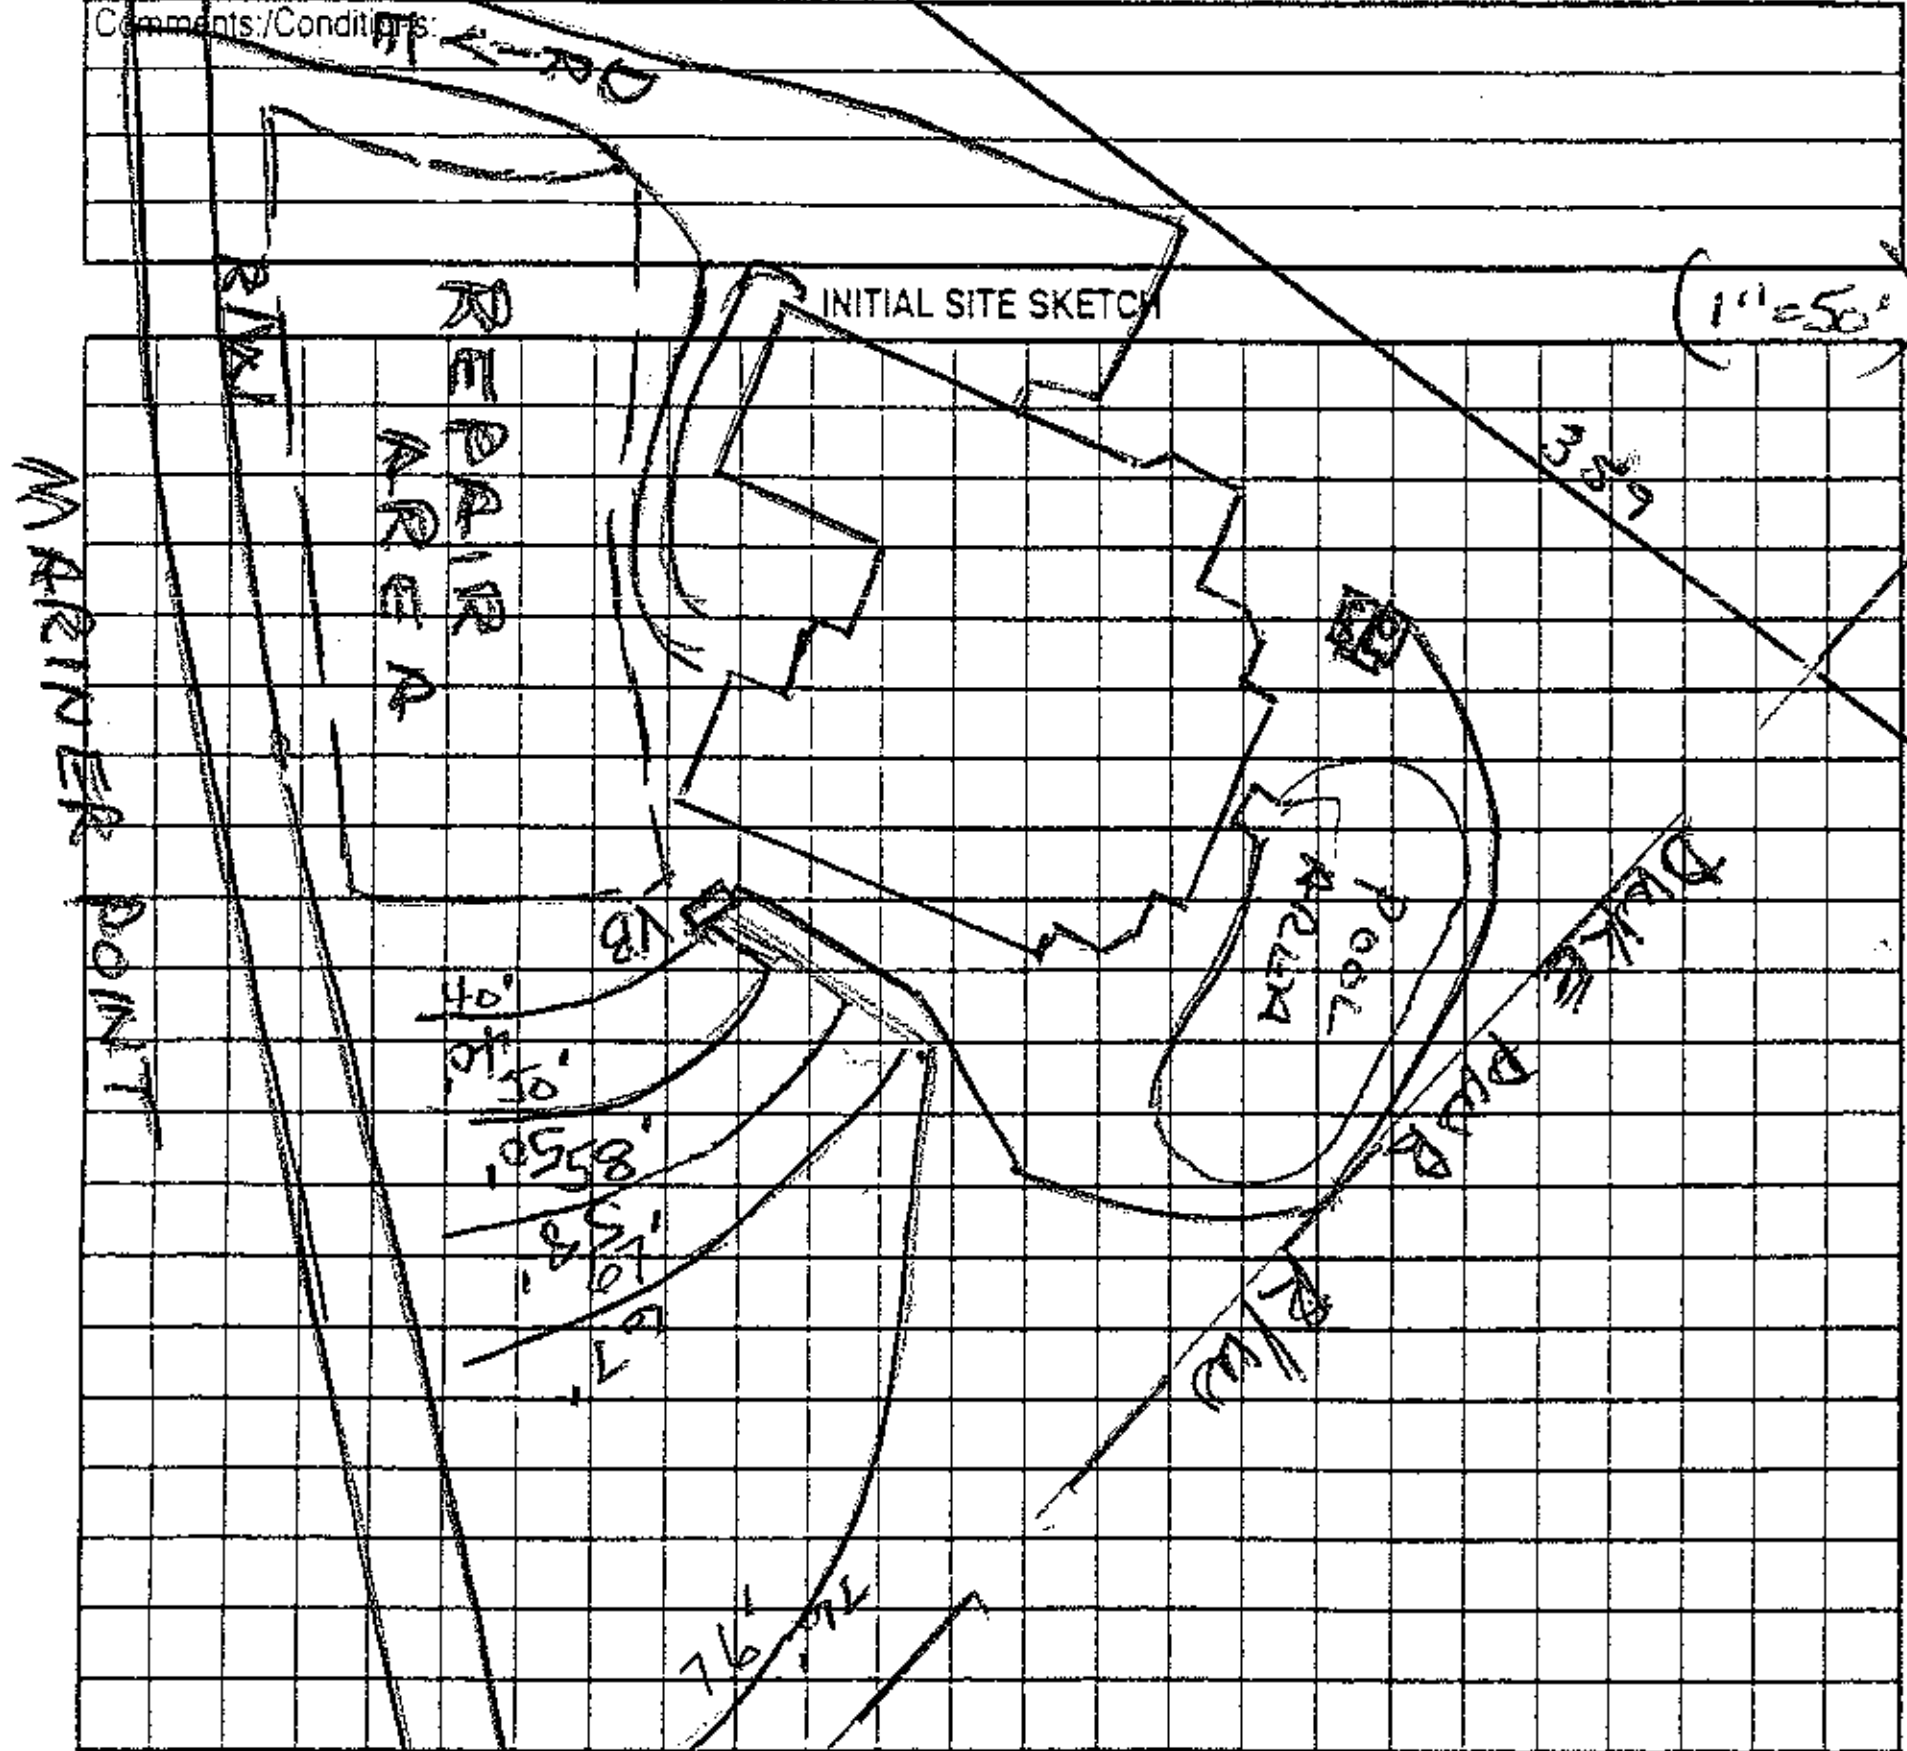

AS BUILT SKETCH

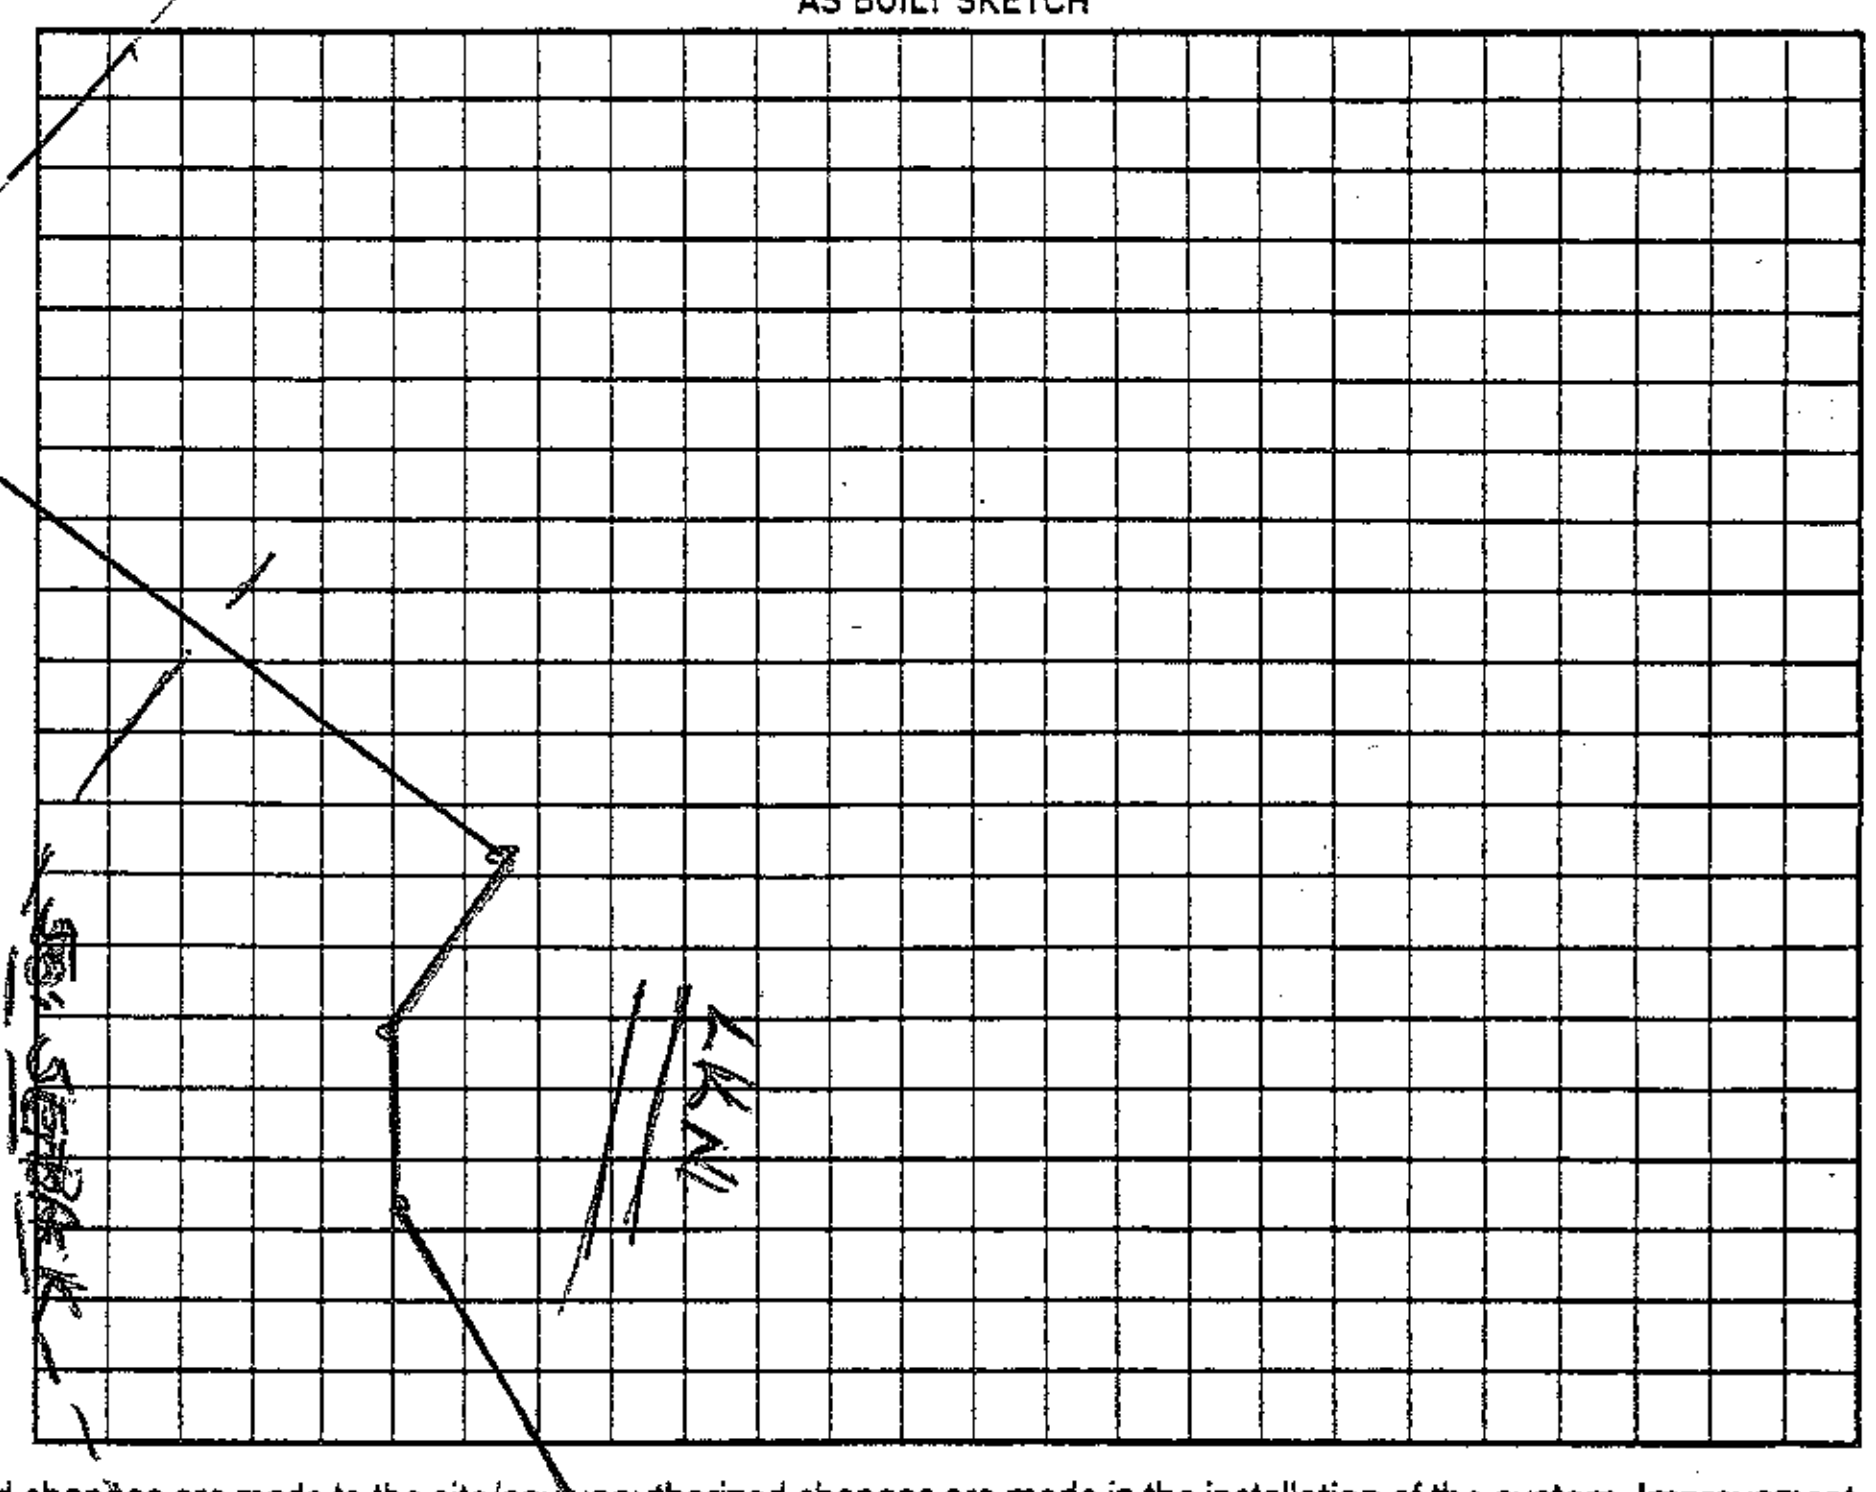

Permit can be suspended or revoked if any false information is supplied toward securing the permit/any unauthorized changes are made to the site/any unauthorized changes are made in the installation of the system. Improvement Permit with plat valid without expiration ☐ Improvement Permit with site plan valid for sixty months ☐ Authorization to Construct is valid for a period equal to that of Improvement Permit – not to exceed sixty months.

Signed: X [signature] date 5/9/07

Installed by: R+H Elec.

Improvement Permit by: Wesley Sparks R.S. date 5/7/07

Operation Permit by: Wesley Sparks R.S. date 6/22/07

Authorization to Construct by: Wesley Sparks R.S. date 5/7/07

Existing System Inspection by: ______ date ______

HEALTH DEPT. COPY: WHITE OWNER COPY (FINAL): YELLOW OWNER COPY (INITIAL): PINK