IREDELL COUNTY HEALTH DEPARTMENT

STATESVILLE 704-878-5305 MOORESVILLE 704-664-5281

IMPROVEMENT PERMIT / AUTHORIZATION TO CONSTRUCT / OPERATION PERMIT / EXISTING SYSTEM INSPECTION

PERMIT# 077067 PIN# 4628401503 DATE 2/15/99

OWNER OR CONTRACTOR CRESCENT RESOURCES PHONE: Business Home

ADDRESS PO BOX 1003 CHARLOTTE NC 28210

LOCATION 150 W - TL MARINER PT - ON LT

SUBDIVISION PINNACLE SHORES BLOCK / SECTION 3 LOT 22 LOT AREA 1.07AC SITE CLASS. PS DESIGN FLOW 480GPD L.T.A.R. .3002/LF

Septic Tank: 1000 Gallons; STB 825 Date 2/4/99
Pump Tank: 1000 Gallons; PT 302 Date 3/19/00
Pump Make: ZOELLER Model Serial No.
Nitrification Field: No Fields 1 Square Feet 1650 Linear Feet 560
No Lines 7@50' Trench Width 36" Max Trench Bottom Depth 36" Gravel Depth

☒ New System ☐ Repair System Type: I, II, III, IV, V, VI
System Description: PUMP CONVENTIONAL
Repair System Description: SAME
Maintenance Agreement Required: ☐ Yes ☒ No


☐ House/Mod. Home No. Bedrooms 4
☐ Mobile Home No. Bathrooms 4
☐ Business No. Employees
☐ Other
☐ Slab ☐ Crawl Space ☒ Basement w/plumbing ☐ Basement wo/plumbing

Water Supply:
☐ Individual
☐ Public
☒ Community


Comments:/Conditions:

Comments:/Conditions:

INITIAL SITE SKETCH 1"=50'

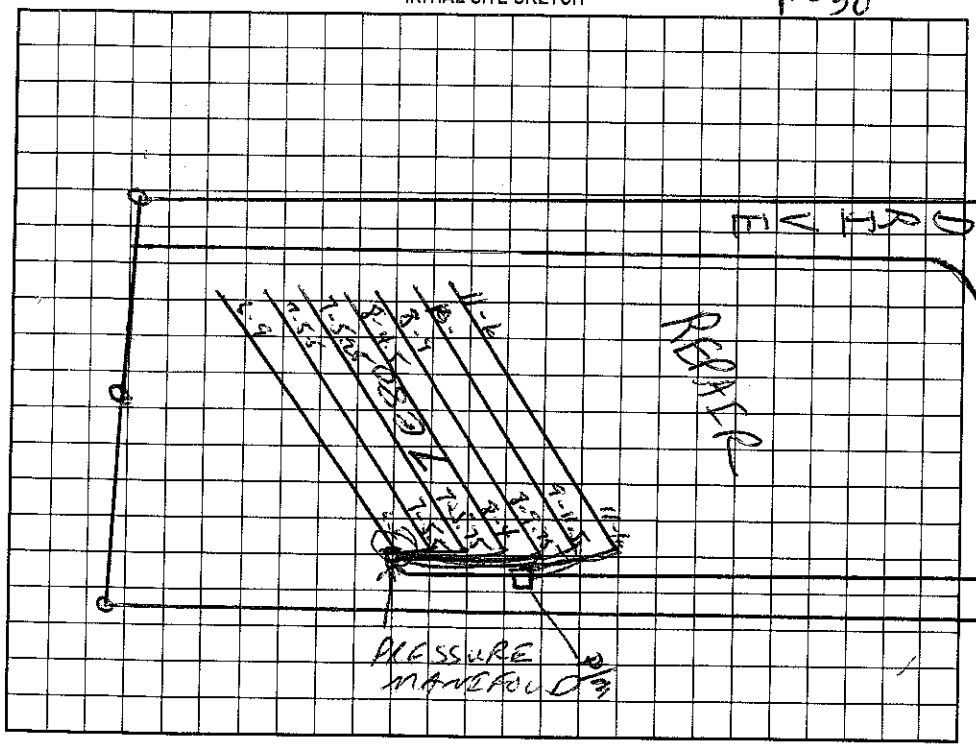

AS BUILT SKETCH

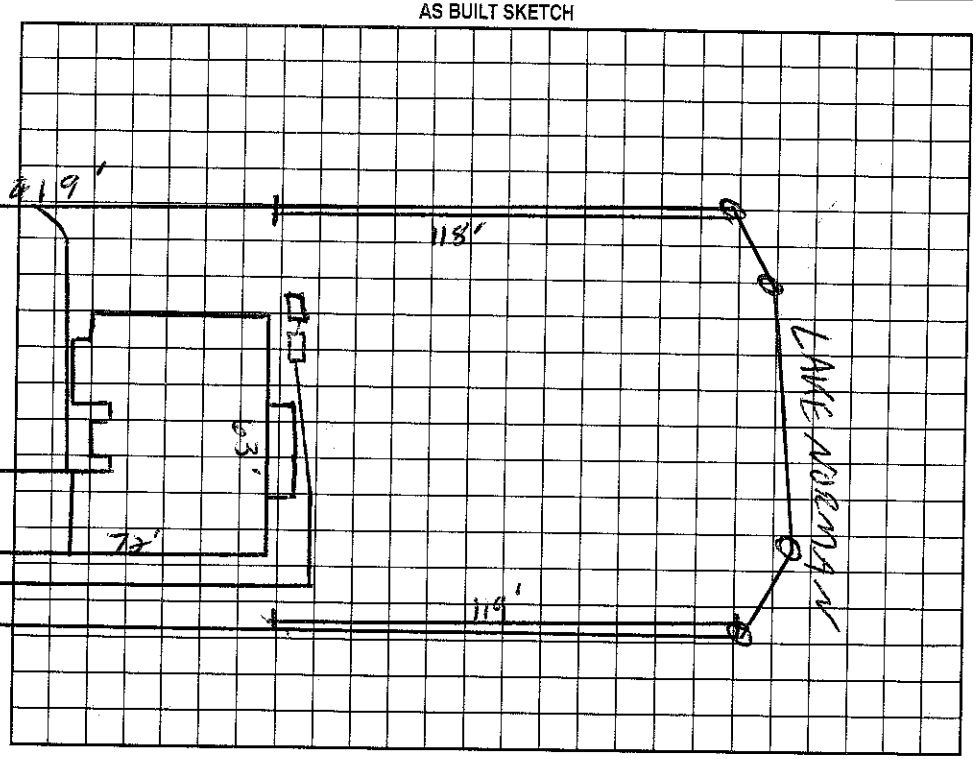

Permit can be suspended or revoked if any false information is supplied toward securing the permit/any unauthorized changes are made to the site/any unauthorized changes are made in the installation of the system. Improvement Permit with plat valid without expiration. Improvement Permit with site plan valid for sixty months. Authorization to Construct is valid for a period equal to that of Improvement Permit – not to exceed sixty months.

Signed: Kim Green date

Improvement Permit by: C. Hyatt Jr. RS date 2/15/99

Authorization to Construct by: C. Hyatt Jr. RS date 2/15/99

Installed by: Myers Septic Tank - Rowan Co.

Operation Permit by: Maria H. Dotson date 6/22/00

Existing System Inspection by: date

HEALTH DEPT. COPY: WHITE OWNER COPY (FINAL): YELLOW OWNER COPY (INITIAL): PINK