IREDELL COUNTY HEALTH DEPARTMENT

STATESVILLE 704-878-5305 50.00 Paid MOORESVILLE 704-664-5281 2100

IMPROVEMENT PERMIT / AUTHORIZATION TO CONSTRUCT / OPERATION PERMIT / EXISTING SYSTEM INSPECTION

PERMIT# 075664 PIN# ~~4726 88 9970 (PT)~~ 4628-40-7101 DATE 6/14/01

OWNER OR CONTRACTOR Fisher Beasley PHONE: Business Home 786-3631

ADDRESS 1023 Litchfield Place Concord NC. 28027

LOCATION 150W TL Highlands Drive on (R) before end.

SUBDIVISION Pinnacle Shores BLOCK / SECTION 4 LOT 23,23A LOT AREA .764 AC SITE CLASS PS DESIGN FLOW 360 L.T.A.R. .25

Septic Tank: 1000 Gallons; STB 794 Date 4-11-01
Pump Tank: 1000 Gallons; PT 283 Date 4-30-01
Pump Make: Gould Model WEO 712H Serial No. B0010532
Nitrification Field: No Fields 1 Square Feet 780 Lineal Feet ~~240~~ 260
No Lines 4 Trench Width 3' Max Trench Bottom Depth 3' Gravel Depth SAND.

[X] New System [ ] Repair System Type: I, II, III, (IV), V, VI
System Description: LP PANEL BLOCK
Repair System Description: LP PANEL BLOCK ON 23A
Maintenance Agreement Required: [X] Yes [ ] No


[X] House/Mod. Home No. Bedrooms 3
[ ] Mobile Home No. Bathrooms 3.5
[ ] Business No. Employees
[ ] Other
[ ] Slab [ ] Crawl Space [X] Basement w/plumbing [ ] Basement wo/plumbing

Water Supply: [ ] Individual [ ] Public [X] Community


Comments:/Conditions:

Comments:/Conditions: Tanks checked 6/15/2001

(1" = 50') INITIAL SITE SKETCH

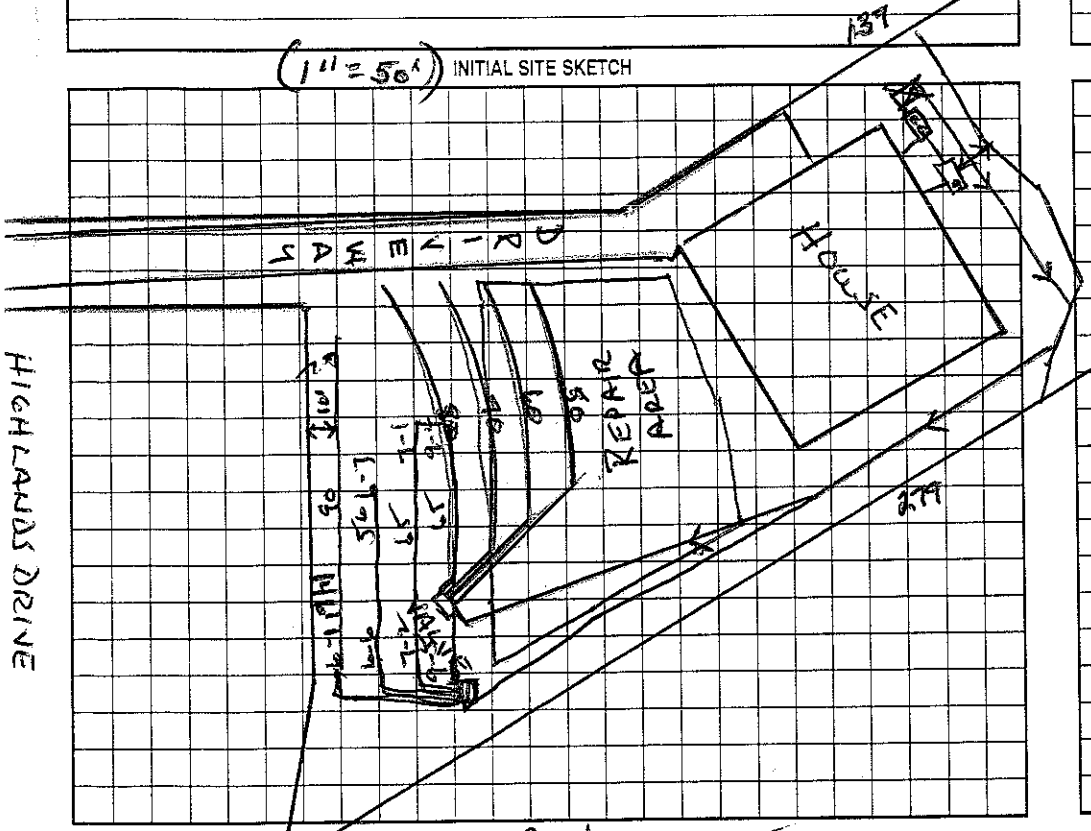

AS BUILT SKETCH

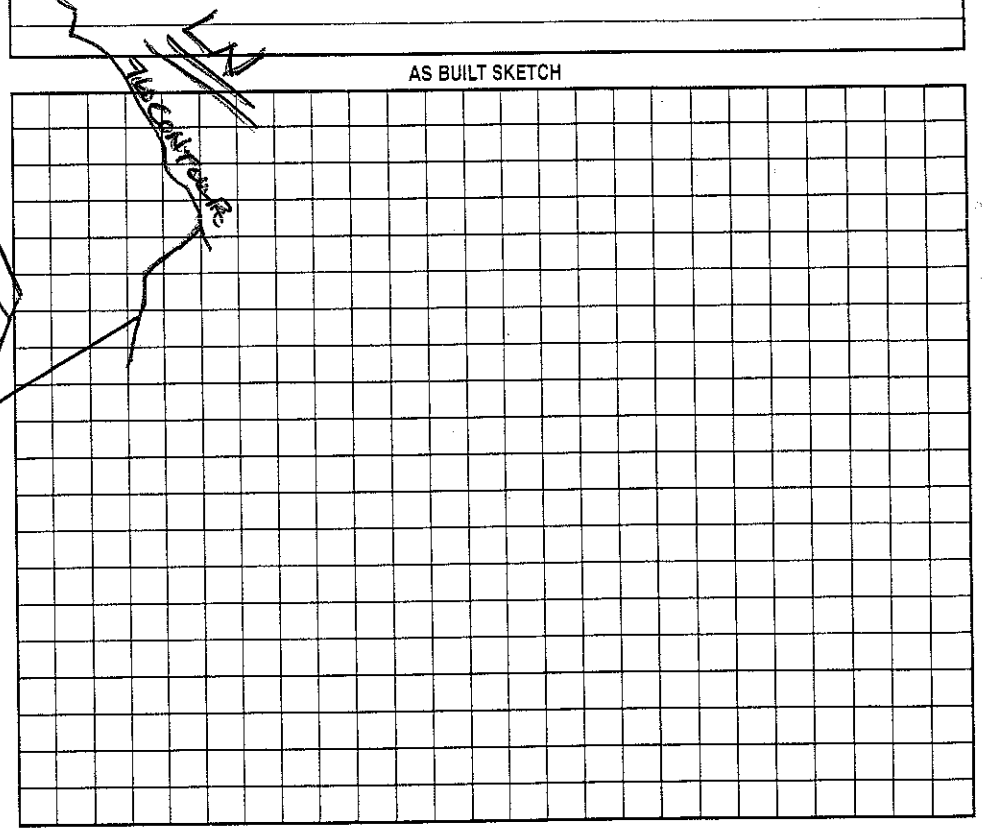

Permit can be suspended or revoked if any false information is supplied toward securing the permit/any unauthorized changes are made to the site/any unauthorized changes are made in the installation of the system. Improvement Permit with plat valid without expiration. Improvement Permit with site plan valid for sixty months. Authorization to Construct is valid for a period equal to that of Improvement Permit – not to exceed sixty months.

Signed: X [signature] date 6/15/01 Installed by: F.J. Ervin

Improvement Permit by: Wesley Sparks RS date 6/14/01 Operation Permit by: [signature] RS date 7/25/01

Authorization to Construct by: Wesley Sparks RS date 6/14/01 Existing System Inspection by: date

HEALTH DEPT. COPY: WHITE OWNER COPY (FINAL): YELLOW OWNER COPY (INITIAL): PINK