IREDELL COUNTY HEALTH DEPARTMENT

STATESVILLE 704-878-5305 MOORESVILLE 704-664-5281

IMPROVEMENT PERMIT / AUTHORIZATION TO CONSTRUCT / OPERATION PERMIT / EXISTING SYSTEM INSPECTION

PERMIT# 075663 PIN# ~~4726 88 9970~~ 4628-40-7222 DATE 6/11/01

OWNER OR CONTRACTOR Dan Bullodge PHONE: Business 660-5705 Home

ADDRESS PO Box 230 Terrell, NC. 28682

LOCATION 150 W TL Highland Dr. TR Old Camp Lane

SUBDIVISION Pinnacle Shores BLOCK / SECTION 4 LOT 21-21A LOT AREA .72 AC SITE CLASS. PS DESIGN FLOW 480 L.T.A.R. .3

Septic Tank: 1000 Gallons; STB 312 Date 5/6/01
Pump Tank: 1000 Gallons; PT 283 Date 5/6/01
Pump Make: MYERS Model ME50S-1 Serial No.
Nitrification Field: No Fields 1 Square Feet 670 Linear Feet 335
No Lines ~~5~~ 6 Trench Width (2) 3' Max Trench Bottom Depth 36+ Gravel Depth No

☒ New System ☐ Repair System Type: I, II, III, (IV) V, VI
System Description: LPP - 16" PPBRS
Repair System Description: SAME ON 21A
Maintenance Agreement Required: ☒ Yes ☐ No
☐ Slab ☐ Crawl Space ☒ Basement w/plumbing ☐ Basement wo/plumbing

☒ House/Mod. Home No. Bedrooms 4
☐ Mobile Home No. Bathrooms 4
☐ Business No. Employees
☐ Other


Water Supply:
☐ Individual
☐ Public
☒ Community

Comments:/Conditions: Type 4 System
Maintenance Contract Required


Comments:/Conditions: 77

(1" = 50')

INITIAL SITE SKETCH

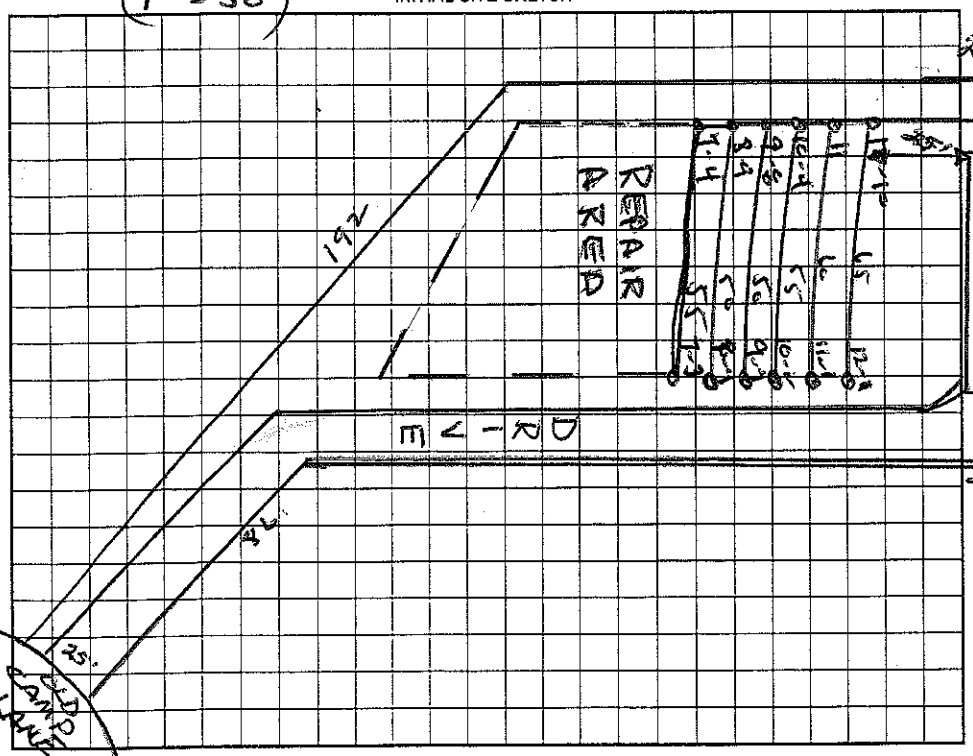

AS BUILT SKETCH

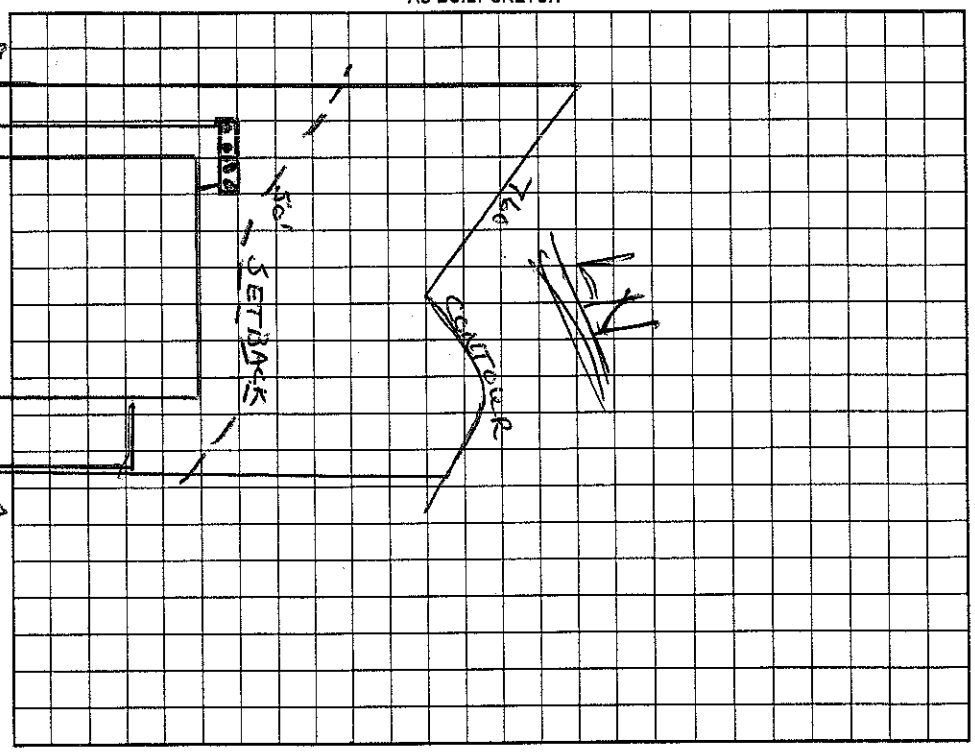

Permit can be suspended or revoked if any false information is supplied toward securing the permit/any unauthorized changes are made to the site/any unauthorized changes are made in the installation of the system. Improvement Permit with plat valid without expiration. Improvement Permit with site plan valid for sixty months. Authorization to Construct is valid for a period equal to that of Improvement Permit – not to exceed sixty months.

Signed: X Sharon Dellodge date 6/12/01
Improvement Permit by: Wesley Sparks R.S. date 6/11/01
Authorization to Construct by: Wesley Sparks R.S. date 6/11/01

Installed by: Buddy Chaney
Operation Permit by: [signature] date 9/11/01
Existing System Inspection by: date

HEALTH DEPT. COPY: WHITE OWNER COPY (FINAL): YELLOW OWNER COPY (INITIAL): PINK