3:30

IREDELL COUNTY HEALTH DEPARTMENT

STATESVILLE 704-878-5305 MOORESVILLE 704-664-5281

IMPROVEMENT PERMIT / AUTHORIZATION TO CONSTRUCT / OPERATION PERMIT / EXISTING SYSTEM INSPECTION

PERMIT# 139510 PIN# 4628 40 7435 DATE 2/6/07

OWNER OR APPLICANT Patrick Andries PHONE: Business 980-722-3345 Home

ADDRESS

LOCATION 150 W TL High Hill Dr. TR Old Camp Ground Rd. extend

SUBDIVISION Pinnacle Shores BLOCK / SECTION 4 LOT 19-RA LOT AREA .878 SITE CLASS. PS DESIGN FLOW 600 L.T.A.R. .25

Septic Tank: 1500 Gallons: STB 338 Date 6-3-08
Pump Tank: 1500 Gallons: PT 477 Date 5-18-08
Pump Make: Goulds Model 4012H4 VHS Serial No.
Nitrification Field: No Fields ___ Square Feet 180 Linear Feet 600
No Lines 8-9 Trench Width 3 Max Trench Bottom Depth 3

☒ New System ☐ Repair ☐ Expansion System Type: I II (III) IV V VI
System Description: PM — 2507c Reduction
Repair System Description: Same Type on 19A
Maintenance Agreement Required: ☐ Yes ☒ No

☒ House/Mod. Home ☐ Mobile Home ☐ Business ☐ Other
No. Bedrooms 5 No. Persons ___ No. Employees ___

Water Supply: ☐ Individual ☐ Public ☒ Community


Gravel Depth No ☐ Gravity ☐ Pressure ☐ Slab ☐ Crawl Space ☒ Basement w/plumbing ☐ Basement wo/plumbing

Comments/Conditions: 7/11/05 Okay to do in 9 lines ~ 67Ft eaj

Comments/Conditions: 7-22-08 Checked upper 3 drain lines BA


(1"=50')

INITIAL SITE SKETCH

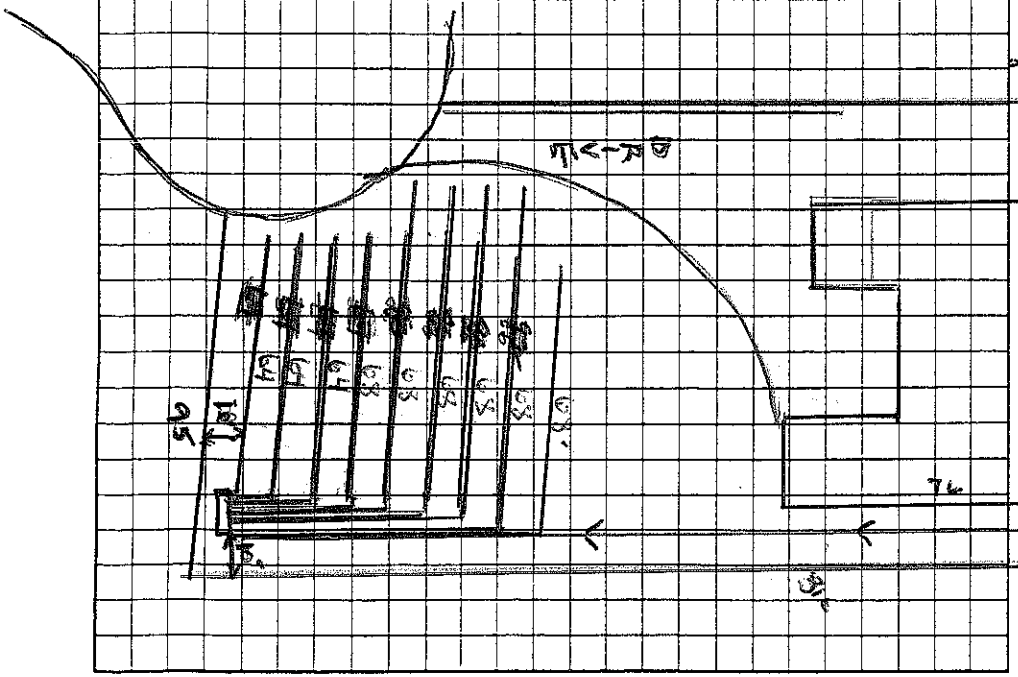

AS BUILT SKETCH

CHECKED 2-18-10
TANKS FULL OF WATER
PT LID CRACKED
CHECKED PB BOX
LOOKED GOOD

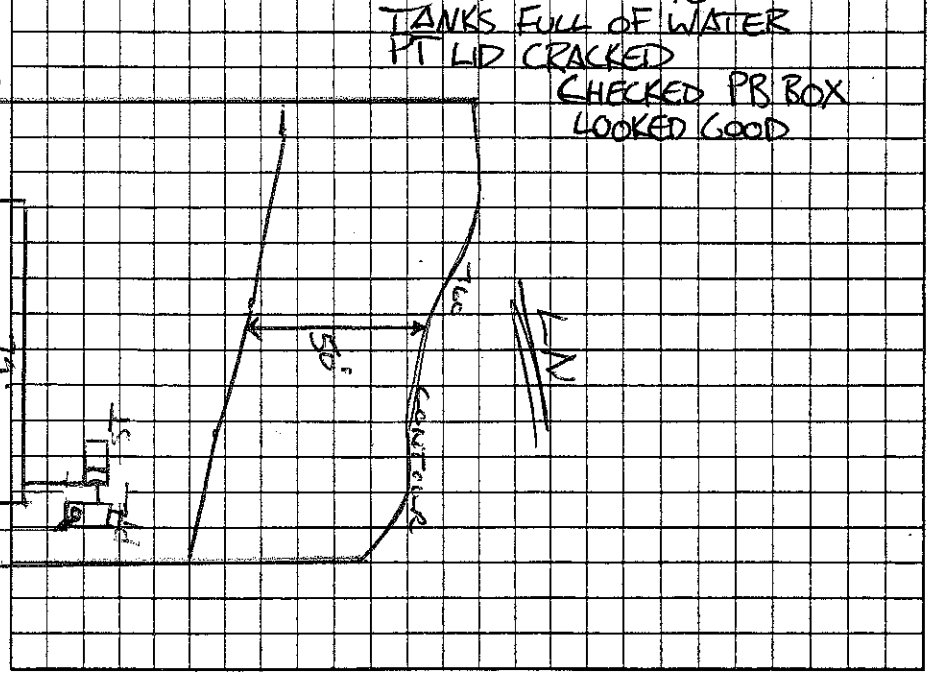

Permit can be suspended or revoked if any false information is supplied toward securing the permit/any unauthorized changes are made to the site/any unauthorized changes are made in the installation of the system. Improvement Permit with plat valid without expiration ☐ Improvement Permit with site plan valid for sixty months ☐ Authorization to Construct is valid for a period equal to that of Improvement Permit – not to exceed sixty months.

Signed: X [signature] date 2-17-07 Installed by: ABERNATHY

Improvement Permit by: Wesley Sparks RS date 2/5/07 Operation Permit by: [signature] REHS date 2-22-10

Authorization to Construct by: Wesley Sparks RS date 2/5/07 Existing System Inspection by: date

HEALTH DEPT. COPY: WHITE OWNER COPY (FINAL): YELLOW OWNER COPY (INITIAL): PINK