IREDELL COUNTY HEALTH DEPARTMENT

STATESVILLE 704-878-5305 MOORESVILLE 704-664-5281

IMPROVEMENT PERMIT / AUTHORIZATION TO CONSTRUCT / OPERATION PERMIT / EXISTING SYSTEM INSPECTION

PERMIT# ~~07559~~ 19752 PIN# ~~4726 88 9940~~ 4628407549 DATE 4/13/05

OWNER OR CONTRACTOR Ed Goldreich PHONE: Business 704-663-6261 Home

ADDRESS 110 Camp Lane Mooresville NC. 28117

LOCATION Old Camp Ln. 150W TL Highland Dr. TR Old Camp Ln. on(R) at cul de sac

SUBDIVISION Pinnacle Shores BLOCK / SECTION 4 LOT 18 LOT AREA 1.013 SITE CLASS PS DESIGN FLOW 480 L.T.A.R. .3

Septic Tank: 2@1000 Gallons; STB 794 Date 4/14/05
Pump Tank: 1000 Gallons; PT 312 Date 4/14/05
Pump Make: Model Serial No.
Nitrification Field: No. Fields 1 Square Feet 800 Linear Feet 269
No. Lines 4@24 Trench Width 3' Max Trench Bottom Depth 3' Gravel Depth No

[X] New System [ ] Repair System Type: I, II, III, IV, V, VI
System Description: Flow Divider - Dist Box - 16" PPBRS
Repair System Description: Type 3
Maintenance Agreement Required: [ ] Yes [X] No


[X] House/Mod. Home No. Bedrooms 4
[ ] Mobile Home No. Bathrooms 4
[ ] Business No. Employees
[ ] Other
[ ] Slab [ ] Crawl Space [X] Basement w/plumbing [ ] Basement wo/plumbing

Water Supply:
[ ] Individual
[ ] Public
[X] Community


Comments:/Conditions:

Comments:/Conditions:

(1"=50') INITIAL SITE SKETCH

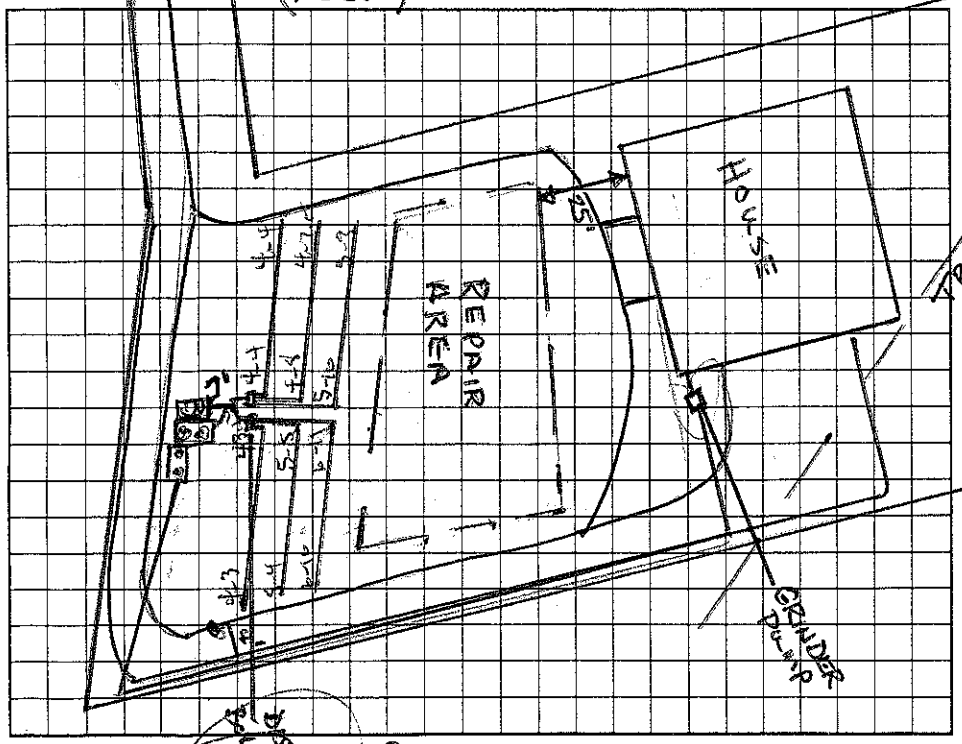

AS BUILT SKETCH

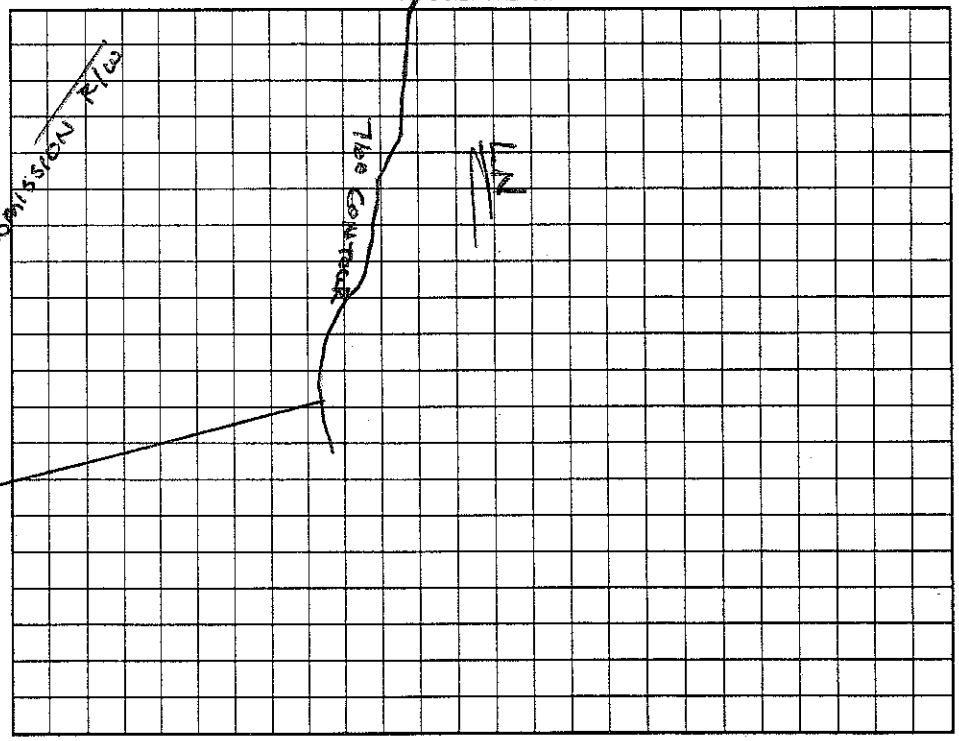

Permit can be suspended or revoked if any false information is supplied toward securing the permit/any unauthorized changes are made to the site/any unauthorized changes are made in the installation of the system. Improvement Permit with plat valid without expiration. Improvement Permit with site plan valid for sixty months. Authorization to Construct is valid for a period equal to that of Improvement Permit – not to exceed sixty months.

Signed: * date 4-25-05 Installed by: Odison & Sons.

Improvement Permit by: Wesley Sparks RS. date 4/13/05 Operation Permit by: Wesley Sparks RS date 5/26/05

Authorization to Construct by: Wesley Sparks RS. date 4/13/05 Existing System Inspection by: date

HEALTH DEPT. COPY: WHITE OWNER COPY (FINAL): YELLOW OWNER COPY (INITIAL): PINK