IREDELL COUNTY HEALTH DEPARTMENT

STATESVILLE 704-878-5305 MOORESVILLE 704-664-5281

IMPROVEMENT PERMIT / AUTHORIZATION TO CONSTRUCT / OPERATION PERMIT / EXISTING SYSTEM INSPECTION

PERMIT# 075658 PIN# ~~4726449970 (H)~~ 4628-40-8787 DATE 8/9/99

OWNER OR CONTRACTOR Crescent Resources / JAY + TAMARA REANIS PHONE: Business _____ Home _____

ADDRESS P.O. Box 1003, Charlotte

LOCATION 150W TL Highland Dr 1st building on Rt

SUBDIVISION Pinnacle Shores BLOCK / SECTION 4 LOT 46 LOT AREA .67AC SITE CLASS. PS DESIGN FLOW 360 L.T.A.R. .25-.3

Septic Tank: 1000 Gallons; STB 794 Date 1/11/99

Pump Tank: 1000 Gallons; PT 27 Date 10/8/99

Pump Make: HYDROWATIC Model SHEF50M1 Serial No. 5/98

Nitrification Field: No Fields 1 Square Feet 900 Linear Feet 300

No Lines C-7 Trench Width 36" Max Trench Bottom Depth 36" Gravel Depth NA

☒ New System ☐ Repair System Type: I, II, III, (IV), V, VI

System Description: LP Pond Block

Repair System Description: SAMC

Maintenance Agreement Required: ☒ Yes ☐ No

☒ House/Mod. Home No. Bedrooms 4

☐ Mobile Home No. Bathrooms 4

☐ Business No. Employees ____

☐ Other ____


☐ Slab ☐ Crawl Space ☐ Basement w/plumbing ☐ Basement wo/plumbing

Water Supply: ☐ Individual ☒ Public ☒ Community


Comments:/Conditions: 1"=100'

Comments:/Conditions:

INITIAL SITE SKETCH

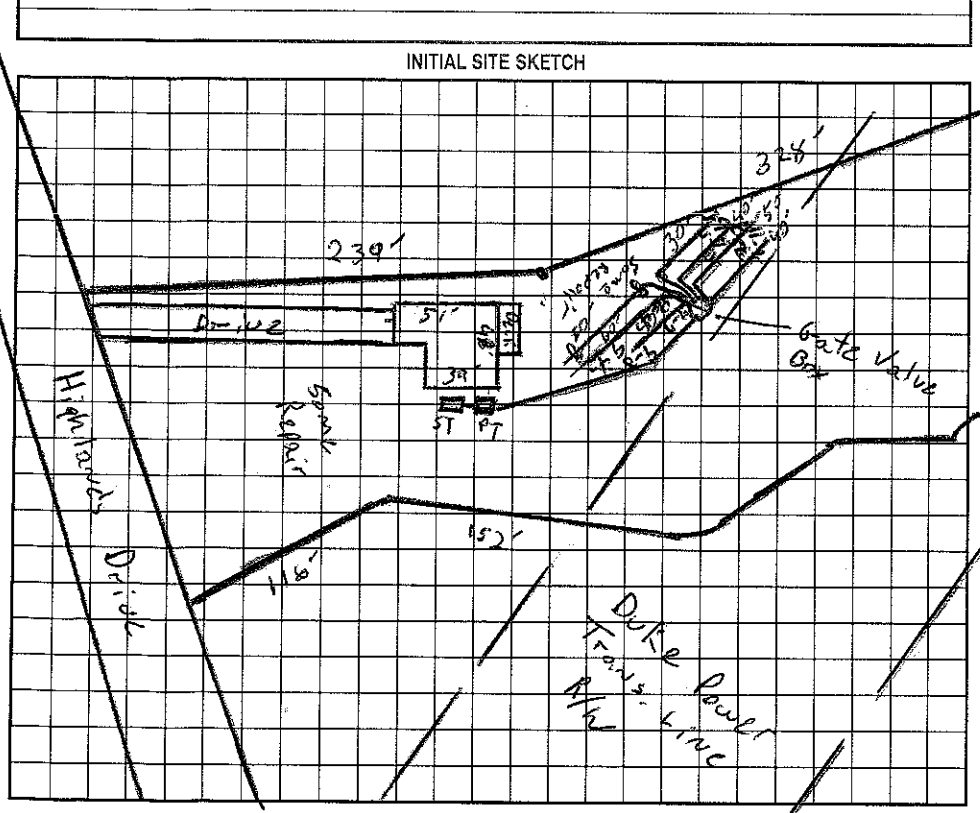

AS BUILT SKETCH

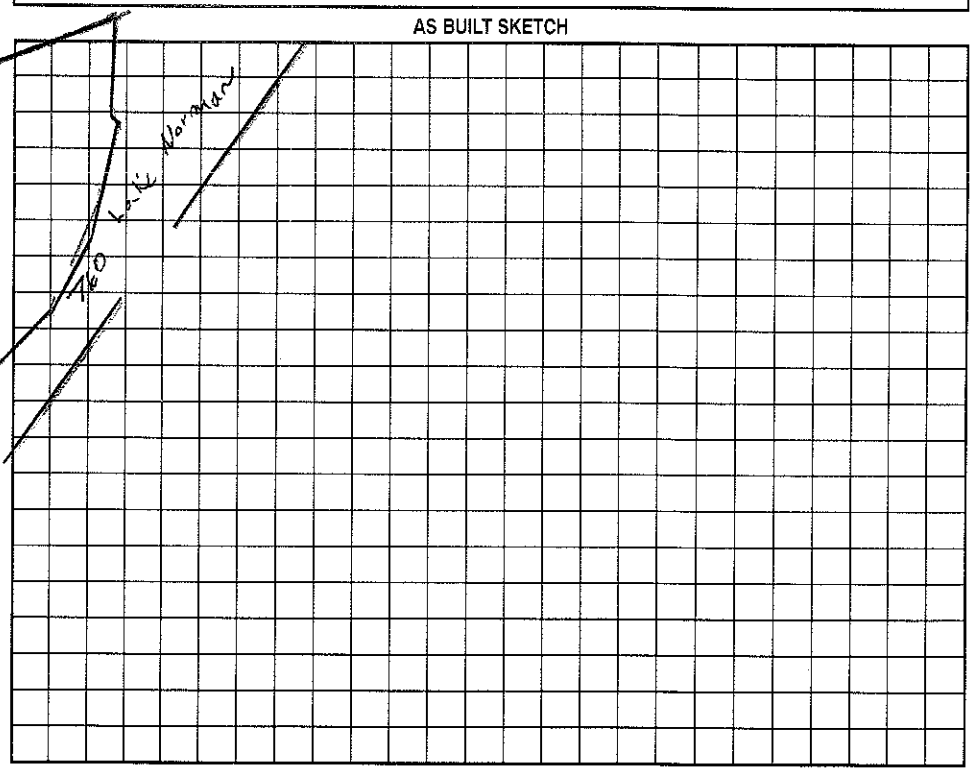

Permit can be suspended or revoked if any false information is supplied toward securing the permit/any unauthorized changes are made to the site/any unauthorized changes are made in the installation of the system. Improvement Permit with plat valid without expiration. Improvement Permit with site plan valid for sixty months. Authorization to Construct is valid for a period equal to that of Improvement Permit – not to exceed sixty months.

Signed: T.G. date 8-11-99 Installed by: Mac Land Const.

Improvement Permit by: Jeff Morgan date 8/3/99 Operation Permit by: Wesley Sparks RS date 12/1/99

Authorization to Construct by: Wesley Sparks RS. date 8/19/99 Existing System Inspection by: _____ date _____

HEALTH DEPT. COPY: WHITE OWNER COPY (FINAL): YELLOW OWNER COPY (INITIAL): PINK