AUTH. TO CONSTRUCT (3:00) - (3:30)

IREDELL COUNTY HEALTH DEPARTMENT

STATESVILLE 704-878-5305 MOORESVILLE 704-664-5281

IMPROVEMENT PERMIT / ~~CERTIFICATE OF COMPLETION~~ / OPERATION PERMIT / EXISTING SYSTEM INSPECTION

PROPERTY DESCRIPTION NO. 23715 DATE 8/29/96 TAX MAP NO. PT OF 2N A 20 Watershed: ☑ Yes ☐ No

OWNER OR CONTRACTOR ~~CRESCENT ESTATES INC~~ CHARLES STEVENS PHONE: Business 4628 41 7908 Home 846-3248

ADDRESS PO BOX 1003, CHARLOTTE NC

LOCATION 150 IN TR PINNACLE LN ON RT.

SUBDIVISION PINNACLE STONES BLOCK / SECTION III LOT 32 LOT AREA 1.18 AC SITE CLASS. PS DESIGN FLOW 480 GPD L.T.A.R. .3 GPD/FT²

Septic Tank: 1000 Gallons; STB 097 Date 5/14/97

Pump Tank: Gallons; PT 71 Date 7/29/97

Pump Make: GOULDS Model WG0311 Serial No.

Nitrification Field: No Fields 1 Square Feet 1200 Linear Feet 400

No Lines 4 @ 100 Trench Width 36" Max Trench Bottom Depth 36" Gravel Depth N/A

☑ New System ☐ Repair System Type: I, II, (III), IV, V, VI

System Description: PUMP CHAMBERED

Repair System Description: SAME

Maintenance Agreement Required: ☐ Yes ☑ No

☑ House/Mod. Home No. Bedrooms 4

☐ Mobile Home No. Bathrooms 3

☐ Business No. Employees

☐ Other


☐ Slab ☐ Crawl Space ☑ Basement w/plumbing ☐ Basement wo/plumbing

Water Supply: ☐ Individual ☑ Community ☐ Public


Comments:

Comments: EZ LAY INSTALLED

INITIAL SITE SKETCH 1"=50'

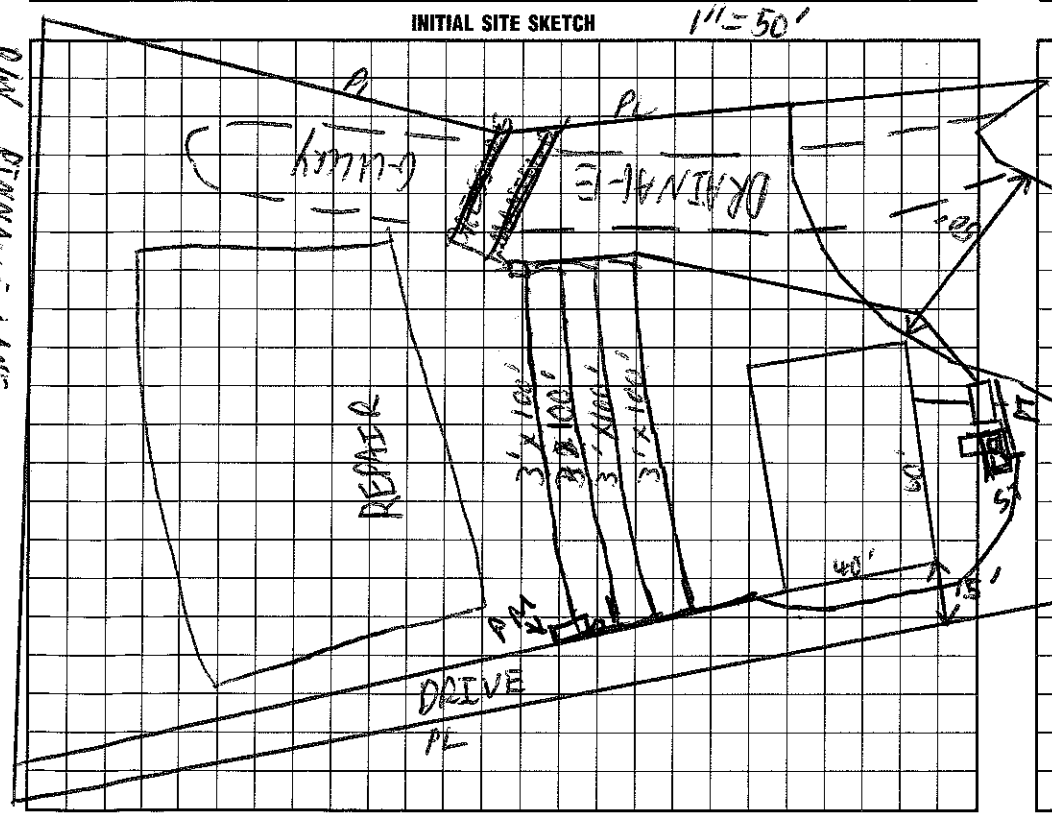

AS BUILT SKETCH

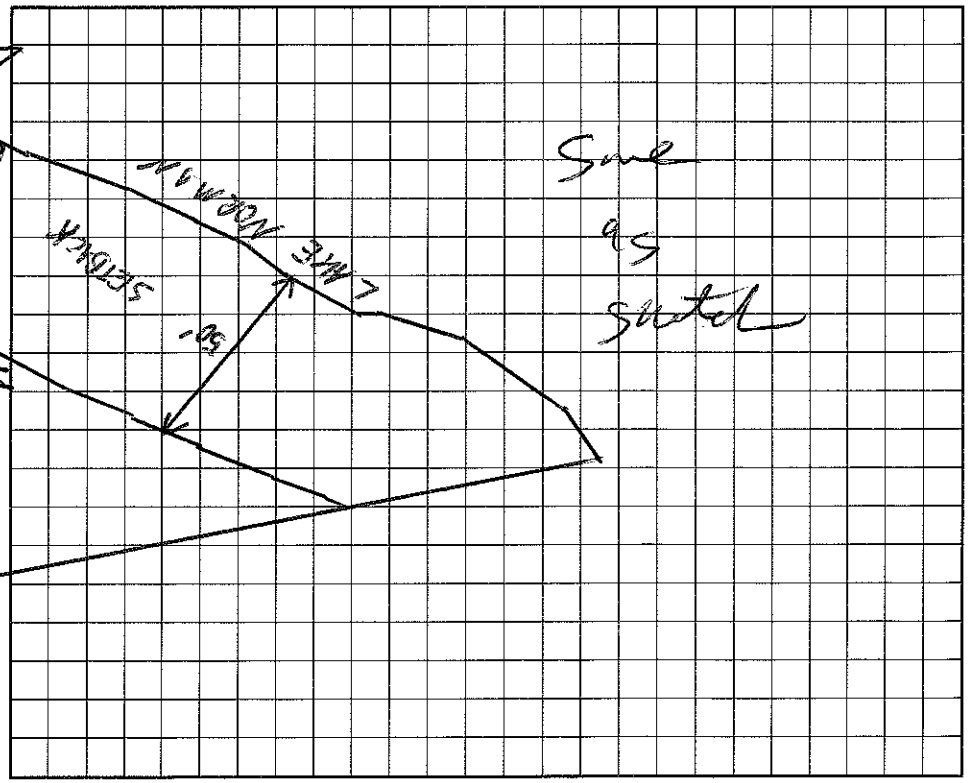

I understand that this permit can be suspended or revoked if any false information is supplied toward securing the permit/any unauthorized changes are made to the site/any unauthorized changes are made in the installation of the system.

Signed: Charles W Stevens

Improvement Permit by: [illegible] PHSI date 8/29/96

~~Existing System Inspection by:~~ AUTH. TO CONSTRUCT [illegible] EHSI date 8/29/96

Installed by: WT NOORWOOD

Certificate of Completion by: Wesley Sparks RS. date 2/9/98

Operation Permit by: Wesley Sparks RS. date 2/9/98

HEALTH DEPT. COPY: WHITE INSPECTION COPY (FINAL): GREEN OWNER COPY (FINAL): YELLOW INSPECTION COPY (INITIAL): PINK OWNER COPY (INITIAL): GOLD