IREDELL COUNTY HEALTH DEPARTMENT

STATESVILLE 704-878-5305 145.00 Paid MOORESVILLE 704-664-5281

IMPROVEMENT PERMIT / AUTHORIZATION TO CONSTRUCT / OPERATION PERMIT / EXISTING SYSTEM INSPECTION

PERMIT# 120535 PIN# 4628 41 9873 DATE 4/27/05

OWNER OR CONTRACTOR Quickel Development Co. PHONE: Business 704-795-0595 Home 704-783-6403

ADDRESS PO Box 1218 Concord, NC. 28026

LOCATION 150 W TR Pinnacle Lane on (R) L fork end.

SUBDIVISION Pennacle Shores BLOCK / SECTION 3 LOT 29 LOT AREA .82 SITE CLASS. PS DESIGN FLOW 480 L.T.A.R. .3

Septic Tank: 1000 Gallons; STB 821 Date 3/21/04

Pump Tank: 1000 Gallons; PT 40 Date 4/4/05

Pump Make: ZOELLER Model N-161E Serial No. 4/27/05

Nitrification Field: No Fields 1 Square Feet 800 Linear Feet 266

No Lines 4 @ 66' Trench Width 3' Max Trench Bottom Depth 3' Gravel Depth No

[X] New System [ ] Repair System Type: I, II, III, (IV), V, VI

System Description: Pressured - 16" PPBRS

Repair System Description: Same System

Maintenance Agreement Required: [X] Yes [ ] No

[X] House/Mod. Home No. Bedrooms 4

[ ] Mobile Home No. Bathrooms 4

[ ] Business No. Employees

[ ] Other


[ ] Slab [ ] Crawl Space [X] Basement w/plumbing [ ] Basement wo/plumbing

Water Supply: [ ] Individual [ ] Public [X] Community PINNACLE SHORES


Comments:/Conditions: 1 - 3/16" hole per panel
PUMP MUST DELIVER 36 GPM MINIMUM

Comments:/Conditions:

INITIAL SITE SKETCH

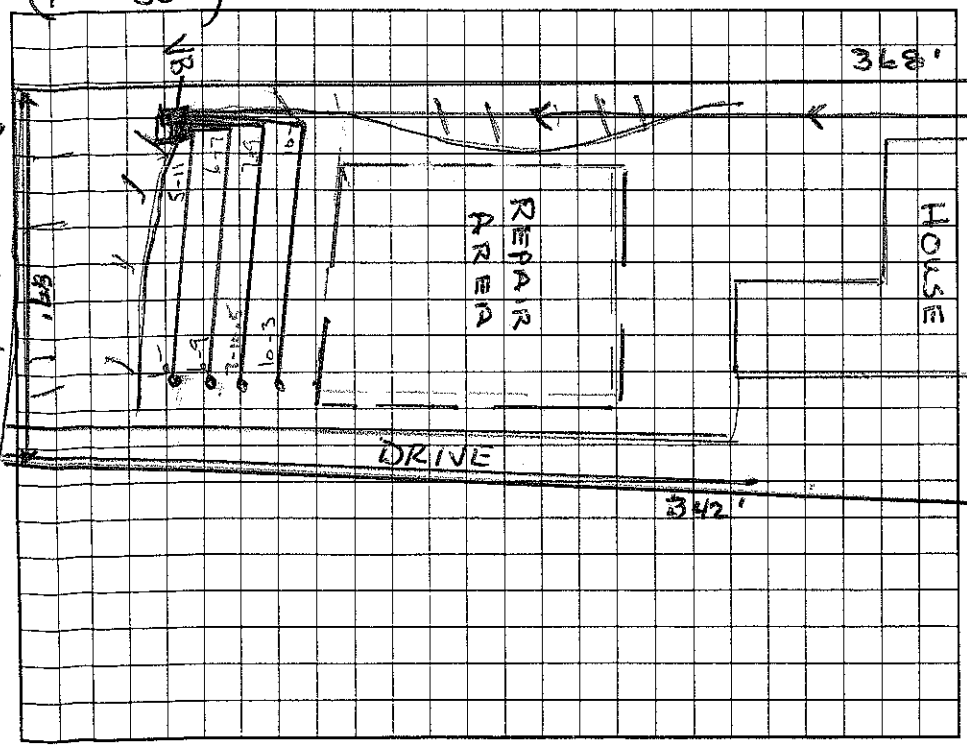

AS BUILT SKETCH

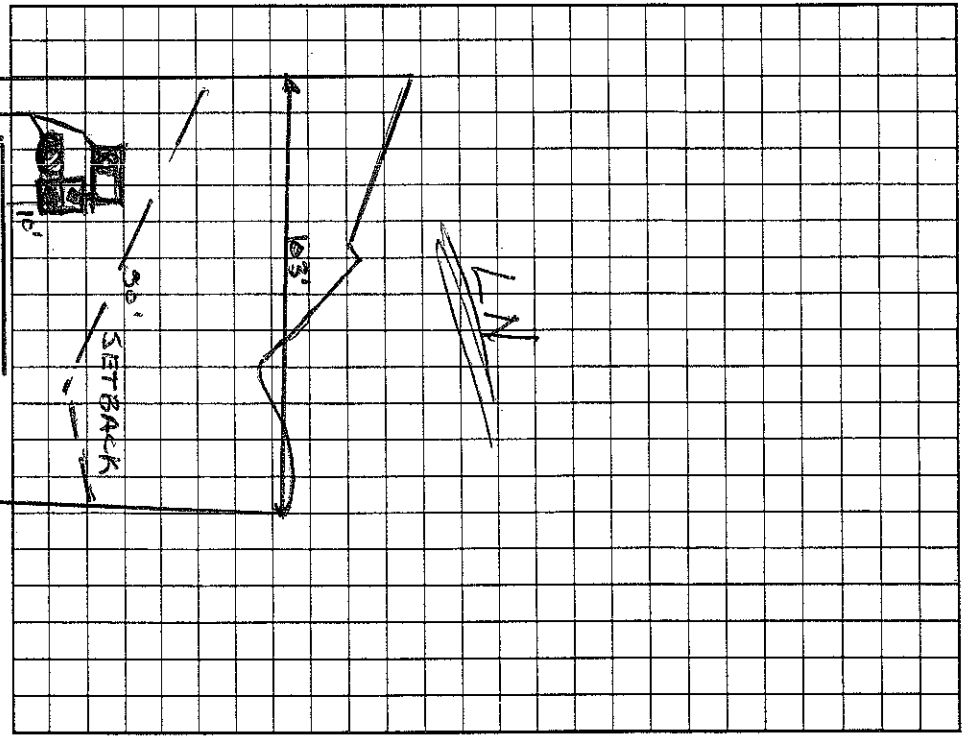

Permit can be suspended or revoked if any false information is supplied toward securing the permit/any unauthorized changes are made to the site/any unauthorized changes are made in the installation of the system. Improvement Permit with plat valid without expiration. Improvement Permit with site plan valid for sixty months. Authorization to Construct is valid for a period equal to that of Improvement Permit – not to exceed sixty months.

Signed: [signature] date 4/28/05 Installed by: GHM Const.

Improvement Permit by: Wesley Sparks RS. date 4/27/05 Operation Permit by: Wesley Sparks RS date 6/20/05

Authorization to Construct by: Wesley Sparks RS. date 4/27/05 Existing System Inspection by: date

HEALTH DEPT. COPY: WHITE OWNER COPY (FINAL): YELLOW OWNER COPY (INITIAL): PINK