IREDELL COUNTY HEALTH DEPARTMENT

STATESVILLE 704-878-5305 MOORESVILLE 704-664-5281

IMPROVEMENT PERMIT / AUTHORIZATION TO CONSTRUCT / OPERATION PERMIT / EXISTING SYSTEM INSPECTIO

PERMIT# 131407 PIN# 4628422349 Dewey Saunders DATE 10-24-05

OWNER OR APPLICANT Bernard & Tracy May PHONE: Business 622-5458 Home 920-7117

ADDRESS P.O. Box 417 Mooresville, NC 28117

LOCATION Hwy 150 West TR Pinnacle Ln at end on right

SUBDIVISION Pinnacle Shores BLOCK / SECTION III LOT 37 LOT AREA 1.015 Acre SITE CLASS PS DESIGN FLOW 600gpd L.T.A.R. .3

Septic Tank: 1500 Gallons; STB 1011 Date 5/20/06
Pump Tank: 1500 Gallons; PT 297 Date 3/13/06
Pump Make: Goulds Model WS05H Serial No.
Nitrification Field: No Fields 1 Square Feet 60'70' Linear Feet 335
No Lines 6 Trench Width 24-36" Max Trench Bottom Depth 36" Gravel Depth N/A ☐ Gravity ☐ Pressure

☒ New System ☐ Repair ☐ Expansion System Type: I II III IV V VI
System Description: Pump-LP-Panel Block
Repair System Description: Same
Maintenance Agreement Required: ☒ Yes ☐ No

☒ House/Mod. Home ☐ Mobile Home ☐ Business ☐ Other
No. Bedrooms 5 No. Persons ___ No. Employees ___


Water Supply: ☐ Individual ☒ Public ☒ Community

☐ Slab ☐ Crawl Space ☒ Basement w/plumbing ☐ Basement wo/plumbing


Comments:/Conditions: * Use "in line" Filter on pump
80 Panels 3/16" holes

Comments:/Conditions: Note: Design Flow > 480gal therefore System shall be pressure dosed.

INITIAL SITE SKETCH Scale 1:50'

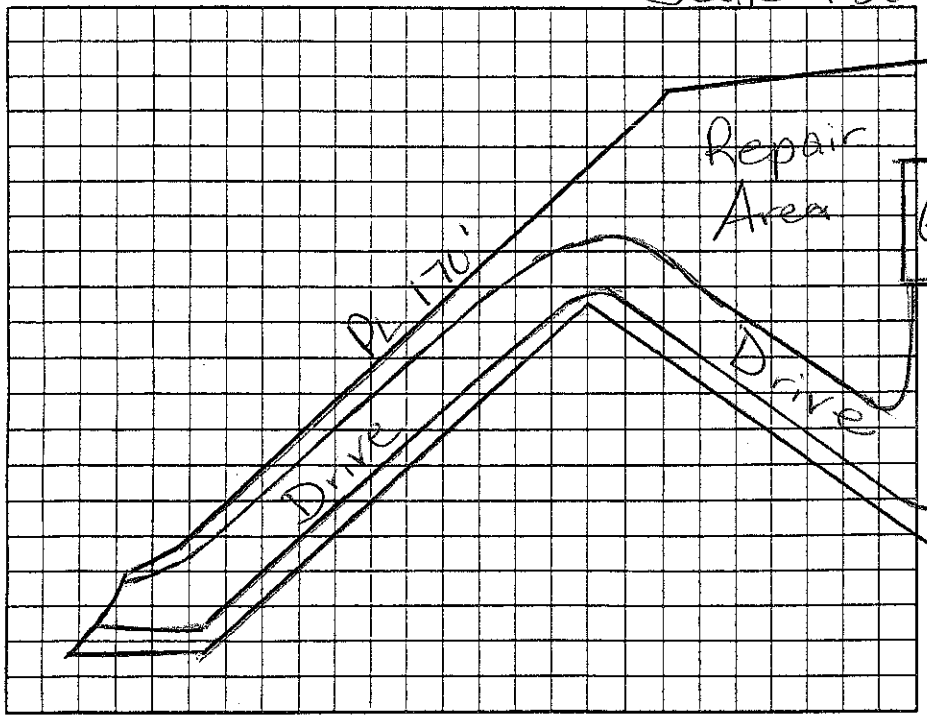

AS BUILT SKETCH

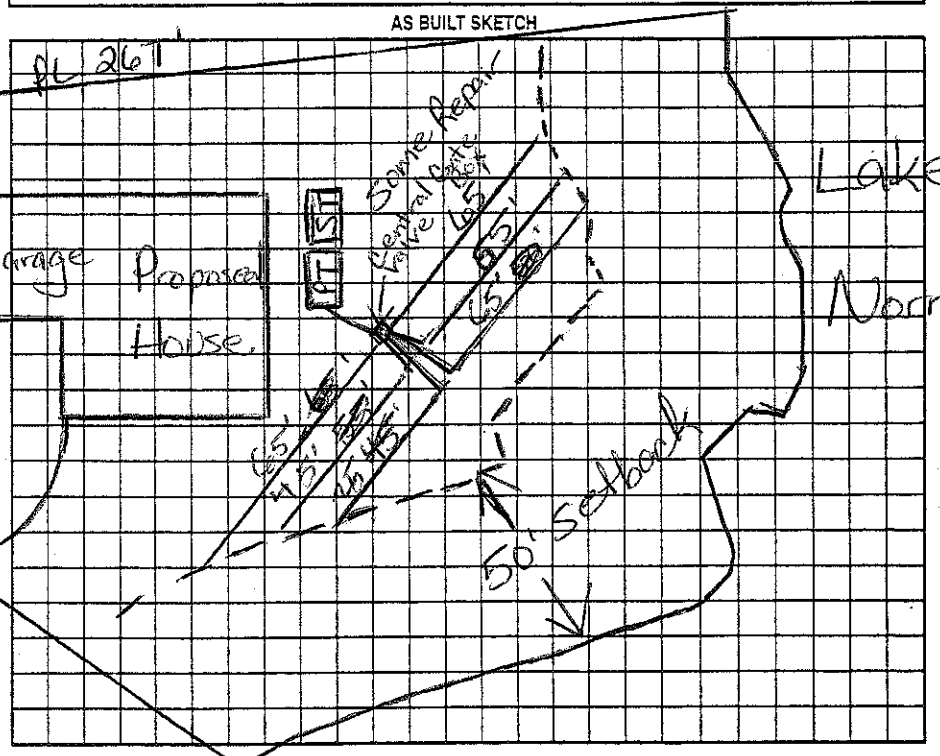

Permit can be suspended or revoked if any false information is supplied toward securing the permit/any unauthorized changes are made to the site/any unauthorized changes are made in the installation of the system. Improvement Permit with plat valid without expiration ☐ Improvement Permit with site plan valid for sixty months ☐ Authorization to Construct is valid for a period equal to that of Improvement Permit – not to exceed sixty months.

Signed: date 10-25-05 Installed by: C+S

Improvement Permit by: Maria H. Dotson RS date 10/24/05 Operation Permit by: RS date 10/5/06

Authorization to Construct by: Maria H. Dotson RS date 10/24/05 Existing System Inspection by: date

HEALTH DEPT. COPY: WHITE OWNER COPY (FINAL): YELLOW OWNER COPY (INITIAL): PINK