IREDELL COUNTY HEALTH DEPARTMENT Coast Hill STATESVILLE 704-878-5305 MOORESVILLE 704-664-5281

**IMPROVEMENT PERMIT / ~~CERTIFICATE OF COMPLETION~~ / OPERATION PERMIT / EXISTING SYSTEM INSPECTION**

PROPERTY DESCRIPTION NO. 23566 DATE July 11, '96 TAX MAP NO. part of 2NA20 Watershed: ☑ Yes ☐ No

OWNER OR CONTRACTOR Crescent Resources Inc. PHONE: Business Home

ADDRESS PO Box 1003 Charlotte

LOCATION 152 W The Pinnacle Lane At End

SUBDIVISION Pinnacle Shores BLOCK / SECTION III LOT 37 LOT AREA 1.01 Ac SITE CLASS. PS per 1956 DESIGN FLOW 480 gpd L.T.A.R. .3

Septic Tank: 1000 Gallons; STB Date

Pump Tank: 1000 Gallons; PT Date

Pump Make: Model Serial No.

Nitrification Field: No Fields 1 Square Feet 1200 Linear Feet 400

No Lines 4@100' Trench Width 36" Max Trench Bottom Depth 36" Gravel Depth NA

☑ New System ☐ Repair System Type: I, II, (III), IV, V, VI

System Description: pumped - low - chambered

Repair System Description: 1 Area in block

Maintenance Agreement Required: ☐ Yes ☑ No

☑ House/Mod. Home ☐ Mobile Home ☐ Business ☐ Other

No. Bedrooms 4 No. Bathrooms 4 No. Employees

☐ Slab ☑ Crawl Space ☑ Basement w/plumbing ☐ Basement wo/plumbing


Water Supply: ☐ Individual ☑ Community ☐ Public

Comments: Improvement Permit only / Do not issue Building Permit


Comments: partial

1" = 50'

**INITIAL SITE SKETCH**

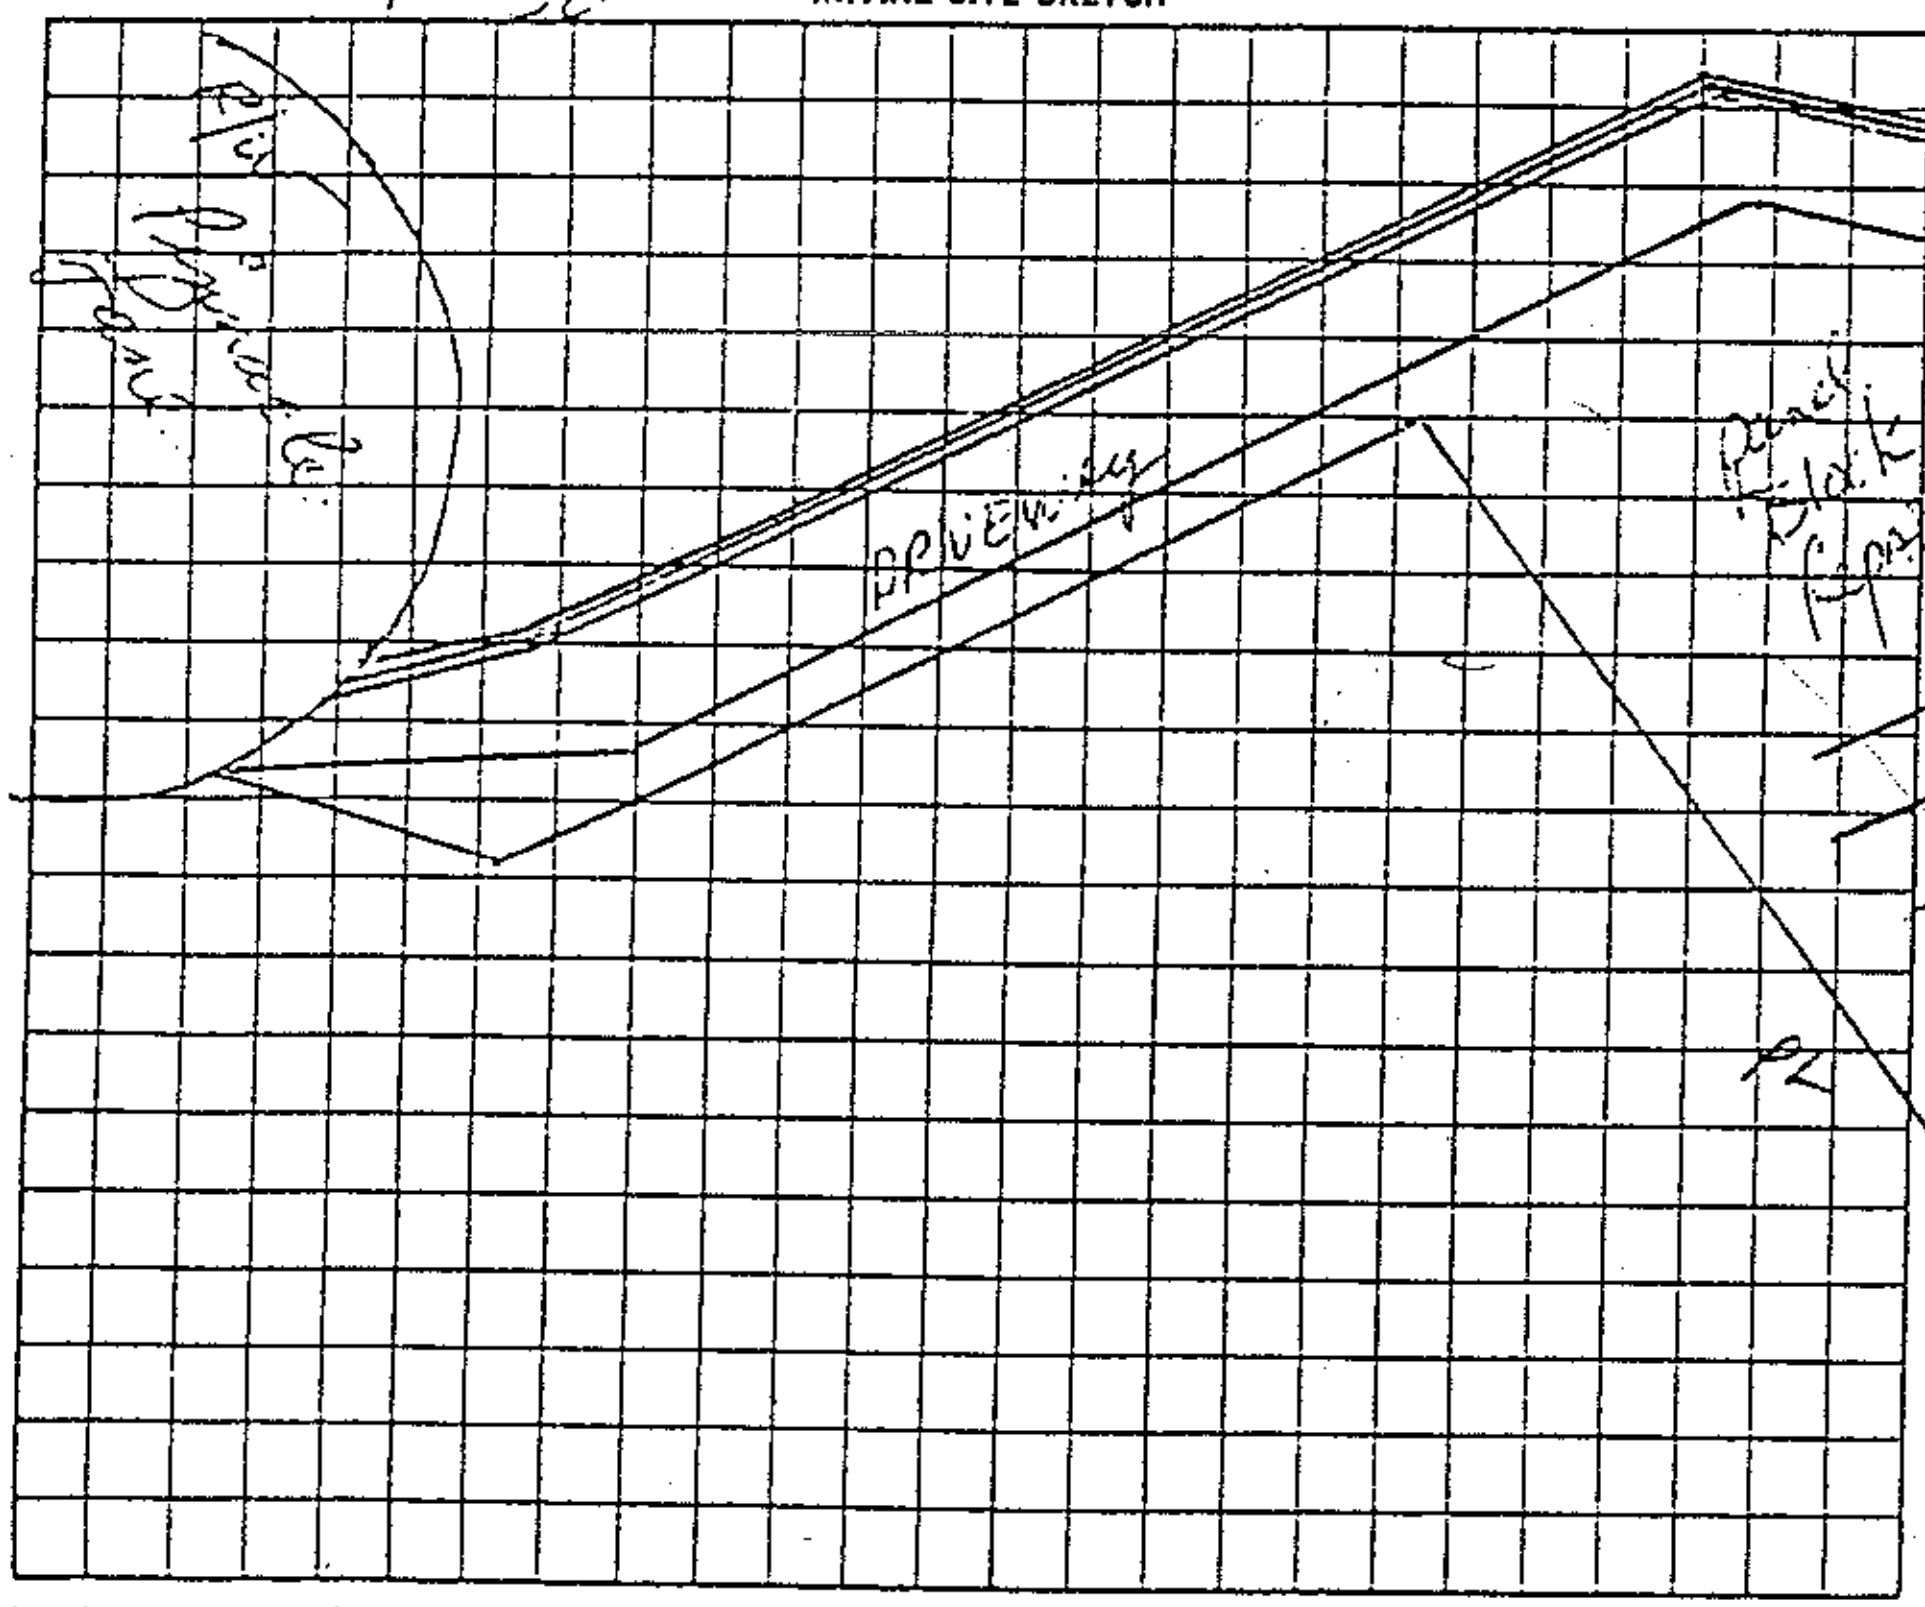


**AS BUILT SKETCH**

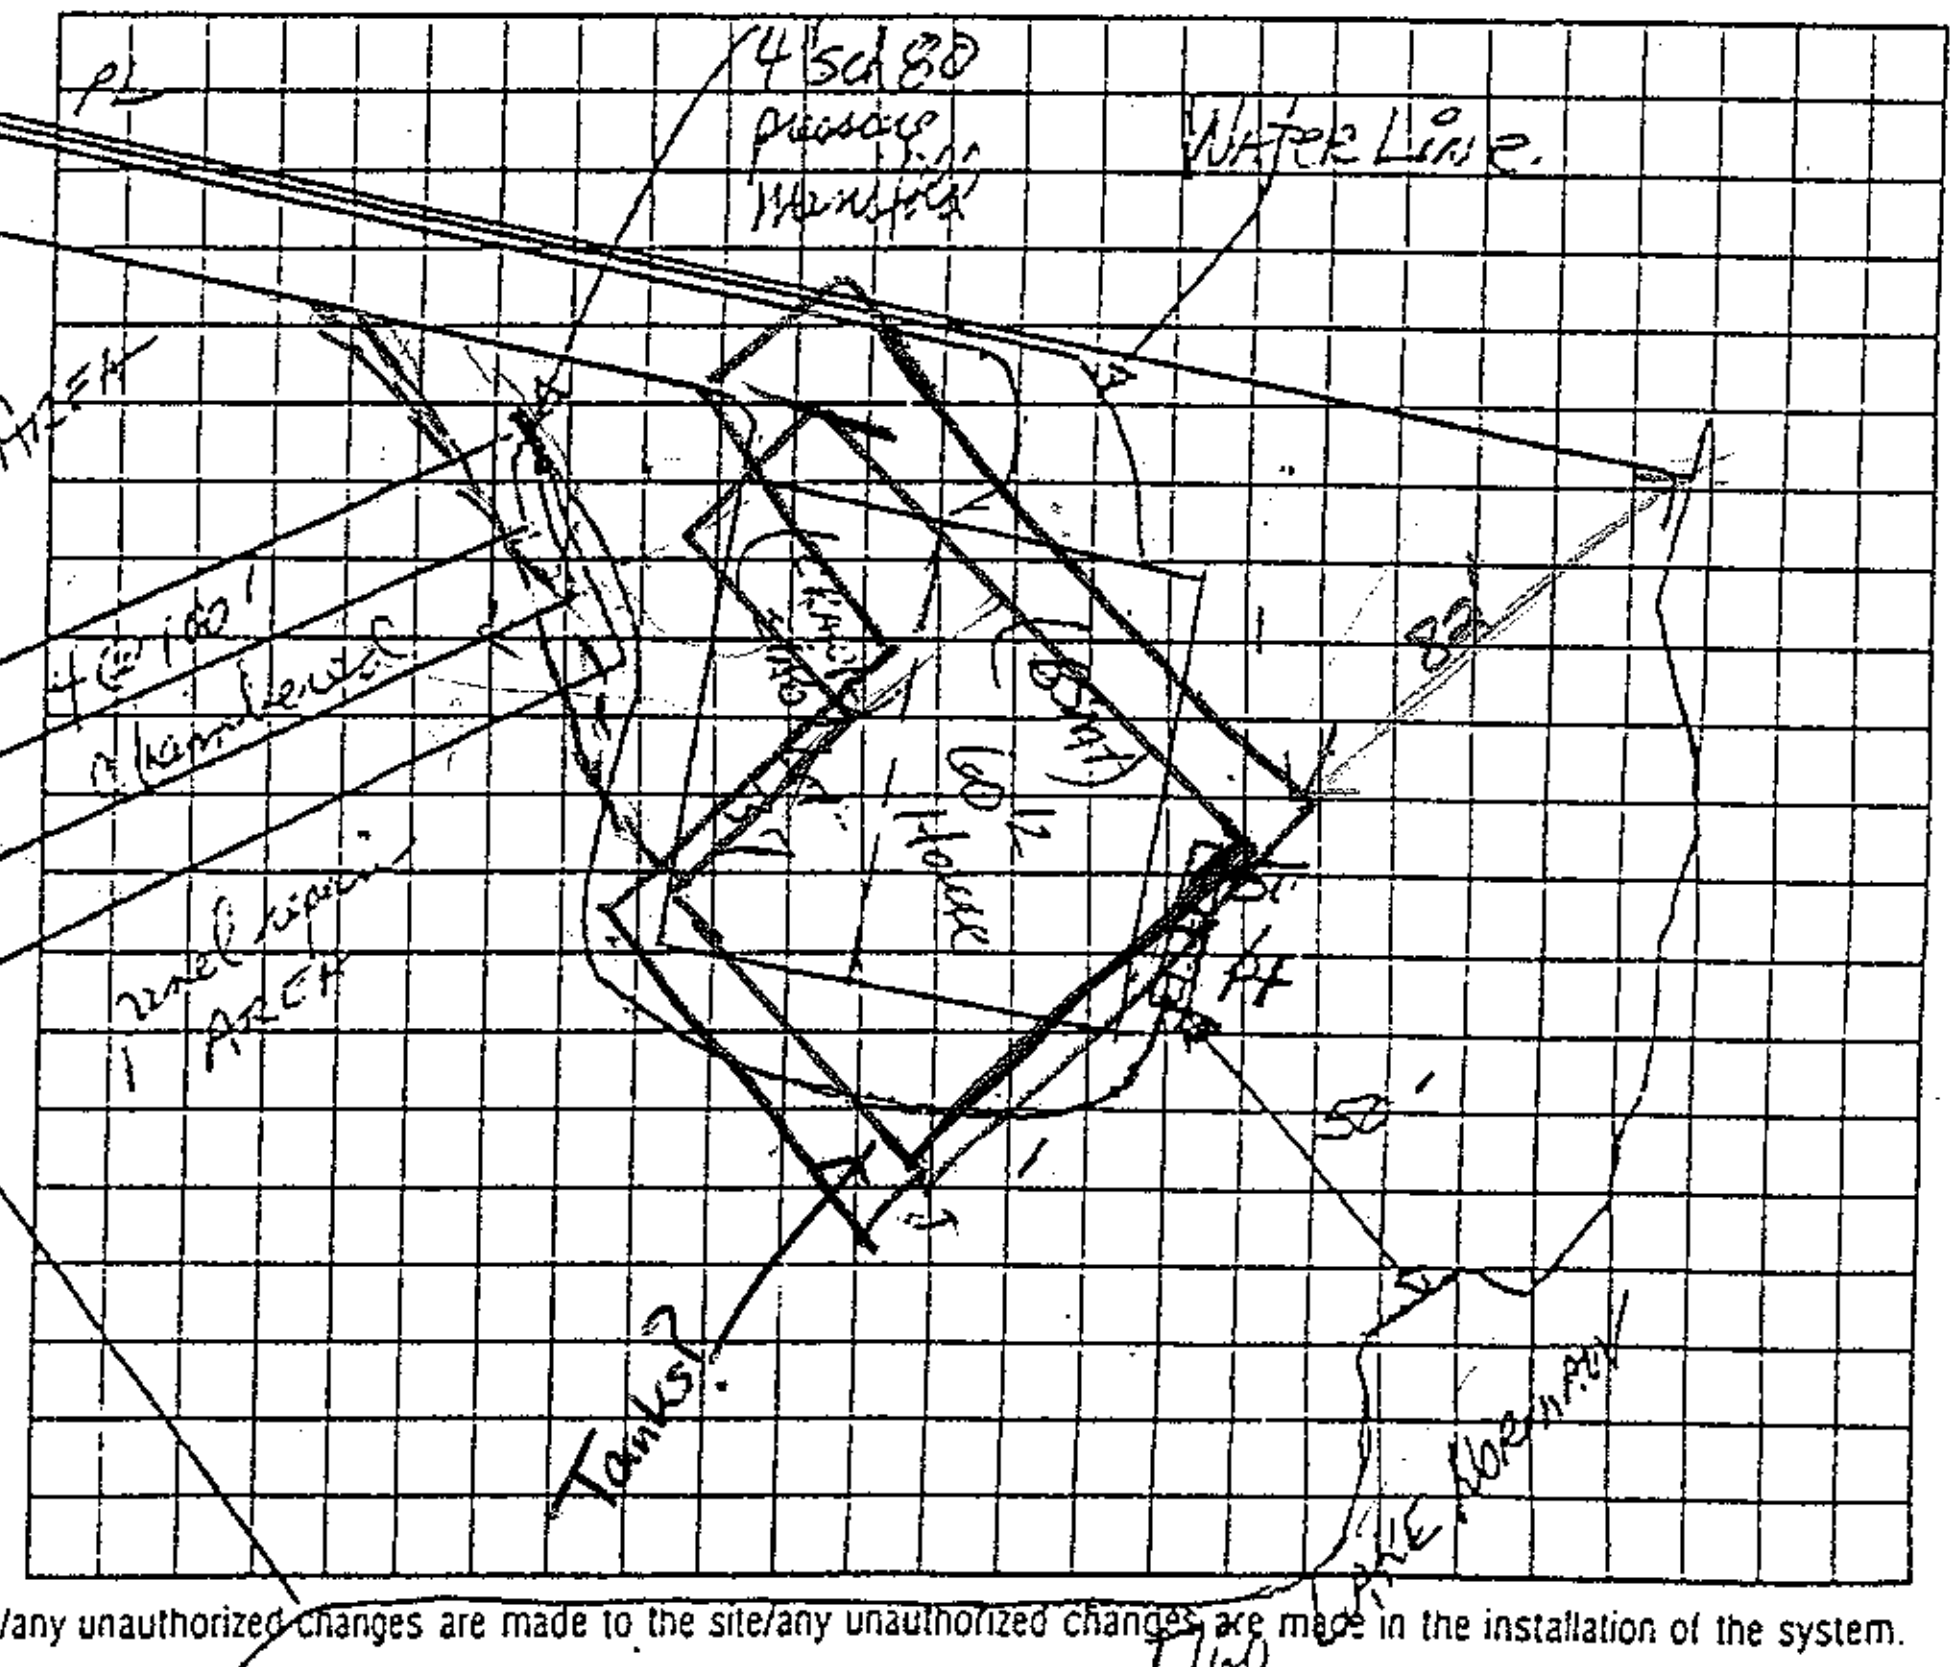


I understand that this permit can be suspended or revoked if any false information is supplied toward securing the permit/any unauthorized changes are made to the site/any unauthorized changes are made in the installation of the system.

Signed: Terry C. Hughes, CPSS

Improvement Permit by: [signature], R.S. date 7-11-96

~~Existing System Inspection by:~~ Construction Authorization date

Installed by:

Certificate of Completion by: date

Operation Permit by: date

HEALTH DEPT. COPY: WHITE INSPECTION COPY (FINAL): GREEN OWNER COPY (FINAL): YELLOW INSPECTION COPY (INITIAL): PINK OWNER COPY (INITIAL): GOLD