IREDELL COUNTY HEALTH DEPARTMENT

STATESVILLE 704-878-5305 MOORESVILLE 704-664-5281

IMPROVEMENT PERMIT / AUTHORIZATION TO CONSTRUCT / OPERATION PERMIT / EXISTING SYSTEM INSPECTION

$350

PERMIT# 069115 PIN# 4628-42-5137 DATE

OWNER OR CONTRACTOR B.A. Baumgarner PHONE: Business 704-483-4443 Home

ADDRESS PO Box 628 Denver NC 28037

LOCATION 150 W TR Pinnacle Ln., on Rt Near End

SUBDIVISION Pinnacle Shores BLOCK / SECTION LOT 34 LOT AREA 0.77AC SITE CLASS PS DESIGN FLOW 360 L.T.A.R. 0.3

Septic Tank: 1000 Gallons; STB 794 Date 7/30/02

Pump Tank: 1600 Gallons; PT 827 Date 9/4/02

Pump Make: Zoeller Model 1/2HP Serial No.

Nitrification Field: No Fields 1 Square Feet 1200 Linear Feet 400'

No Lines 5 @ 80' Trench Width 36" Max Trench Bottom Depth 36" Gravel Depth 12"

☒ New System ☐ Repair System Type: I, II, III, IV, V, VI

System Description: Press. Man. Conventional

Repair System Description: Pump Panel Block

Maintenance Agreement Required: ☐ Yes ☒ No

☒ House/Mod. Home ☐ Mobile Home ☐ Business ☐ Other

No. Bedrooms 3 No. Bathrooms 2 No. Employees


Water Supply: ☐ Individual ☐ Public ☒ Community

☐ Slab ☐ Crawl Space ☒ Basement w/plumbing ☐ Basement wo/plumbing


Comments:/Conditions:

Comments:/Conditions: Tanks & lines Checked by GM 11/27/02
Elect. & alarm Checked by MDJ 7/24/03

INITIAL SITE SKETCH

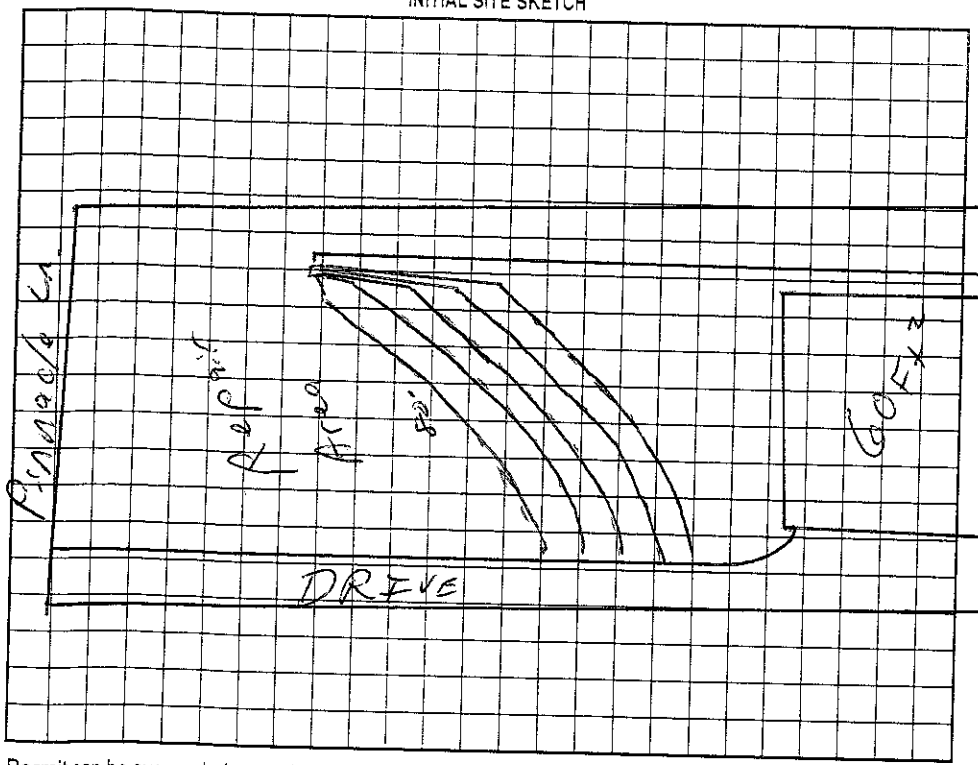

AS BUILT SKETCH

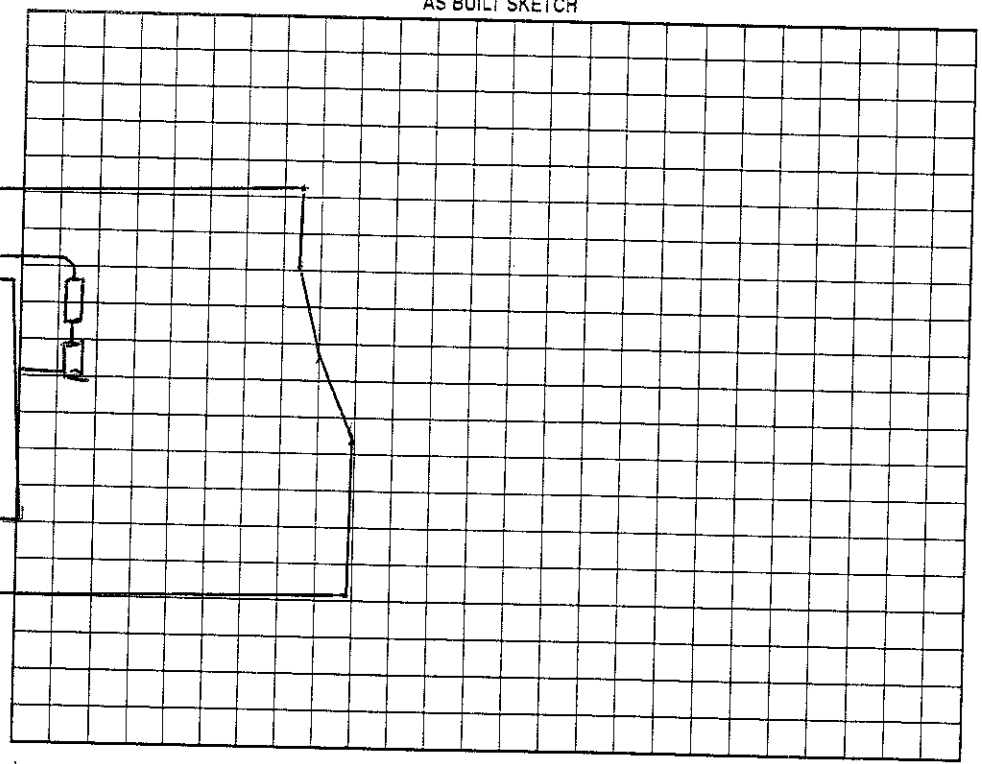

Permit can be suspended or revoked if any false information is supplied toward securing the permit/any unauthorized changes are made to the site/any unauthorized changes are made in the installation of the system. Improvement Permit with plat valid without expiration. Improvement Permit with site plan valid for sixty months. Authorization to Construct is valid for a period equal to that of Improvement Permit – not to exceed sixty months.

Signed: date

Improvement Permit by: RS date 9/5/02

Authorization to Construct by: RS date 9/5/02

Installed by: Larry Henkel

Operation Permit by: RS date 7/29/03

Existing System Inspection by: date

HEALTH DEPT. COPY: WHITE OWNER COPY (FINAL): YELLOW OWNER COPY (INITIAL): PINK