IREDELL COUNTY HEALTH DEPARTMENT Const. Auth. STATESVILLE 704-878-5305 MOORESVILLE 704-664-5281

IMPROVEMENT PERMIT / ~~CERTIFICATE OF COMPLETION~~ / OPERATION PERMIT / EXISTING SYSTEM INSPECTION

PROPERTY DESCRIPTION NO (23865) 87803 DATE July 8, '96 TAX MAP NO. part of 2NA20 4628 42 8072 Watershed: ☑ Yes ☐ No

OWNER OR CONTRACTOR Crescent Resources Inc (GERALD WHITE) TELEPHONE: Business _____ Home _____

ADDRESS PO Box 1003 Charlotte

LOCATION 150 W TR Pinnacle Lane on Right

SUBDIVISION Pinnacle Shores BLOCK / SECTION III LOT 31 LOT AREA .84 Ac SITE CLASS. PSpec. 1956 DESIGN FLOW 480 gpd L.T.A.R. .3

Septic Tank: 1000 Gallons; STB 794 Date 5/22/99

Pump Tank: 1000 Gallons; PT 283 Date 2/29/00

Pump Make: HYDRO. Model SK60M1 Serial No. 3/99

Nitrification Field: No Fields 1 Square Feet 540 Linear Feet 270

No Lines 5@54' Trench Width 24" Max Trench Bottom Depth 30" Gravel Depth NA

☐ New System ☐ Repair System Type: I, II, (III) IV, V, VI

System Description: pm - panel block

Repair System Description: LP panel block

Maintenance Agreement Required: ☐ Yes ☑ ~~No~~ initially

☑ House/Mod. Home No. Bedrooms 4

☐ Mobile Home No. Bathrooms 4

☐ Business No. Employees _____

☐ Other _____

☐ Slab ☑ Crawl Space ☑ Basement w/plumbing ☐ Basement wo/plumbing


Water Supply: ☐ Individual ☑ ~~Community~~ ☐ Public

Comments:
1-27-2000 - House to be located as shown; floor plan in compliance w/ IP DKH


Comments: PARTIAL
5" ~~Sch~~ Tether ~ 147GPD.
4/27/00 Lines, Tank, Head Pressure

1"=50'

INITIAL SITE SKETCH

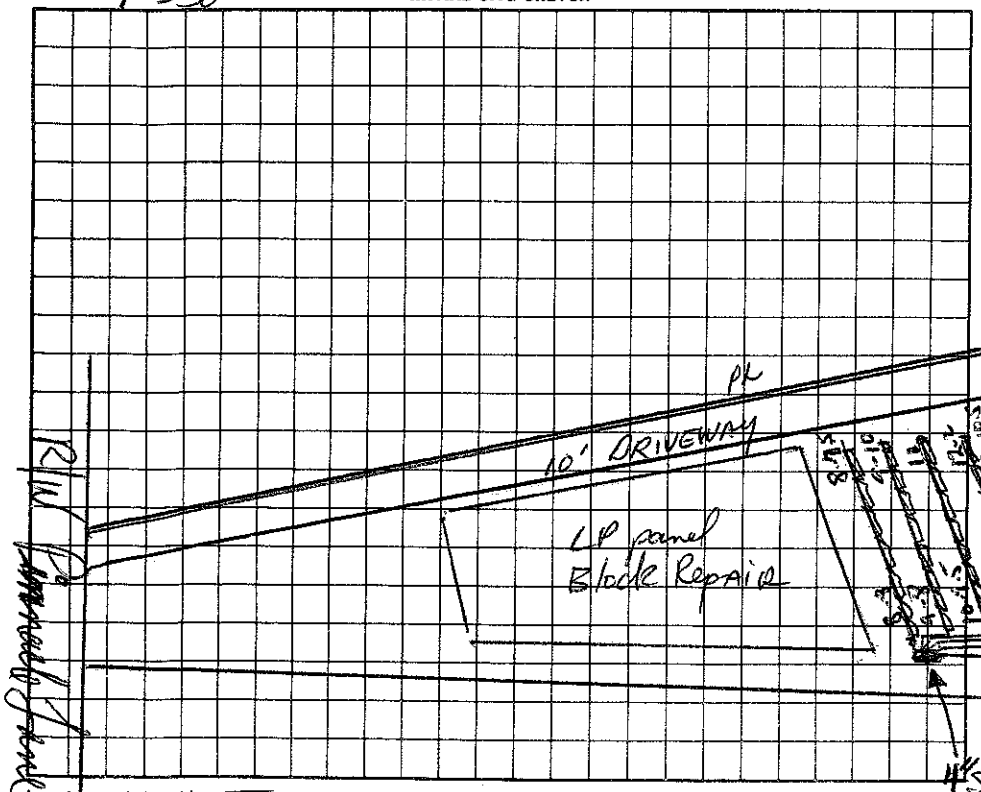

AS BUILT SKETCH

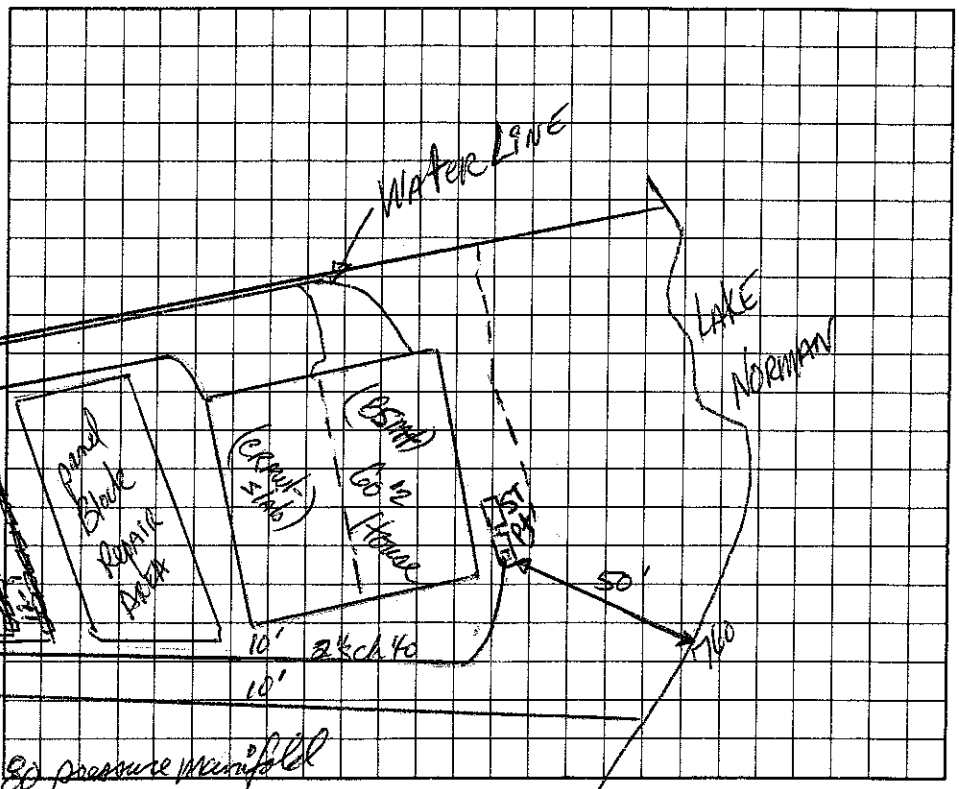

I understand that this permit can be suspended or revoked if any false information is supplied toward securing the permit/any unauthorized changes are made to the site/any unauthorized changes are made in the installation of the system.

Signed: Terry C Jones, CPSS

Improvement Permit by: Terry C Jones, RS date 7-8-96

~~Existing System Inspection by~~ CONSTRUCTION AUTHORIZATION David Hanson, RS date 1-27-2000

Installed by: Levon Benton

Certificate of Completion by: Wesley Sparks R.S. date 6/23/00

Operation Permit by: Wesley Sparks RS. date 6/23/00

HEALTH DEPT. COPY: WHITE INSPECTION COPY (FINAL): GREEN OWNER COPY (FINAL): YELLOW INSPECTION COPY (INITIAL): PINK OWNER COPY (INITIAL): GOLD