IREDELL COUNTY HEALTH DEPARTMENT

STATESVILLE 704-878-5305 MOORESVILLE 704-664-5281

IMPROVEMENT PERMIT / AUTHORIZATION TO CONSTRUCT / OPERATION PERMIT / EXISTING SYSTEM INSPECTION

PERMIT# 078952 PIN# 4628428963 DATE 2/15/99

OWNER OR CONTRACTOR ABJ Construction PHONE: Business 664-4353 Home

ADDRESS 1184 Brawley School Rd Mooresville NC 28117

LOCATION 150 W. TR Pinnacle Shores, TL Plantation, At end

SUBDIVISION Pinnacle Shores BLOCK / SECTION 1B LOT 75 LOT AREA .93 SITE CLASS. P5 DESIGN FLOW 360 L.T.A.R. .3

Septic Tank: 1000 Gallons; STB 794 Date 12/23/00

Pump Tank: 1000 Gallons; PT 283 Date 12/29/00

Pump Make: GOULDS Model WE0 712H Serial No. G0034151

Nitrification Field: No Fields 1 Square Feet 600 Linear Feet 200

No Lines 40 50 Trench Width 36 Max Trench Bottom Depth 36 Gravel Depth N/A

☑ New System ☐ Repair System Type: I, II, III, IV, V, VI

System Description: 50% Redx / Pump PM / Panel

Repair System Description: Same

Maintenance Agreement Required: ☐ Yes ☐ No

☑ House/Mod. Home No. Bedrooms 3

☐ Mobile Home No. Bathrooms 3

☐ Business No. Employees

☐ Other


☐ Slab ☐ Crawl Space ☑ Basement w/plumbing ☐ Basement wo/plumbing

Water Supply: ☐ Individual ☐ Public ☑ Community


Comments/Conditions:
Keep 10' off PL w/ septic
Keep 5' off House w/septic
Stay 50' from Lake w/septic
Stay out of old Road cut w/septic

Comments/Conditions:
Keep out of Drive area w/septic
Use ductile Iron Pipe under Drive
Scale 1-50

INITIAL SITE SKETCH

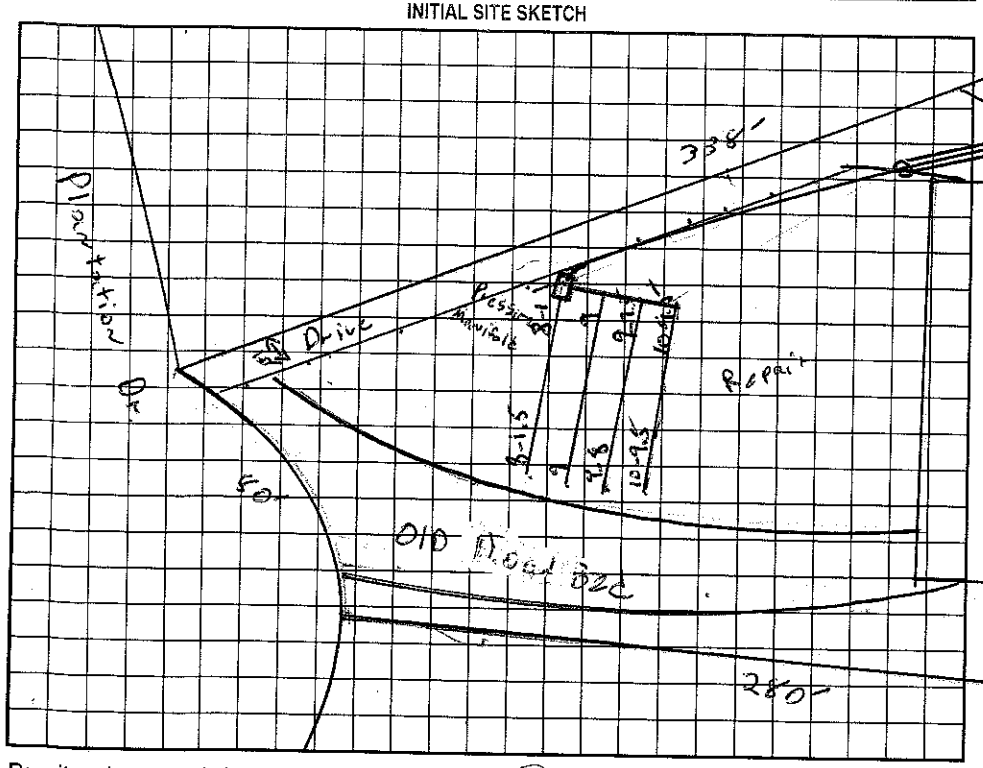

AS BUILT SKETCH

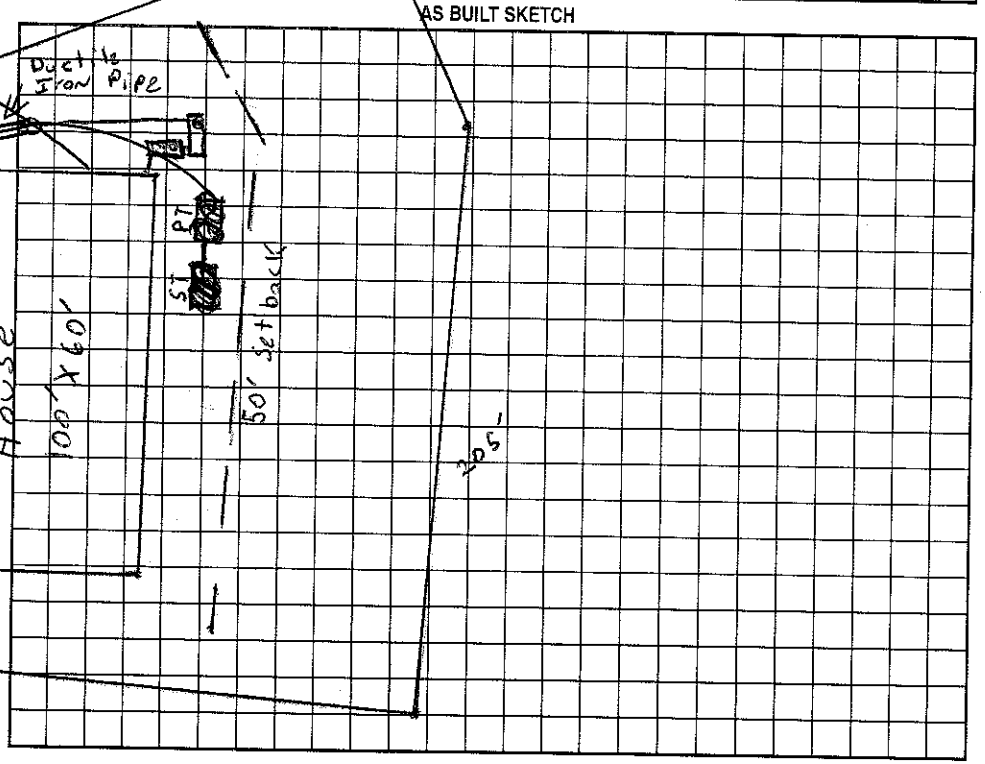

Permit can be suspended or revoked if any false information is supplied toward securing the permit/any unauthorized changes are made to the site/any unauthorized changes are made in the installation of the system. Improvement Permit with plat valid without expiration. Improvement Permit with site plan valid for sixty months. Authorization to Construct is valid for a period equal to that of Improvement Permit – not to exceed sixty months.

Signed: ABJ By [signature] date 2-16-99

Improvement Permit by: Jeff Morgan date 2/15/99

Authorization to Construct by: Jeff Morgan date 6-17-99

Installed by: F J Ervin

Operation Permit by: [signature] RSE date 5/14/01

Existing System Inspection by: date

HEALTH DEPT. COPY: WHITE OWNER COPY (FINAL): YELLOW OWNER COPY (INITIAL): PINK