IREDELL COUNTY HEALTH DEPARTMENT / Authorization to Construct

STATESVILLE 704-878-5305 MOORESVILLE 704-664-5281

IMPROVEMENT PERMIT / ~~CERTIFICATE OF COMPLETION~~ / OPERATION PERMIT / EXISTING SYSTEM INSPECTION

PROPERTY DESCRIPTION NO. 18698 DATE 12/19/95 TAX MAP NO. Pt of 2 N A 20 Watershed: [X] Yes [ ] No

OWNER OR CONTRACTOR Dennis Deaton PHONE: Business 4628429864 Home 663-3376

ADDRESS 701 White Oaks Mooresville, NC. 28115

LOCATION 1.50 W TR Pinnacle Shores Dr. TL on Plantation Ln. on (L) just before cul-de-sac

SUBDIVISION Pinnacle Shores BLOCK / SECTION I LOT 76 LOT AREA ~1.04 AC SITE CLASS. PS DESIGN FLOW 480 L.T.A.R. .3

Septic Tank: 1000 Gallons; STB 794 Date 4/22/97

Pump Tank: 1000 Gallons; PT 2A7 Date 4/22/97

Pump Make: _____ Model _____ Serial No. _____

Nitrification Field: No Fields 1 Square Feet _____ Linear Feet 400 ✱

No Lines 5 Trench Width 36" Max Trench Bottom Depth 36" Gravel Depth SAND

[X] New System [ ] Repair System Type: I, II, III, IV, V, VI

System Description: P. Manifold - Infiltrator

Repair System Description: 16" PPBS

Maintenance Agreement Required: [ ] Yes [X] No

[X] House/Mod. Home No. Bedrooms 4

[ ] Mobile Home No. Bathrooms 3

[ ] Business No. Employees _____

[ ] Other _____


[ ] Slab [ ] Crawl Space [X] Basement w/plumbing [ ] Basement wo/plumbing

Water Supply: [ ] Individual [X] Community [ ] Public


Comments: SAND FILL TO TOP OF LOWERS
5 @ 66' X 3' INFILTRATOR LINES OFF PRESSURE MANIFOLD.

Comments: Run Pump - Electronic - Alarm.

INITIAL SITE SKETCH

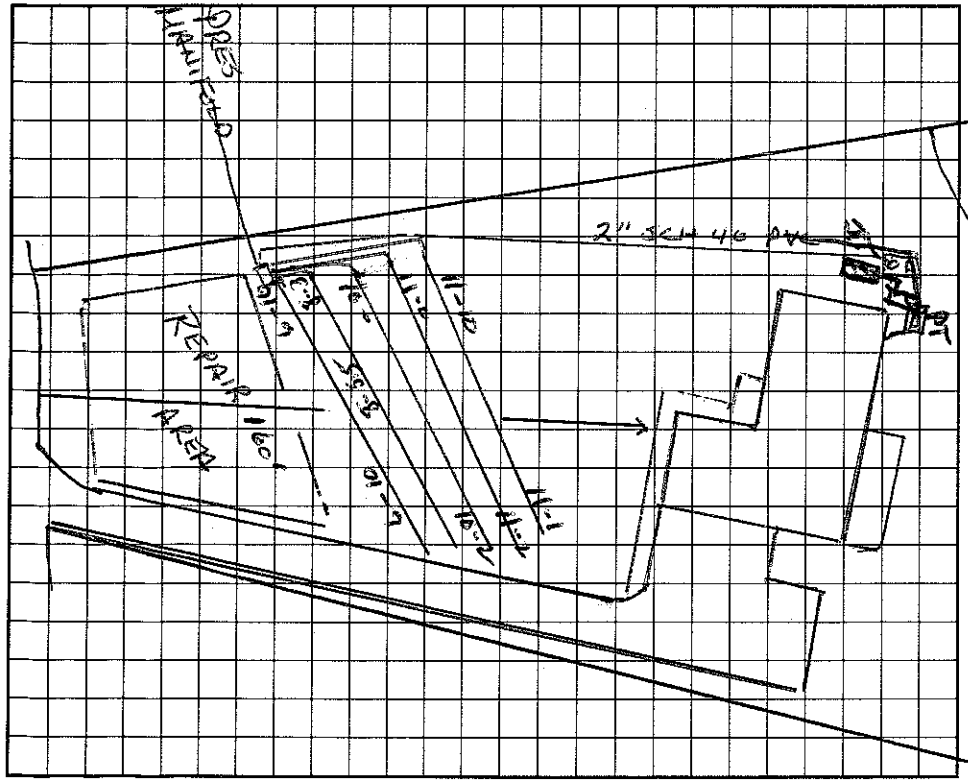

AS BUILT SKETCH

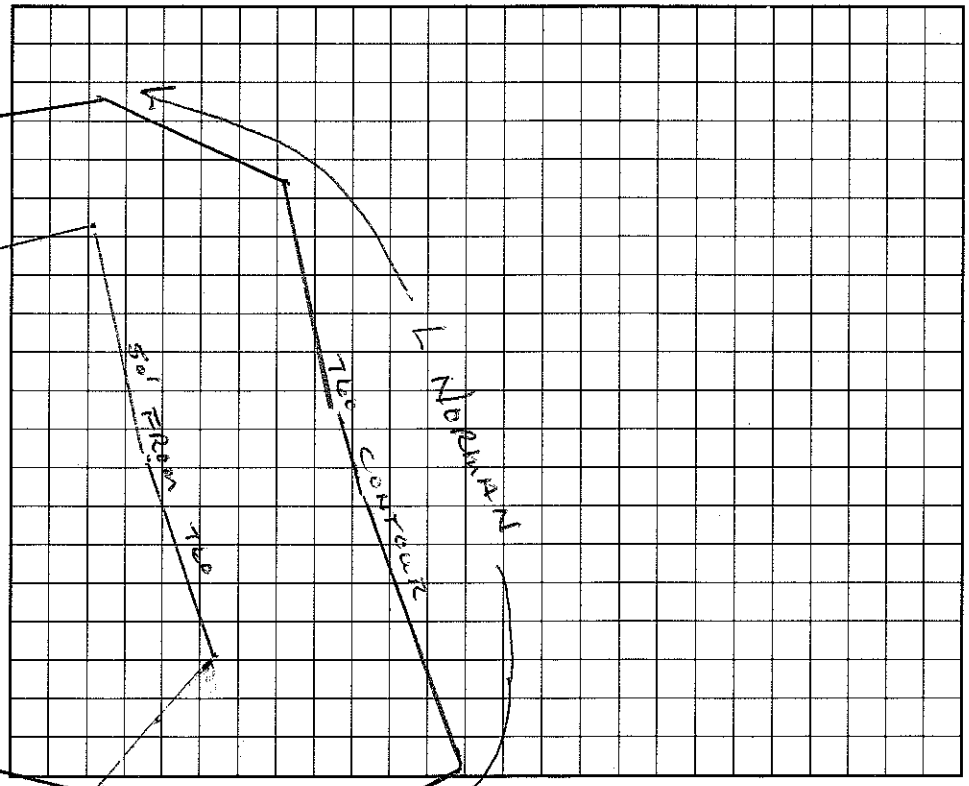

I understand that this permit can be suspended or revoked if any false information is supplied toward securing the permit/any unauthorized changes are made to the site/any unauthorized changes are made in the installation of the system.

Signed: Dennis Deaton

Improvement Permit by: Wesley Sparks R.S. date 12/19/95

Existing System Inspection by: ~~Contractor~~ Wesley Sparks R.S. date 12/19/95

Installed by: F. T. Ervin

Certificate of Completion by: Wesley Sparks R.S. date 8/13/97

Operation Permit by: Wesley Sparks R.S. date 8/13/97

HEALTH DEPT. COPY: WHITE INSPECTION COPY (FINAL): GREEN OWNER COPY (FINAL): YELLOW INSPECTION COPY (INITIAL): PINK OWNER COPY (INITIAL): GOLD