IREDELL COUNTY HEALTH DEPARTMENT

Statesville Office (704) 878-5305 RA Mooresville Office (704) 660-3625 PERMIT # 212535

IMPROVEMENT PERMIT / AUTHORIZATION TO CONSTRUCT / OPERATION PERMIT / EXISTING SYSTEM

PIN # 4628439109

APPLICANT: Charlotte Pools/James Toole APPLICANT ADDRESS: 1458 Brawley ~~Bel~~ School Rd Mooresville, NC 28117

SITE ADDRESS: 190 Plantation Dr Mooresville, NC 28117 PHONE: 704 799 7575 ALT. PHONE:

SITE DIRECTIONS: Hwy 150 W TR Pinnacle Shores TL Plantation Dr at end

SUBDIVISION: Pinnacle Shores SECTION: 1-B LOT # 72 LOT AREA: .610 DESIGN FLOW: 360gpd L.T.A.R.: .3

Existing

Septic Tank	1000 (gal)	STB	Date		
Pump Tank	1000 (gal)	PT	Date		
Pump Make		Model	Serial #		
# Nitrification Fields	1	# Lines	3	Linear Ft:	210
Trench Width	36"	Max. Trench Bottom Depth	30"	Gravel Depth	N/A

☐ New System ☐ Repair ☐ Expansion System Type: I II III (IV) V VI

System Description: Exist. LP Panel Block

Repair System Description: Same

Maintenance Agreement Required: ☒ YES ☐ NO

☐ GRAVITY ☒ PRESSURE

☐ Residence No. Bedrooms ☐ Business No. Persons ☐ Other No. Employees ☐ Slab ☐ Crawl Space ☒ Basement w/plumbing ☐ Basement w/o plumbing


Water Supply: ☐ Private ☑ Public ☒ Community

Comments / Conditions:

The proposed inground pool does not appear to impact the existing Septic System.

*Must keep pool "cut" at least 15FT from Septic.

INITIAL SITE SKETCH

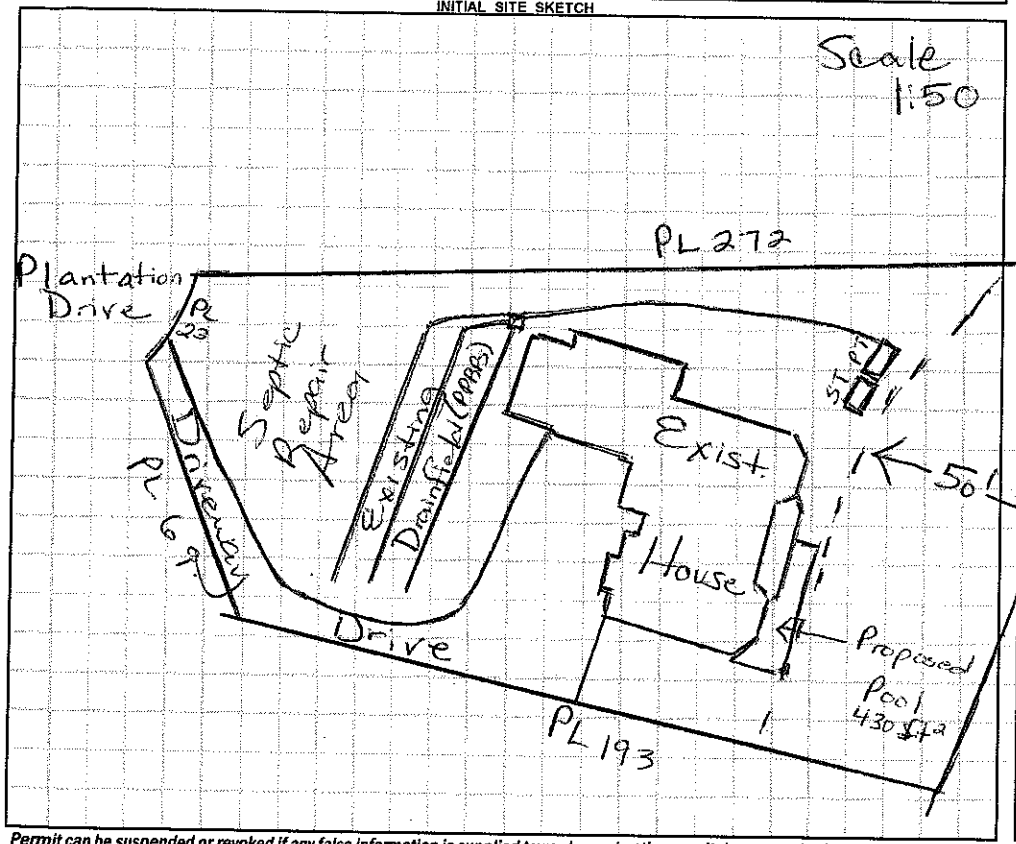

AS BUILT SKETCH

Permit can be suspended or revoked if any false information is supplied toward securing the permit / any unauthorized changes are made to the site / any unauthorized changes are made in the installation of the system. **CONTACT A LOCATOR SERVICE PRIOR TO ANY EXCAVATION**

☐ **IMPROVEMENT PERMIT *with plat*** *valid without expiration.* ☐ **IMPROVEMENT PERMIT *with site plan*** *valid for 60 mos.* ☐ **AUTHORIZATION TO CONSTRUCT** *valid for period equal to IMPROVEMENT PERMIT--not to exceed 60 mo.*

Owner / Applicant Signature: Colleen A Hoppo Date: 10-1-15 Installed by:

IMPROVEMENT PERMIT by: Date: OPERATION PERMIT by: Date:

AUTHORIZATION TO CONSTRUCT by: Date: Existing System Inspected by: Maria H Dotson RS Date: 9/28/15

Health Dept. Copy - WHITE Applicant (Final Approval) - YELLOW Applicant (Conditional Approval) - PINK