(9:30) 1:00

IREDELL COUNTY HEALTH DEPARTMENT Cons. Auth. - STATESVILLE 704-878-5305 MOORESVILLE 704-664-5281

IMPROVEMENT PERMIT / ~~CERTIFICATE OF COMPLETION~~ / OPERATION PERMIT / EXISTING SYSTEM INSPECTION

PROPERTY DESCRIPTION NO. 2-2063 DATE July 18, '96 TAX MAP NO. part of 2NA20 4628-43-9297 Watershed: ☑ Yes ☐ No

OWNER OR CONTRACTOR Kamal Daoud PHONE: Business _____ Home 770-924-6856

ADDRESS 2325 East Cherokee Dr. Woodstock GA 30188

LOCATION 150 W TR Pinnacle Shores Dr. TL Plantation Dr. on Right in cul-d-sac

SUBDIVISION Pinnacle Shores BLOCK / SECTION 1 LOT 71, 71A LOT AREA ~3/4 ac SITE CLASS. B per 1996 DESIGN FLOW 480 gpd L.T.A.R. .3

Septic Tank: 1000 Gallons; STB 794 Date 8/05/97

Pump Tank: 1000 Gallons; PT 27 Date 10/5/97

Pump Make: ~~Hydromatic~~ Model SK50A1 Serial No. 9797

Nitrification Field: No Fields 1 Square Feet 540 Linear Feet 280

No Lines 6 Trench Width 24" Max Trench Bottom Depth ~30" Gravel Depth NA

☑ New System ☐ Repair System Type: I, II, III, IV, V, VI

System Description: LP Panel Block

Repair System Description: pumped & vented - Lot 71A

Maintenance Agreement Required: ☑ Yes ☐ No

☑ House/Mod. Home No. Bedrooms 4

☐ Mobile Home No. Bathrooms 4

☐ Business No. Employees ____

☐ Other ____

☑ Slab ☑ Crawl Space ☑ Basement w/plumbing ☐ Basement wo/plumbing


Water Supply:
☐ Individual
☑ Community
☐ Public

Comments:


Comments: PARTIAL LOWER 3 TRENCHES

1"=50'

INITIAL SITE SKETCH

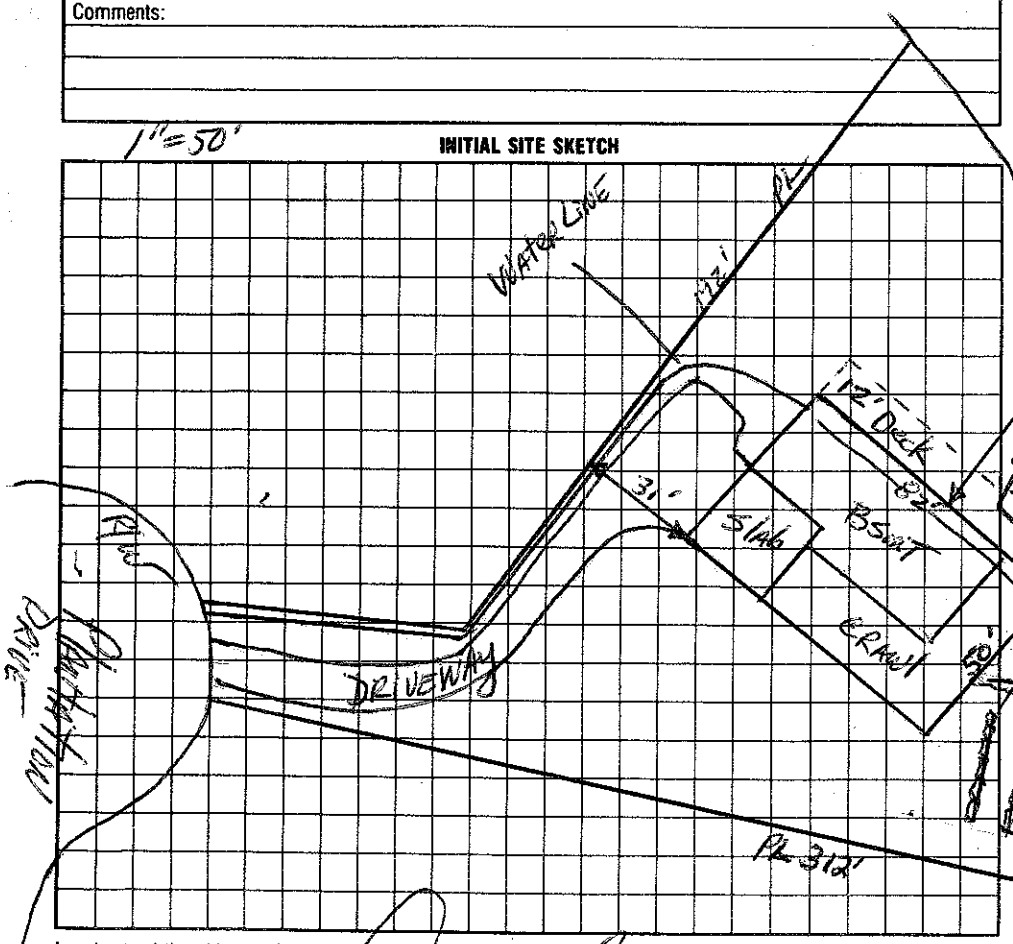

AS BUILT SKETCH

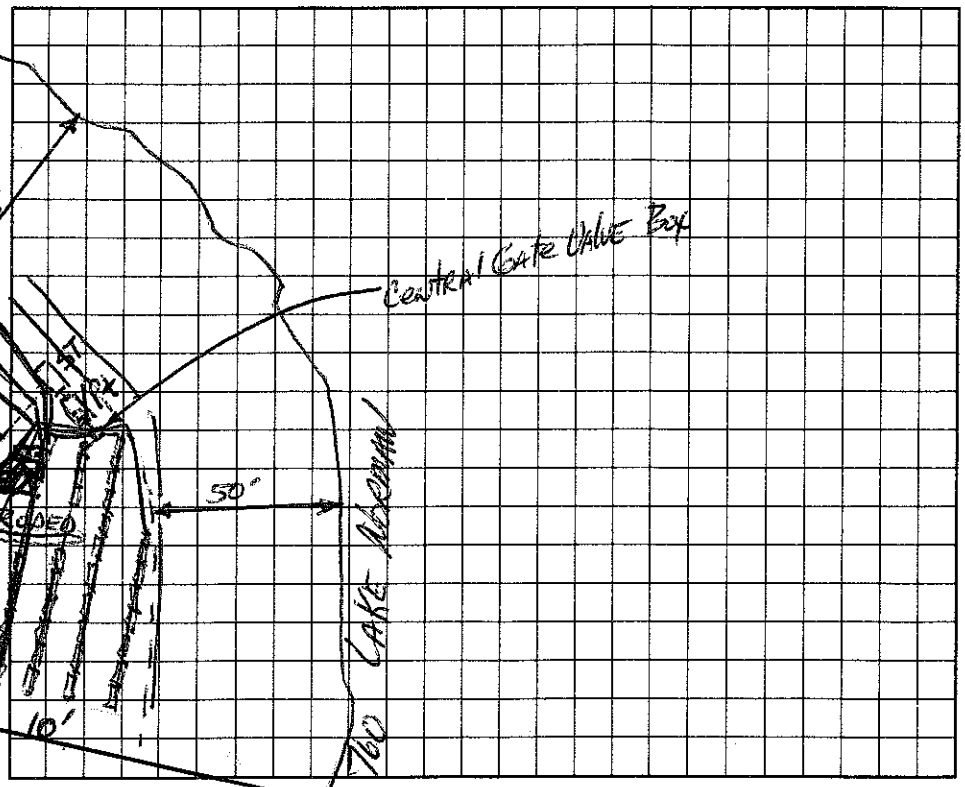

I understand that this permit can be suspended or revoked if any false information is supplied toward securing the permit/any unauthorized changes are made to the site/any unauthorized changes are made in the installation of the system.

Signed: Kamal Daoud

Improvement Permit by: [signature] R.S. date 7-18-96

~~Existing System Inspection by:~~ Authorization to Construct: [signature] R.S. date 7-18-96

Installed by: TIM AMMONS

Certificate of Completion by: Wesley Sparks R.S. date 4/23/98

Operation Permit by: Wesley Sparks R.S. date 4/23/98

HEALTH DEPT. COPY: WHITE INSPECTION COPY (FINAL): GREEN OWNER COPY (FINAL): YELLOW INSPECTION COPY (INITIAL): PINK OWNER COPY (INITIAL): GOLD