IREDELL COUNTY HEALTH DEPARTMENT

STATESVILLE 704-8 | 130.00 Paid | MOORESVILLE 704-664-5281

IMPROVEMENT PERMIT / AUTHORIZATION TO CONSTRUCT / OPERATION PERMIT / EXISTING SYSTEM INSPECTION

PERMIT# 121777 Leastone Builders PIN# 4628-50-2389 DATE 8/26/04

OWNER OR CONTRACTOR ~~Precision Custom Homes~~/Brian Johnston PHONE: Business _____ Home _____

ADDRESS 19422 Mota Rd Cornelius NC 28031

LOCATION 150 w, TL High Hills Dr. , on Lt

SUBDIVISION Pinnacle Shores BLOCK / SECTION 4 LOT 36 LOT AREA 25,661 Ft² SITE CLASS. PS DESIGN FLOW 480 L.T.A.R. 0.3

Septic Tank: 1000 Gallons; STB 3.12 Date 12/2/04
Pump Tank: _____ Gallons; PT _____ Date _____
Pump Make: _____ Model _____ Serial No. _____
Nitrification Field: No Fields 1 Square Feet 1200 Linear Feet 400'
No Lines 6@67' Trench Width 36" Max Trench Bottom Depth 36" Gravel Depth —

☒ New System ☐ Repair System Type: I, II, (III), IV, V, VI
System Description: Gravity 25% Reduct.
Repair System Description: LP panel Block
Maintenance Agreement Required: ☐ Yes ☒ No

☒ House/Mod. Home ☐ Mobile Home ☐ Business ☐ Other
No. Bedrooms 4 No. Bathrooms 3.5 No. Employees ____


☐ Slab ☐ Crawl Space ☒ Basement w/plumbing ☐ Basement wo/plumbing

Water Supply: ☐ Individual ☐ Public ☒ Community


Comments:/Conditions:

Comments:/Conditions:

INITIAL SITE SKETCH

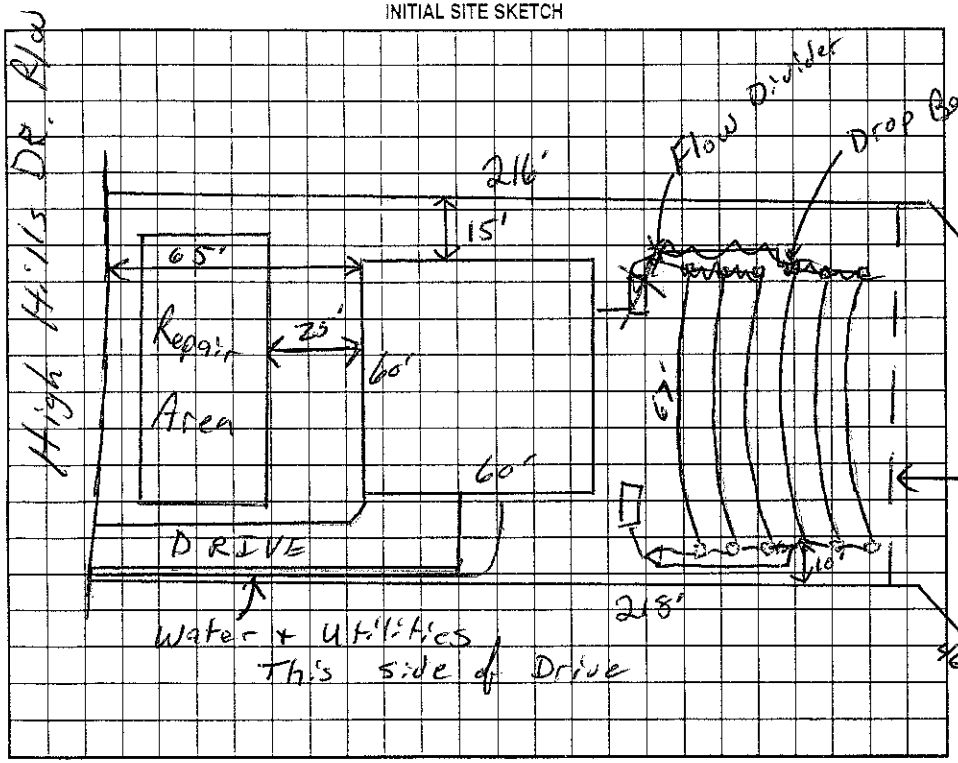

AS BUILT SKETCH

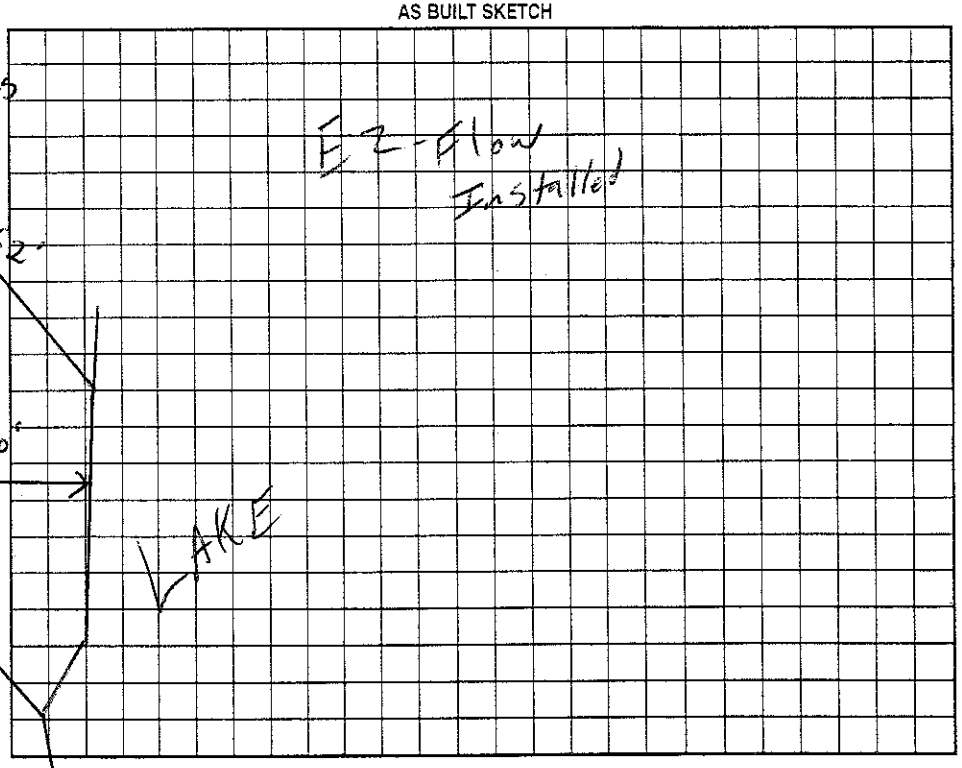

Permit can be suspended or revoked if any false information is supplied toward securing the permit/any unauthorized changes are made to the site/any unauthorized changes are made in the installation of the system. Improvement Permit with plat valid without expiration. Improvement Permit with site plan valid for sixty months. Authorization to Construct is valid for a period equal to that of Improvement Permit – not to exceed sixty months.

Signed: M. Johnston date 8/27/04 Installed by: Reid Eudy

Improvement Permit by: RS date 8/26/04 Operation Permit by: RS date 11/27/05

Authorization to Construct by: RS date 8/26/04 Existing System Inspection by: _____ date _____

HEALTH DEPT. COPY: WHITE OWNER COPY (FINAL): YELLOW OWNER COPY (INITIAL): PINK