IREDELL COUNTY HEALTH DEPARTMENT

Authorization to Construct (3:00)

STATESVILLE 704-878-5305 MOORESVILLE 704-664-5281

IMPROVEMENT PERMIT / ~~CERTIFICATE OF COMPLETION~~ / OPERATION PERMIT / EXISTING SYSTEM INSPECTION

PROPERTY DESCRIPTION NO. 22642 DATE 3/28/96 TAX MAP NO. 2N-8-A-97 Watershed: ☑ Yes ☐ No

OWNER OR CONTRACTOR Roger Hayes PHONE: Business _____ Home 910-668-3384

ADDRESS 4012 Benvenue Dr. Greensboro NC 27410 4628-51-3997

LOCATION Hwy 150 W - TR Pinnacle Stores Dr. TL old Timber Ln - at end of cul-de-sac on left

SUBDIVISION Pinnacle Stores BLOCK / SECTION #1 LOT 97 LOT AREA 276x245x60 SITE CLASS PS DESIGN FLOW 360gpd L.T.A.R. = 3gpd/ft²

Septic Tank: 1000 Gallons; STB 794 Date 3/13/96

Pump Tank: _____ Gallons; PT _____ Date _____

Pump Make: _____ Model _____ Serial No. _____

Nitrification Field: No Fields 1 Square Feet 1200 Linear Feet 400

No Lines 5 Trench Width 36" Max Trench Bottom Depth 36" Gravel Depth 12"

☑ New System ☐ Repair System Type: ☐ I ☐ II ☐ III ☐ IV ☐ V ☐ VI

System Description: Gravity Conventional

Repair System Description: ~~Gravity Chamber~~ PANEL

Maintenance Agreement Required: ☐ Yes ☑ No

☑ House/Mod. Home No. Bedrooms 3

☐ Mobile Home No. Bathrooms 3.5

☐ Business No. Employees _____

☐ Other _____


☐ Slab ☑ Crawl Space ☐ Basement w/plumbing ☐ Basement wo/plumbing

Water Supply: ☐ Individual ☐ Community ☑ Public

Comments:

Comments:

INITIAL SITE SKETCH

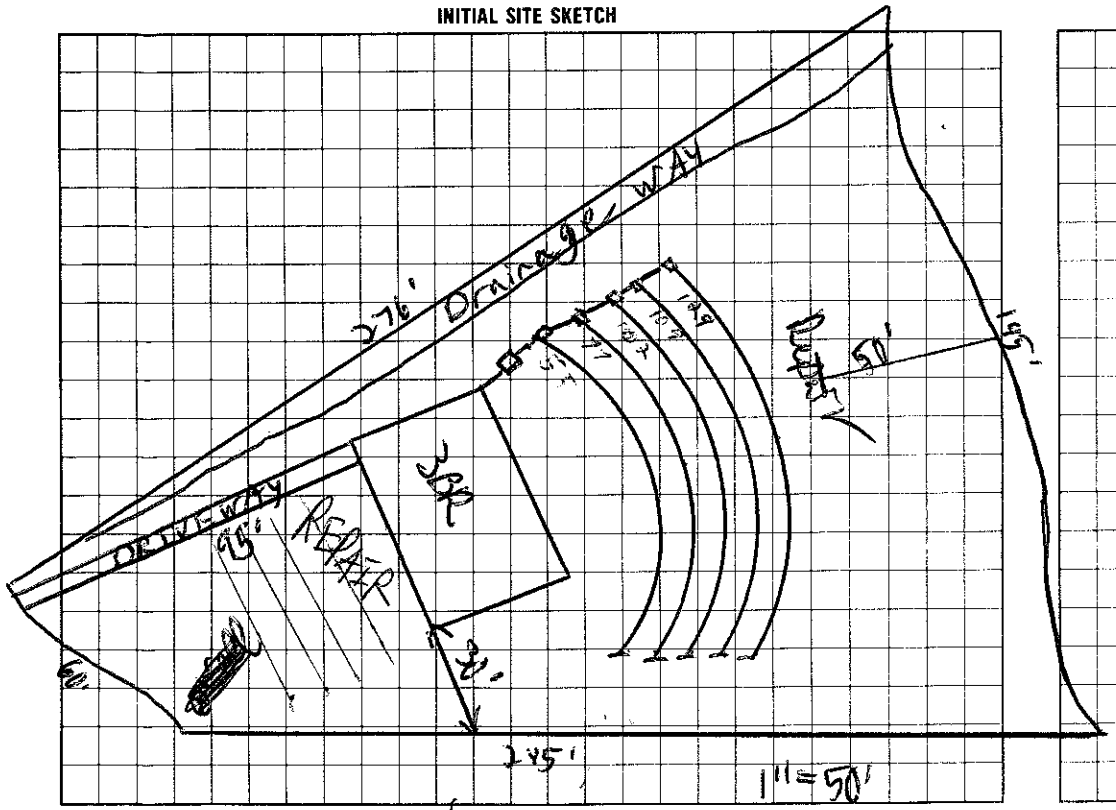

AS BUILT SKETCH

I understand that this permit can be suspended or revoked if any false information is supplied toward securing the permit/any unauthorized changes are made to the site/any unauthorized changes are made in the installation of the system.

Signed: Charles Humphrey

Permit by: C. Bobby Freeman EHST date 3/28/96

Bobby Freeman EHST date 3/28/96

Installed by: TIM AMMONS

Certificate of Completion by: _____ date _____

Operation Permit by: C. Bobby Freeman EHST date 10/23/96

INSPECTION COPY (FINAL): GREEN OWNER COPY (FINAL): YELLOW INSPECTION COPY (INITIAL): PINK OWNER COPY (INITIAL): GOLD

valid for 60 months from date of issue.