IREDELL COUNTY HEALTH DEPARTMENT

→ Authorization to Construct 3:30-4:00

STATESVILLE 704-878-5305 MOORESVILLE 704-664-5281

IMPROVEMENT PERMIT / ~~CERTIFICATE OF COMPLETION~~ / OPERATION PERMIT / EXISTING SYSTEM INSPECTION

PROPERTY DESCRIPTION NO. 24068 DATE 6/21/96 TAX MAP NO. 2N-8-A-98 Watershed: ☑ Yes ☐ No

OWNER OR CONTRACTOR Charles Beaty Jr PHONE: Business 4628-51-4743 Home 896-7721

ADDRESS 17.320 Hwy 73 West Cornelius NC

LOCATION #123 Timber Ln – 150 W - TR Pinnacle Shores Dr. - T L Old Timber Ln Lot on Left

SUBDIVISION Pinnacle Shores BLOCK / SECTION 1 LOT 19 LOT AREA SITE CLASS. PS DESIGN FLOW 300gpd L.T.A.R. .3gpd/ft²

Septic Tank: 1000 Gallons; STB 794 Date 3/5/97

Pump Tank: 1000 Gallons; PT 27 Date 3/24/97

Pump Make: Bowles Model WEC511H Serial No C9718694

Nitrification Field: No Fields 1 Square Feet 900 Linear Feet 300

No Lines 5 Trench Width 36" Max Trench Bottom Depth 34"-36" Gravel Depth N/A

☑ New System ☐ Repair System Type: I, II, III, IV, V, VI

System Description: Gravity Chambered

Repair System Description: LPP

Maintenance Agreement Required: ☐ Yes ☑ No

☑ House/Mod. Home No. Bedrooms 3

☐ Mobile Home No. Bathrooms 2

☐ Business No. Employees

☐ Other


☐ Slab ☐ Crawl Space ☑ Basement w/plumbing ☐ Basement wo/plumbing

Water Supply: ☐ Individual ☑ Community ☐ Public


Comments: W30712BE - D9708039

Comments: 300 / .8 / 180 .in / 120 Rose - 6" Orenbeans.

INITIAL SITE SKETCH

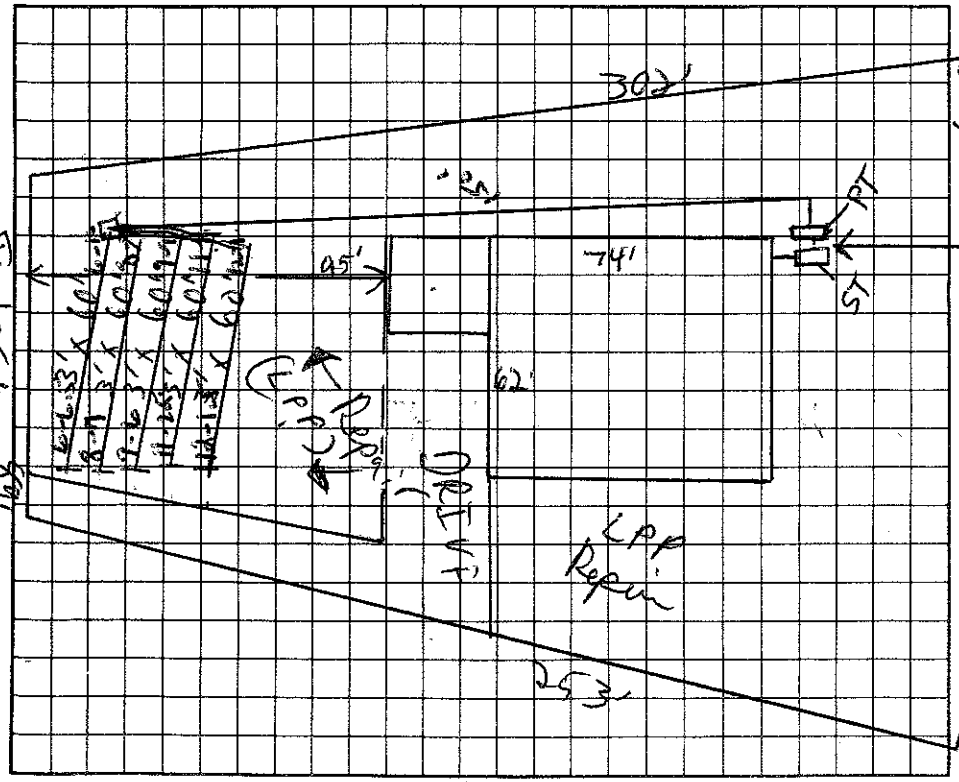

AS BUILT SKETCH

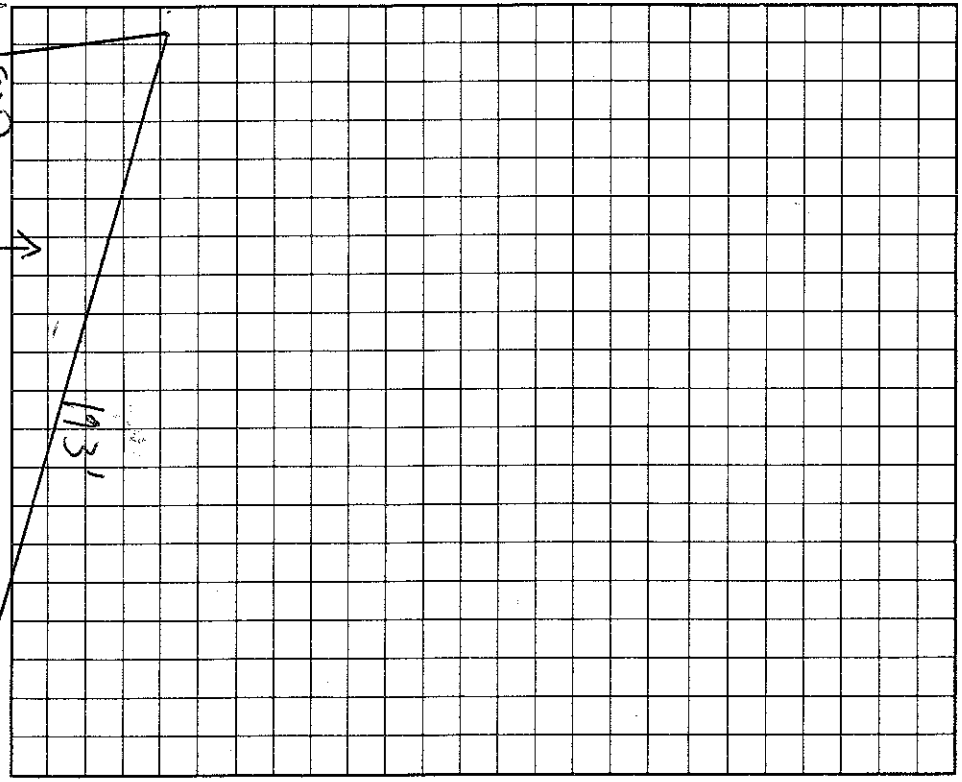

I understand that this permit can be suspended or revoked if any false information is supplied toward securing the permit/any unauthorized changes are made to the site/any unauthorized changes are made in the installation of the system.

Signed: C. Beaty

Improvement Permit by: C. Beaty Jr EHST date 6/21/96

Existing System Inspection by: C. Beaty Jr EHST date 6/21/96

Installed by: Cornelius Grading

Certificate of Completion by: Wesley Sparks RS. date 7/28/97

Operation Permit by: Wesley Sparks RS date 7/28/97

HEALTH DEPT. COPY: WHITE INSPECTION COPY (FINAL): GREEN OWNER COPY (FINAL): YELLOW INSPECTION COPY (INITIAL): PINK OWNER COPY (INITIAL): GOLD