# IREDELL COUNTY HEALTH DEPARTMENT

STATESVILLE 704-878-5305 MOORESVILLE 704-664-5281

## IMPROVEMENT PERMIT / CERTIFICATE OF COMPLETION / OPERATION PERMIT / EXISTING SYSTEM INSPECTION

2=

PROPERTY DESCRIPTION NO. 22480 DATE Dec 29, '95 TAX MAP NO. 2N8A100 Watershed: ☑ Yes ☐ No

OWNER OR CONTRACTOR Brian C. Huss PHONE: Business Home 4628-51-5623

ADDRESS 1628 Smith Farm Rd. Lincolnton 28092 WS4CA

LOCATION 150' W JR Pinnacle Shores Dr. TL Old Timber Ln. on left

SUBDIVISION Pinnacle Shores BLOCK / SECTION 1 LOT 100 LOT AREA > 20,000 ft² SITE CLASS. PS pre 1956 DESIGN FLOW 360 gpd L.T.A.R. .3

Septic Tank: 1000 Gallons; STB 1012 Date 1/17/97

Pump Tank: _____ Gallons; PT _____ Date _____

Pump Make: _____ Model _____ Serial No. _____

Nitrification Field: No Fields 1 Square Feet 900 Linear Feet 300

No Lines ~~4~~ 5 Trench Width 36" Max Trench Bottom Depth 36" Gravel Depth NA

☑ New System ☐ Repair System Type: I, II, (III), IV, V, VI

System Description: gravity Infiltrator

Repair System Description: pumped Infiltrator

Maintenance Agreement Required: ☐ Yes ☑ No

☑ House/Mod. Home No. Bedrooms 3

☐ Mobile Home No. Bathrooms 2.5

☐ Business No. Employees _____

☑ Other _____

☐ Slab ☐ Crawl Space ☑ Basement w/plumbing ☐ Basement wo/plumbing


Water Supply: ☐ Individual ☑ Community ☐ Public

Comments:


Comments: Drop boxes used - 5 lines instead of 4 lines.

1"=50'

INITIAL SITE SKETCH

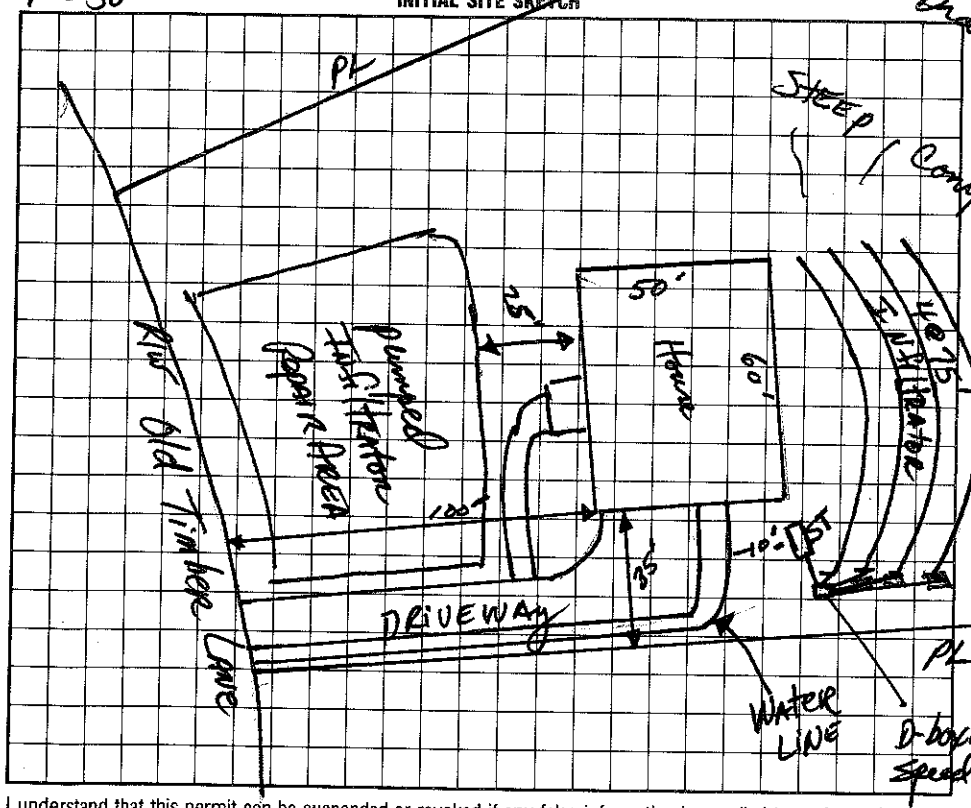


AS BUILT SKETCH

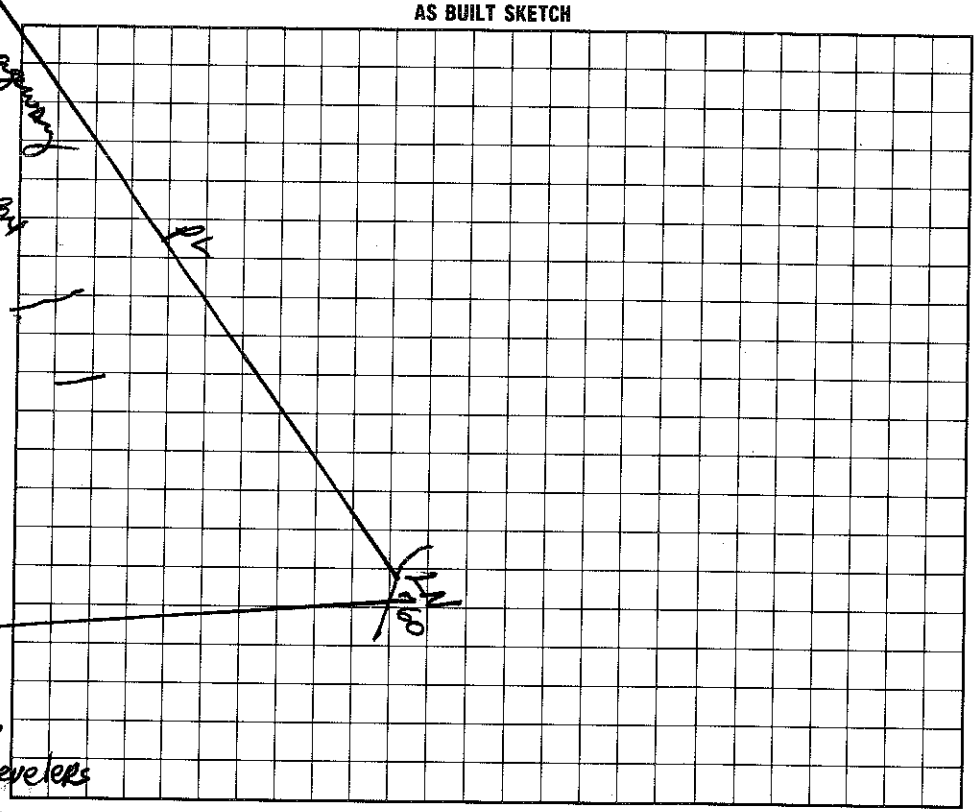


I understand that this permit can be suspended or revoked if any false information is supplied toward securing the permit/any unauthorized changes are made to the site/any unauthorized changes are made in the installation of the system.

Signed: Brian C. Huss 1/6/96

Improvement Permit by: DR Hinson, RS date 12-29-95

Existing System Inspection by: DR Hinson, RS date 12-29-95

Authorization to construct

Installed by: Barry Thompson

Certificate of Completion by: Wesley Sparks RS date 4/4/97

Operation Permit by: Wesley Sparks RS. date 4/4/97

HEALTH DEPT. COPY: WHITE INSPECTION COPY (FINAL): GREEN OWNER COPY (FINAL): YELLOW INSPECTION COPY (INITIAL): PINK OWNER COPY (INITIAL): GOLD