IREDELL COUNTY HEALTH DEPARTMENT

STATESVILLE 704-878-5305 MOORESVILLE 704-664-5281

IMPROVEMENT PERMIT / CERTIFICATE OF COMPLETION / OPERATION PERMIT / EXISTING SYSTEM INSPECTION

PROPERTY DESCRIPTION NO. 22067 DATE Sept. 28, '95 TAX MAP NO. part of 24420 4628-52-1681 Watershed: ☑ Yes ☐ No

OWNER OR CONTRACTOR Crescent Resources (for ABJ Const.) PHONE: Business _____ Home _____

ADDRESS PO Box 1003, Charlotte

LOCATION 150 W JR Pinnacle Stones Dr. JR Plantation Dr. on left

SUBDIVISION Pinnacle Stones BLOCK / SECTION 16 LOT 78 LOT AREA = 20,100 ft² SITE CLASS. B per 1996 DESIGN FLOW 480 gpd L.T.A.R. .3

Septic Tank: 1000 Gallons; STB 794 Date 4/24/96

Pump Tank: 1000 Gallons; PT 27 Date 5/29/96

Pump Make: Gould's Model WE0511H Serial No. 18P2210 New

Nitrification Field: No Fields 1 Square Feet _____ Linear Feet 267

No Lines 4 Trench Width 24" Max Trench Bottom Depth 30" Gravel Depth N/A

☑ New System ☐ Repair System Type: I, II, III, IV, V, VI

System Description: LPPPBS

Repair System Description: LPPPBS

Maintenance Agreement Required: ☐ Yes ☐ No

☑ House/Mod. Home No. Bedrooms 3 4

☐ Mobile Home No. Bathrooms 2 2½

☐ Business No. Employees _____

☐ Other _____

☐ Slab ☑ Crawl Space ☑ Basement w/plumbing ☐ Basement wo/plumbing

Water Supply: ☐ Individual ☑ Community ☐ Public

Comments:

10/13/97 - 3 Bedroom house - 210 Feet of 16" PPBS

DEVELOPER PERMIT


F9844417

Comments: PARTIAL

1" = 50'

INITIAL SITE SKETCH

AS BUILT SKETCH

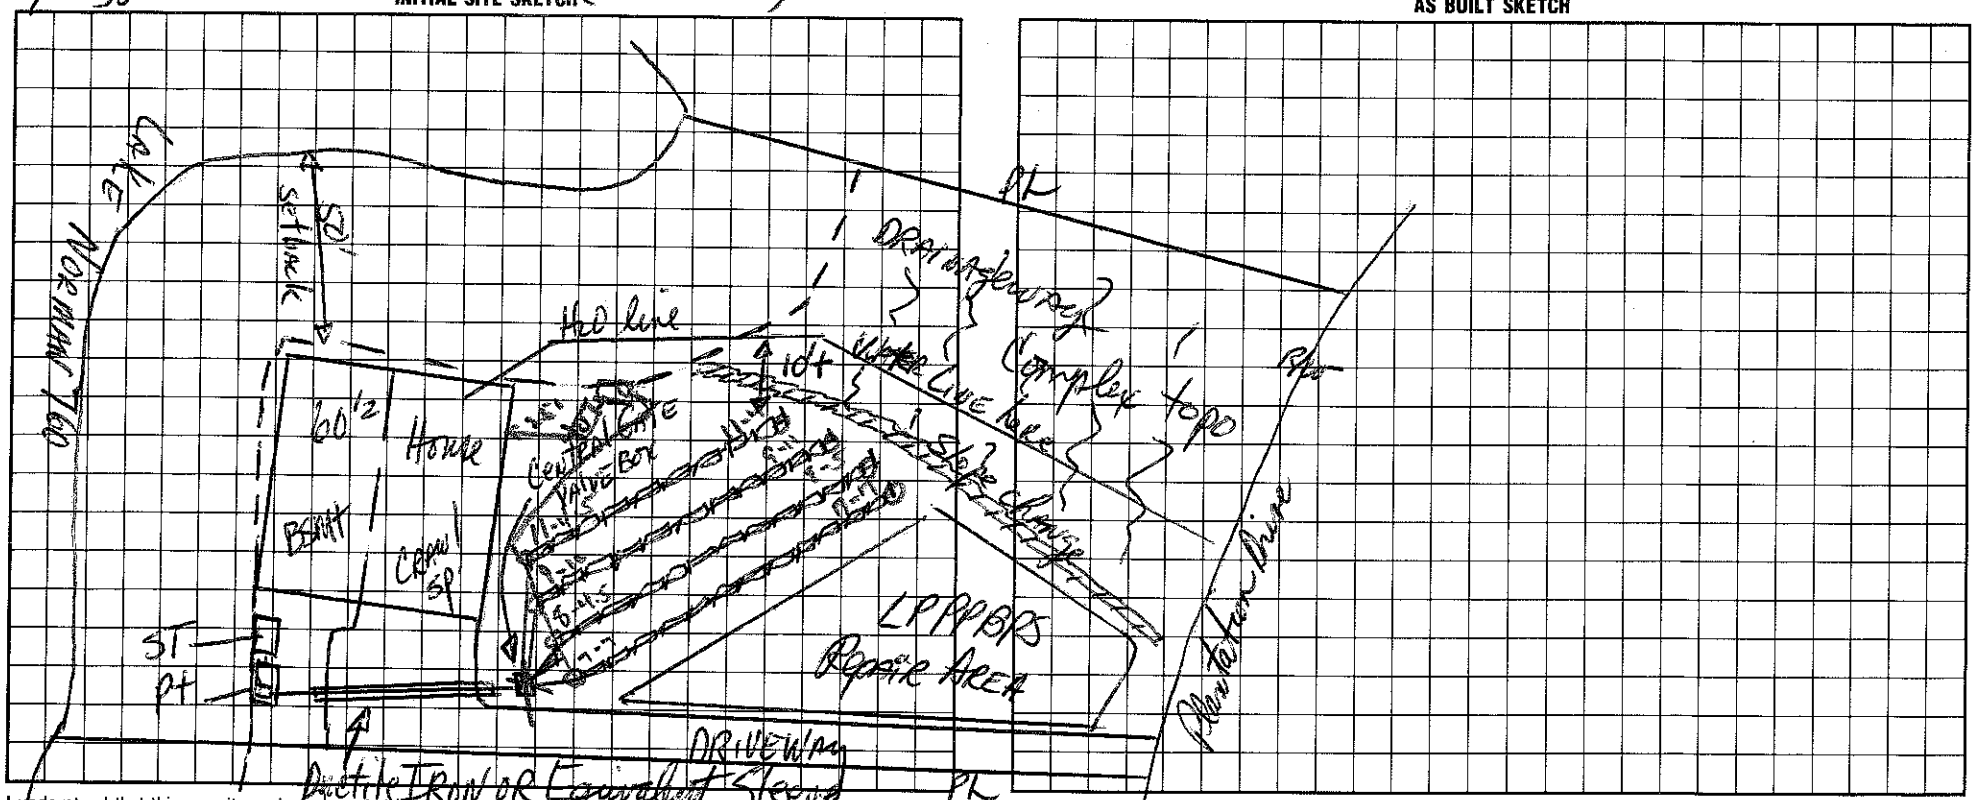

I understand that this permit can be suspended or revoked if any false information is supplied toward securing the permit/any unauthorized changes are made to the site/any unauthorized changes are made in the installation of the system.

Signed: _____

Improvement Permit by: Jerry R. Hanson, RS date 10/16/95

Existing System Inspection by: Wesley Sparks R.S. date 10/13/97

Installed by: FJ ERVIN

Certificate of Completion by: Wesley Sparks R.S. date 9-28-95

Operation Permit by: Wesley Sparks R.S.

HEALTH DEPT. COPY: WHITE INSPECTION COPY (FINAL): GREEN OWNER COPY (FINAL): YELLOW INSPECTION COPY (INITIAL): PINK OWNER CO