IREDELL COUNTY HEALTH DEPARTMENT

STATESVILLE 704-878-5305 $50.00 MOORESVILLE 704-664-5281

IMPROVEMENT PERMIT / AUTHORIZATION TO CONSTRUCT / OPERATION PERMIT / EXISTING SYSTEM INSPECTION

PERMIT# 133787 PIN# 4628521832 DATE 3-2-06

OWNER OR CONTRACTOR The Hoke Company / Charles Moore PHONE: Business 799-7495 Cell Home 201-0264

ADDRESS P.O. Box 4448 Mooresville NC 28117 Charles 301-8910

LOCATION Hwy 150 West TR Pinnacle Shores Dr TL Plantation ~1/4 mile on left

SUBDIVISION Pinnacle Shores BLOCK / SECTION 1 LOT 77 LOT AREA 1.08 Acre SITE CLASS. RS DESIGN FLOW 600gpd L.T.A.R. .3

Septic Tank: 1500 Gallons; STB 338 Date 11-20-06
Pump Tank: 1500 Gallons; PT 477 Date 12-3-06
Pump Make: Myers Model ME50 Serial No.
Nitrification Field: No. Fields 1 Square Feet 670' Linear Feet 330'
No. Lines 4 Trench Width 24" Minimum Trench Bottom Depth 36" Gravel Depth N/A


☒ New System ☐ Repair System Type: I, II, III, IV, V, VI
System Description: Pump-4-Panel Block
Repair System Description: Same
Maintenance Agreement Required: ☒ Yes ☐ No

☒ House/Mod. Home ☐ Mobile Home ☐ Business ☐ Other
No. Bedrooms 5 No. Bathrooms ___ No. Employees ___
☐ Slab ☐ Crawl Space ☒ Basement w/plumbing ☐ Basement wo/plumbing

Water Supply: ☐ Individual ☒ Public ☒ Community

Comments:/Conditions: Scale 1:50

INITIAL SITE SKETCH

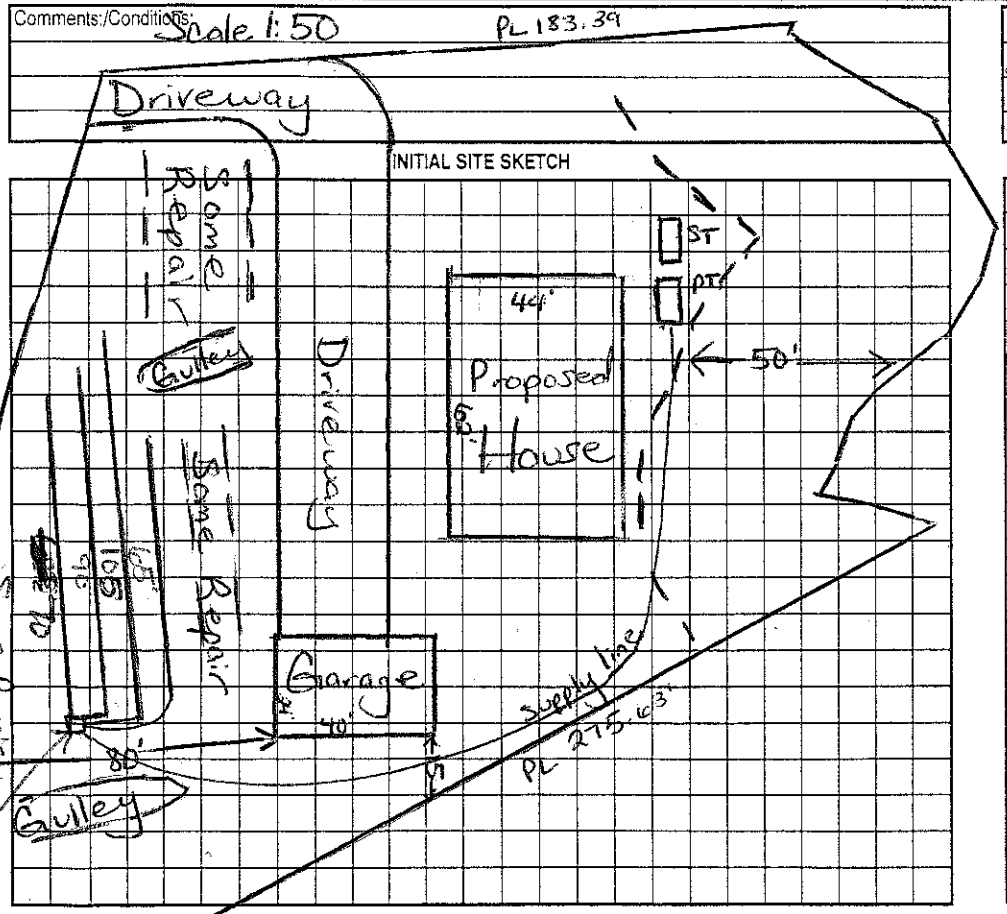

Comments:/Conditions: Note: Very tight lot be careful of setbacks. Do not move Garage any closer to road & do not cut down for drive. Stay 15' from Gullies unless "properly" filled.

AS BUILT SKETCH

Checked lines 7/27/06 MD
Lake (4Bd in Main House 1Bdrm over Garage)
Norman

Permit can be suspended or revoked if any false information is supplied toward securing the permit/any unauthorized changes are made to the site/any unauthorized changes are made in the installation of the system. Improvement Permit with plat valid without expiration. Improvement Permit with site plan valid for sixty months. Authorization to Construct is valid for a period equal to that of Improvement Permit – not to exceed sixty months.

Signed: [signature] date 3-10-06 Installed by: R&H

Improvement Permit by: Maria H. Dolson RS date 3/2/06 Operation Permit by: Maria H. Dolson date 4/24/07

Authorization to Construct by: Maria H. Dolson RS date 3/2/06 Existing System Inspection by: ___ date ___

HEALTH DEPT. COPY: WHITE OWNER COPY (FINAL): YELLOW OWNER COPY (INITIAL): PINK