IREDELL COUNTY HEALTH DEPARTMENT

STATESVILLE 704-878-5305

IMPROVEMENT PERMIT / CERTIFICATE OF COMPLETION / OPERATION PERMIT / EXISTING SYSTEM

PROPERTY DESCRIPTION NO. 22068 DATE Oct 2, 195 TAX MAP NO. part of 2444220 4628-52-2581 Watershed:

OWNER OR CONTRACTOR Crescent Resources Inc PETE WIRTH PHONE: Business 362-2411 Home

ADDRESS PO Box 1003 Charlotte

LOCATION 521 W JR Pinnacle Shores Drive TR Plantation Dr. on left

SUBDIVISION Pinnacle Shores BLOCK / SECTION 1B LOT 29 LOT AREA = 24,000 ft2 SITE CLASS. B per 1956 DESIGN FLOW 450 gpd L.T.A.R. .63

Septic Tank: 1000 Gallons; STB 794 Date 8/28/97

Pump Tank: 1000 Gallons; PT 27 Date 11/11/97

Pump Make: MYERS Model ME50S-1 Serial No. 997

Nitrification Field: No Fields 1 Square Feet 810 Linear Feet 270

No Lines 3@90' Trench Width 36" Max Trench Bottom Depth = 30" Gravel Depth NA

☑ New System ☐ Repair System Type: I, II, III, ☑ V, VI

System Description: LPPBPS

Repair System Description: Same

Maintenance Agreement Required: ☐ Yes ☐ No

☑ House/Mod. Home No. Bedrooms 4

☐ Mobile Home No. Bathrooms 4

☐ Business No. Employees

☐ Other

☐ Slab ☑ Crawl Space ☑ Basement w/plumbing ☐ Basement wo/plumbing

Water Supply: ☐ Individual ☑ Community ☐ Public


Comments:

Comments: PARTIAL


27 3 / 8 1 0

1" = 50'

INITIAL SITE SKETCH

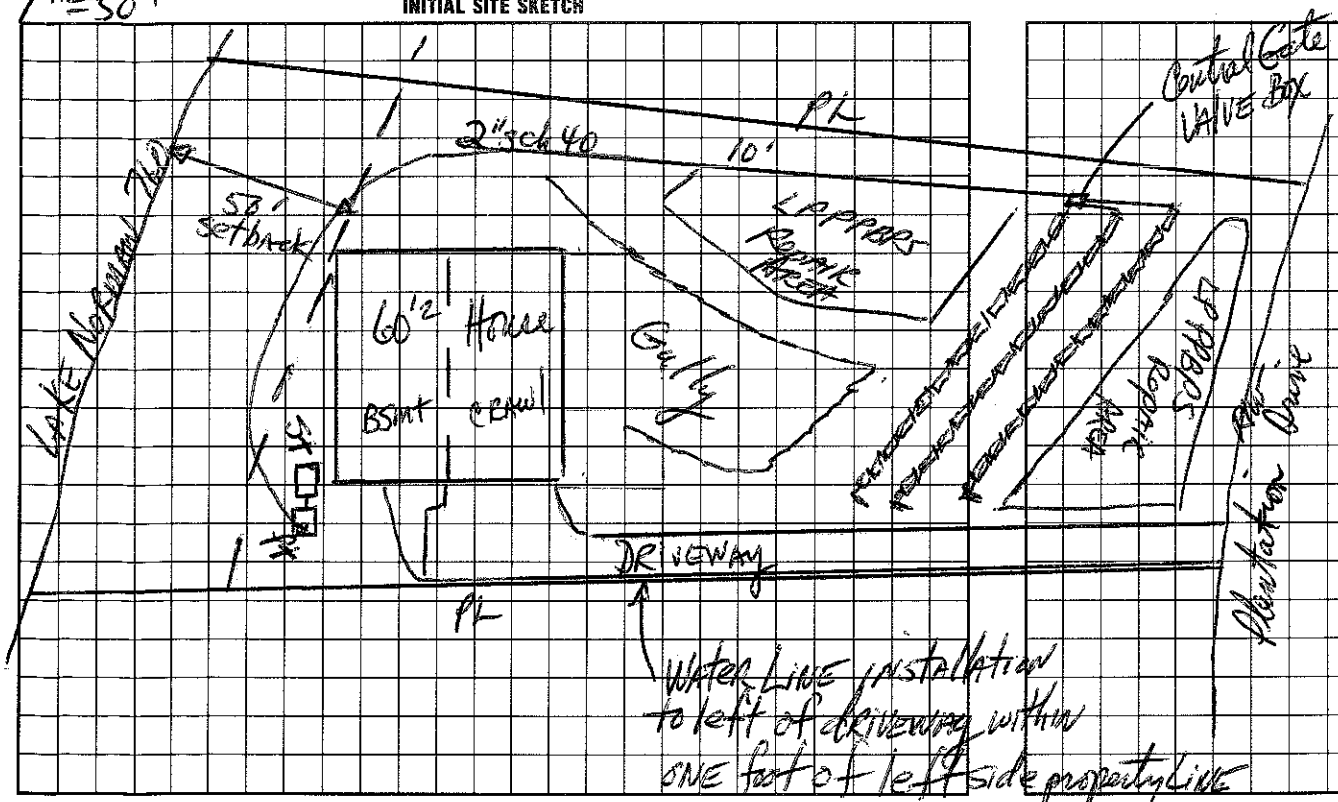

AS BUILT SKETCH

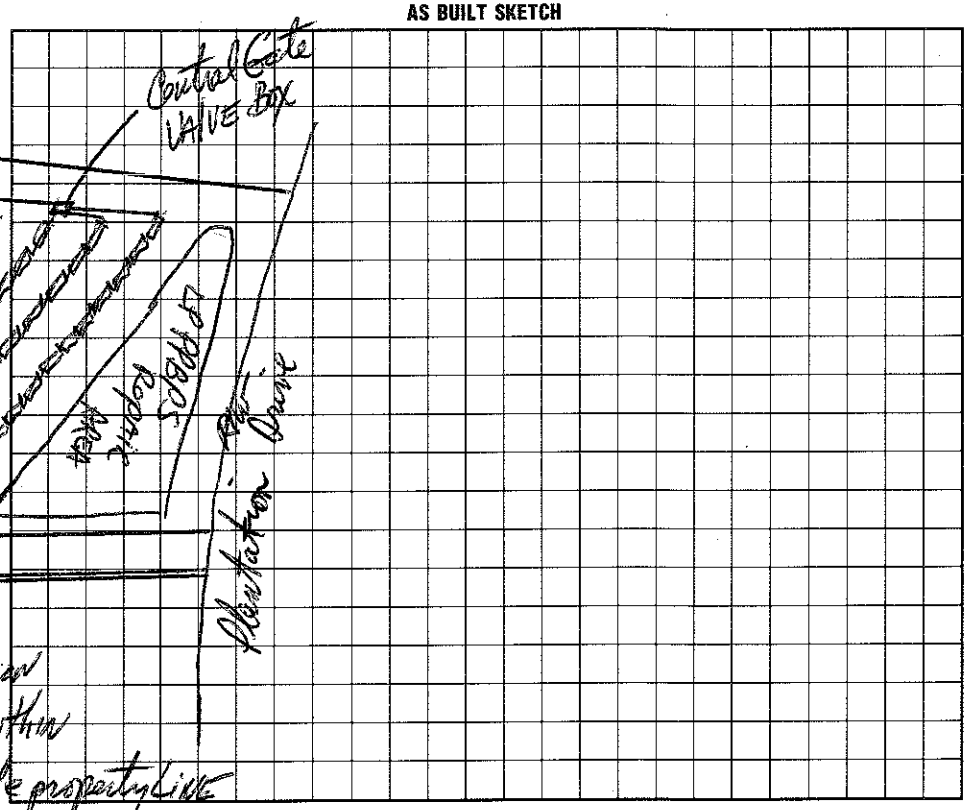

I understand that this permit can be suspended or revoked if any false information is supplied toward securing the permit/any unauthorized changes are made to the site/any unauthorized changes are made in the installation of the system.

Signed: [signature] CHS 10/15/95

Improvement Permit by: [signature] RS date 10/2/95

Auth. to Construct

Existing System Inspection by: Wesley Sparks RS. date 12/19/96

Installed by: Wayne Dobson

Certificate of Completion by: date

Operation Permit by: Wesley Sparks RS. date 1/28/98

HEALTH DEPT. COPY: WHITE INSPECTION COPY (FINAL): GREEN OWNER COPY (FINAL): YELLOW INSPECTION COPY (INITIAL): PINK OWNER COPY (INITIAL): GOLD