IREDELL COUNTY HEALTH DEPARTMENT

STATESVILLE 704-878-5305 100.00 Paid 4.00 MOORESVILLE 704-664-5281

IMPROVEMENT PERMIT / AUTHORIZATION TO CONSTRUCT / OPERATION PERMIT / EXISTING SYSTEM INSPECTION

PERMIT# 092373 PIN# 4628524056 DATE 1-10-2001

OWNER OR CONTRACTOR Randy & Abby Rutkai PHONE: Business Home 895-9186

ADDRESS 149 Pin Oak Dr. Mooresville, NC 28117

LOCATION Hwy 150 W TR Pinnacle Shores Dr. TL Old Timber at end

SUBDIVISION Pinnacle Shores BLOCK / SECTION 1 LOT 96 LOT AREA .7 Acre SITE CLASS PS DESIGN FLOW 360 gpd L.T.A.R. .3

Septic Tank: 1000 Gallons; STB 3/2 Date 1/19/01
Pump Tank: 1000 Gallons; PT 27 Date 6/11/01
Pump Make: Goulds Model WE05 1HP Serial No.
Nitrification Field: No Fields 1 Square Feet 630' Linear Feet 210'
No Lines 4 Trench Width 36" Max Trench Bottom Depth 30" Gravel Depth N/A

☒ New System ☐ Repair System Type: I, II, III, IV, V, VI
System Description: Pump-LP-Pavel BLK
Repair System Description: Same
Maintenance Agreement Required: ☒ Yes ☐ No


☒ House/Mod. Home ☐ Mobile Home ☐ Business ☐ Other
No. Bedrooms 3 No. Bathrooms 2.5 No. Employees
☐ Slab ☐ Crawl Space ☒ Basement w/plumbing ☐ Basement wo/plumbing

Water Supply: ☐ Individual ☒ Public ☒ Community

Comments:/Conditions: Keep Septic System at least 10' From PL & 50' From lake
☆ Keep Construction traffic off the Drainfield Areas & do Not Store Construction materials on drainfield.

Comments:/Conditions: Ends of lines (turnups) marked with valve boxes
Per Engy Used valve on each line instead of Central Gate Valve box

INITIAL SITE SKETCH Scale 1:40

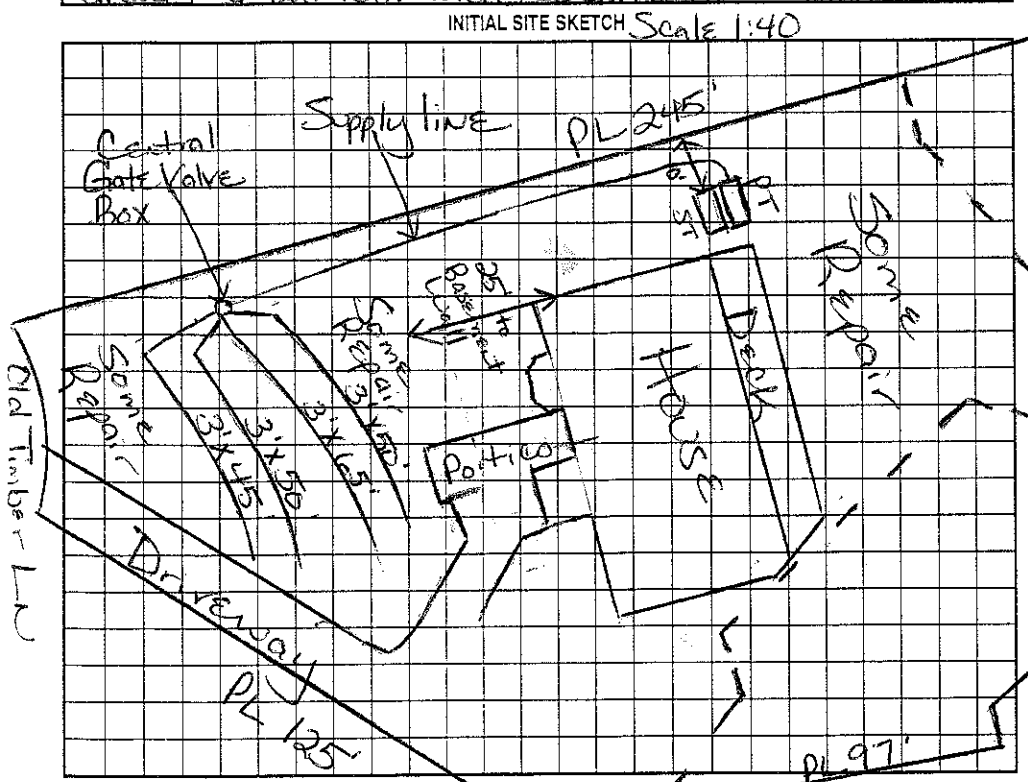

AS-BUILT SKETCH Tanks & lines Checked by GM 8/27/01 Pressure Checked by GM

Permit can be suspended or revoked if any false information is supplied toward securing the permit/any unauthorized changes are made to the site/any unauthorized changes are made in the installation of the system. Improvement Permit with plat valid without expiration. Improvement Permit with site plan valid for sixty months. Authorization to Construct is valid for a period equal to that of Improvement Permit – not to exceed sixty months.

Signed: date 1/12/2001 Installed by: Statesville Backhoe

Improvement Permit by: Maria H. Dotson RS. date 1/11/2001 Operation Permit by: Maria H. Dotson RS date 12/17/01

Authorization to Construct by: Maria H. Dotson RS date 1/11/2001 Existing System Inspection by: date

HEALTH DEPT. COPY: WHITE OWNER COPY (FINAL): YELLOW OWNER COPY (INITIAL): PINK