IREDELL COUNTY HEALTH DEPARTMENT

Authorization to Construct

STATESVILLE 704-878-5305 MOORESVILLE 704-664-5281

IMPROVEMENT PERMIT / CERTIFICATE OF COMPLETION / OPERATION PERMIT / EXISTING SYSTEM INSPECTION

PROPERTY DESCRIPTION NO. 068438 DATE 8/27/97 TAX MAP NO. 4628524753 Watershed: X Yes ☐ No

OWNER OR CONTRACTOR Barry R Kandra. JIM KISER PHONE: Business _____ Home _____

ADDRESS 141 Glenwood Ave Leonia NJ

LOCATION 150W TR Pinnacle Shores Tr Plantation Dr. lot on (R)

SUBDIVISION PINNACLE SHORES BLOCK / SECTION 1 LOT 66 LOT AREA .71 SITE CLASS. PS DESIGN FLOW 480 L.T.A.R. .3

Septic Tank: 1000 Gallons; STB 312 Date 1/12/01

Pump Tank: 1000 Gallons; PT 283 Date 1/19/01

Pump Make: HYDROMATIC Model SHEF 50A1 Serial No. 11/2/00

Nitrification Field: No Fields 1 Square Feet 630 Linear Feet # 210

No Lines 4 Trench Width 36" Max Trench Bottom Depth 36" Gravel Depth 3onl

☐ New System ☐ Repair System Type: I, II, III, (IV) V, VI

System Description: 16" PBS - Pressure

Repair System Description: Same

Maintenance Agreement Required: X Yes ☐ No

X House/Mod. Home No. Bedrooms 4

☐ Mobile Home No. Bathrooms 3

☐ Business No. Employees ____

☐ Other ____


X Slab ☐ Crawl Space X Basement w/plumbing ☐ Basement wo/plumbing

Water Supply: ☐ Individual X Community ☐ Public

Comments: Use 36" wide trenches - need extra sand!

Comments:

INITIAL SITE SKETCH

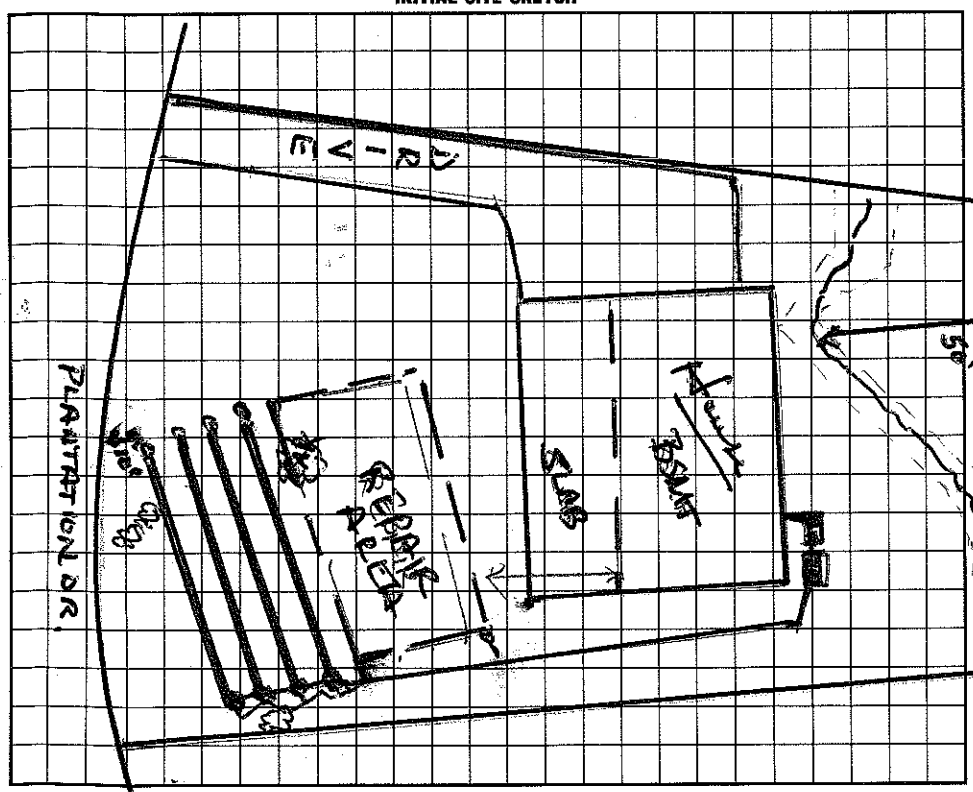

AS BUILT SKETCH

I understand that this permit can be suspended or revoked if any false information is supplied toward securing the permit/any unauthorized changes are made to the site/any unauthorized changes are made in the installation of the system. Improvement Permit is valid for 60 months from date of issuance.

Signed: X Suzanne Borrow

Improvement Permit by: Wesley Sparks RS. date 8/27/97

Authorization to Construct by: Wesley Sparks RS. date 8/27/97

Installed by: Curt Dunning

Certificate of Completion by: Wesley Sparks RS. date 4/19/01

Operation Permit by: Wesley Sparks RS date 4/19/01

HEALTH DEPT. COPY: WHITE INSPECTION COPY (FINAL): GREEN OWNER COPY (FINAL): YELLOW INSPECTION COPY (INITIAL): PINK OWNER COPY (INITIAL): GOLD