660-5736

IREDELL COUNTY HEALTH DEPARTMENT

Auth. to Construct

STATESVILLE 704-878-5305 MOORESVILLE 704-664-5281

IMPROVEMENT PERMIT / ~~CERTIFICATE OF COMPLETION~~ / OPERATION PERMIT / EXISTING SYSTEM INSPECTION

PROPERTY DESCRIPTION NO. 22073 DATE Oct. 4, 95 TAX MAP NO. part of 7824420 4628-52-5180 Watershed: ☑ Yes ☐ No

OWNER OR CONTRACTOR ~~Crescent Resources Corp~~ ARVIL PRICE PHONE: Business 568-6461 Home WS4

ADDRESS PO Box 1003, Charlotte 130 Robinson Charlotte, NC. 28215

LOCATION 150' W. TR Pinnacle Shores Dr. TR Old Timber at END

SUBDIVISION Pinnacle Shores BLOCK / SECTION 1B LOT 95 LOT AREA > 20,000 ft² SITE CLASS PS on 1956 DESIGN FLOW 480 gpd L.T.A.R. .3

Septic Tank: 1000 Gallons; STB 794 Date 9/27/95

Pump Tank: 1000 Gallons; PT 27 Date 11/4/95

Pump Make: ZOELLER Model 161H Serial No.

Nitrification Field: No Fields ___ Square Feet ___ Linear Feet 270

No Lines 3 Trench Width 24" Max Trench Bottom Depth ≈30" Gravel Depth NA

☑ New System ☐ Repair System Type: I, II, III, (IV), V, VI

System Description: LPPPBPS

Repair System Description: LPPPBPS

Maintenance Agreement Required: ☑ Yes ☐ No

☑ House/Mod. Home ☐ Mobile Home ☐ Business ☐ Other

No. Bedrooms 4/4 No. Bathrooms ___ No. Employees ___

☐ Slab ☑ Crawl Space ☑ Basement w/plumbing ☐ Basement wo/plumbing


Water Supply: ☐ Individual ☑ Community ☐ Public

Comments:

Comments: PARTIAL - checked Septic Tank and pump tank on 1-5-96, due to inability to install after home is built. MPO.

INITIAL SITE SKETCH

1" = 50'

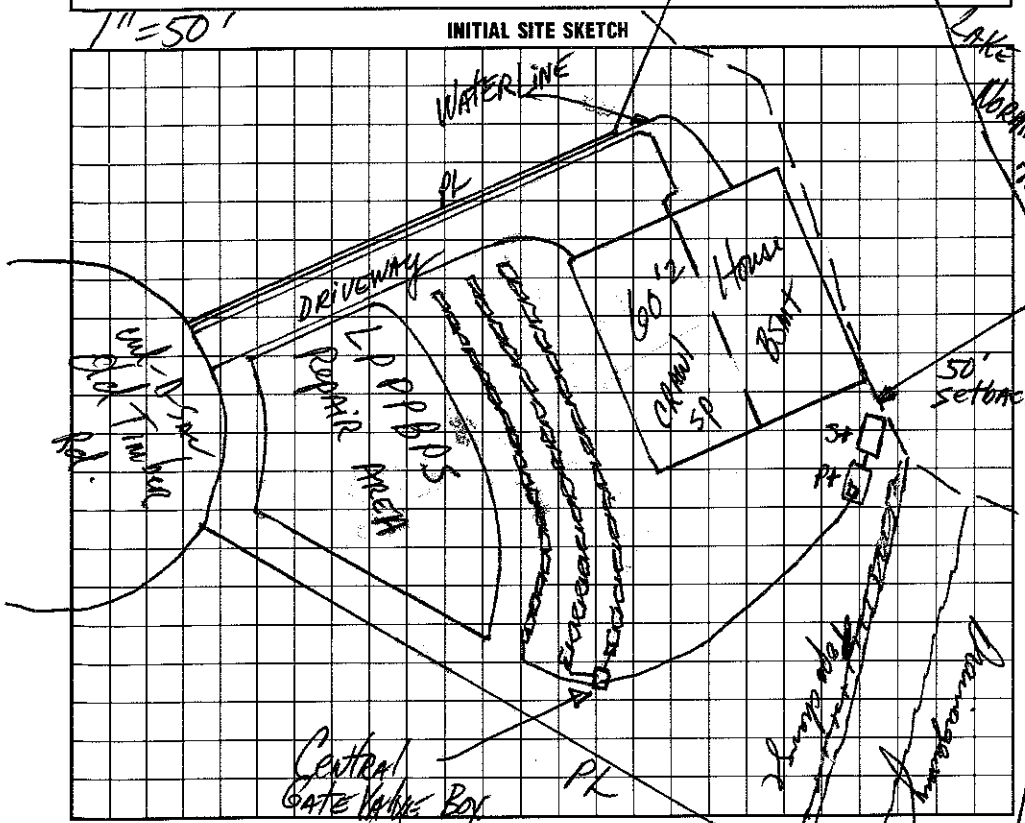

AS BUILT SKETCH

The proposed / existing 22'x16' Addition Living / Screen Porch addition does not appear to impact the existing septic system.

**NOTE: Addition is living space from basement w/screen porch above.

Julie L. Pruett R.S.

Date: 1-10-14

ICHD-Environmental Health Division

I understand that this permit can be suspended or revoked if any false information is supplied toward securing the permit/any unauthorized changes are made to the site/any unauthorized changes are made in the installation of the system.

Signed: Tammy C. Hopper CPSS 10/18/95

Improvement Permit by: [illegible] RS date 10-4-95

~~Certificate of Completion~~ Auth. to Construct Existing System Inspection by: Wesley Parker RS. date 12/4/95

Installed by: ___

~~Certificate of Completion~~ by: ___ date ___

Operation Permit by: C. Barry Sherrill date 7/8/96

HEALTH DEPT. COPY: WHITE INSPECTION COPY (FINAL): GREEN OWNER COPY (FINAL): YELLOW INSPECTION COPY (INITIAL): PINK OWNER COPY (INITIAL): GOLD