IREDELL COUNTY HEALTH DEPARTMENT

Authorization to Construct

660-5736

STATESVILLE 704-878-5305 MOORESVILLE 704-664-5281

IMPROVEMENT PERMIT / ~~CERTIFICATE OF COMPLETION~~ / OPERATION PERMIT / EXISTING SYSTEM INSPECTION

PROPERTY DESCRIPTION NO. 22073 DATE Oct. 4 '95 TAX MAP NO. part of 7214420 4628-52-5180 Watershed: ☑ Yes ☐ No

OWNER OR CONTRACTOR ~~Crescent Ramsey Shoe~~ ARVIL PRICE PHONE: Business 568-6461 Home WS4

ADDRESS ~~PO Box 1003, Charlotte~~ 130 Robinson Charlotte, NC. 28215

LOCATION 150 W TR Pinnacle Shores Dr. TR Old Timber at end

SUBDIVISION Pinnacle Shores BLOCK / SECTION 1B LOT 95 LOT AREA ≥ 20,000 ft² SITE CLASS 5 pm 1956 DESIGN FLOW 480 gpd L.T.A.R. .3


Septic Tank: 1000 Gallons; STB 794 Date 9/27/95	☑ New System ☐ Repair System Type: I, II, III, IV, V, VI	☑ House/Mod. Home No. Bedrooms 4/4	Water Supply:
Pump Tank: 1000 Gallons; PT 27 Date 11/4/96	System Description: LPPBPS	☐ Mobile Home No. Bathrooms	☐ Individual
Pump Make: ZOELLER Model 161H Serial No.	Repair System Description: LPPBPS	☐ Business No. Employees	☑ Community
Nitrification Field: No Fields 1 Square Feet Linear Feet 270	Maintenance Agreement Required: ☑ Yes ☐ No	☐ Other	☐ Public
No Lines 3 Trench Width 24" Max Trench Bottom Depth ≈30" Gravel Depth N/A	☐ Slab ☑ Crawl Space ☑ Basement w/plumbing ☐ Basement wo/plumbing		

Comments:

Comments: PARTIAL - checked Septic Tank and pump tank on 1-5-96, due to inability to install after home is built. MPO.

1" = 50'

INITIAL SITE SKETCH

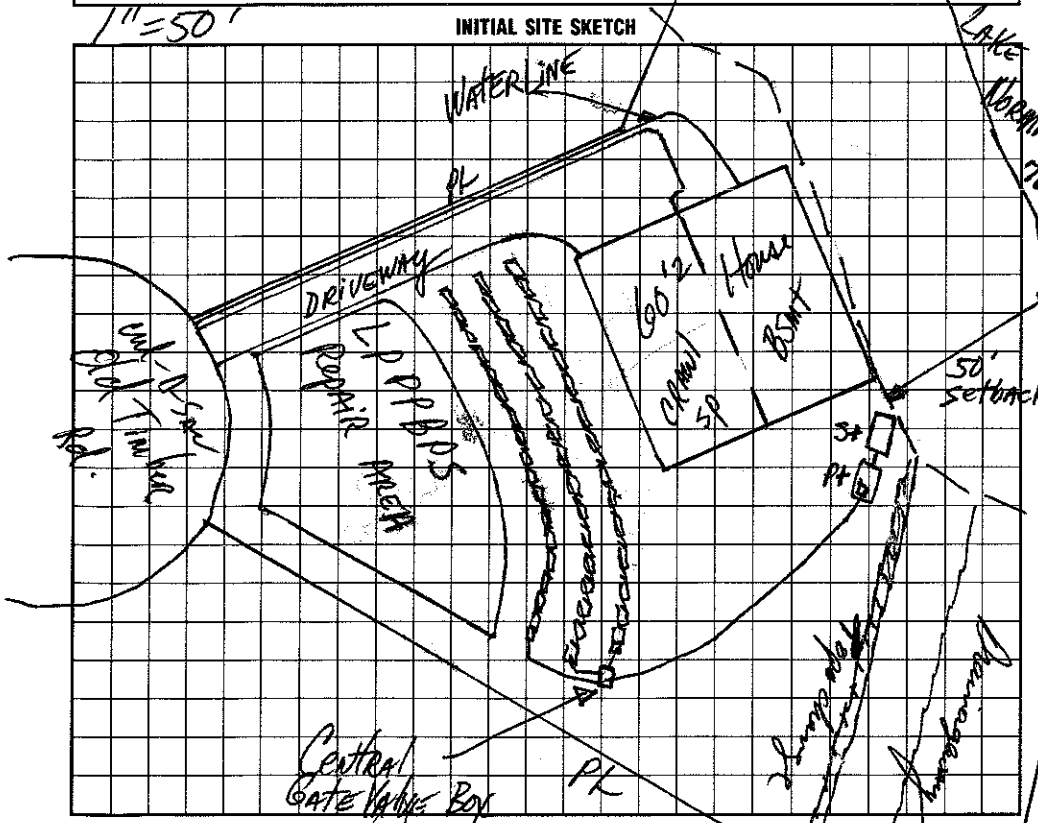

AS BUILT SKETCH

I understand that this permit can be suspended or revoked if any false information is supplied toward securing the permit/any unauthorized changes are made to the site/any unauthorized changes are made in the installation of the system.

Signed: [signature] 10/18/95

Improvement Permit by: [signature] date 10-4-95

~~Existing System Inspection~~ Auth. to Construct by: [signature] date 12/4/95

Installed by:

~~Certificate of Completion by:~~ date

Operation Permit by: [signature] date 7/8/96

HEALTH DEPT. COPY: WHITE INSPECTION COPY (FINAL): GREEN OWNER COPY (FINAL): YELLOW INSPECTION COPY (INITIAL): PINK OWNER COPY (INITIAL): GOLD