664-5418)

IREDELL COUNTY HEALTH DEPARTMENT

STATESVILLE 704-878-5305 MOORESVILLE 704-664-5281

IMPROVEMENT PERMIT / CERTIFICATE OF COMPLETION / OPERATION PERMIT / EXISTING SYSTEM INSPECTION

PROPERTY DESCRIPTION NO. 22220 DATE Nov. 2, '95 TAX MAP NO. part of 2NA20 4628 525400 Watershed: ☑ Yes ☐ No

OWNER OR CONTRACTOR Paul E. Stiles PHONE: Business _____ Home _____ WS4CA

ADDRESS 9362 Bybesburg Ln, Charlotte

LOCATION ISP W TR Pinnacle Shores Dr. TR Plantation Drive on left

SUBDIVISION Pinnacle Shores BLOCK / SECTION _____ LOT 87 LOT AREA 1.01 Ac SITE CLASS. B Sep. 1952 DESIGN FLOW 480 gpd L.T.A.R. .3

Septic Tank: 1000 Gallons; STB 794 Date 10/8/96

Pump Tank: 1000 Gallons; PT 47 Date 10/22/96

Pump Make: Zoeller Model WE0-511 Serial No. K960663

Nitrification Field: No Fields 1 Square Feet 1200 Linear Feet 400

No Lines 5@80' Trench Width 36" Max Trench Bottom Depth @30" Gravel Depth N/A

☑ New System ☐ Repair System Type: I, II, III, IV, V, VI

System Description: pumped/pressurized infiltrator

Repair System Description: LP WBPS

Maintenance Agreement Required: ☐ Yes ☑ No installed

☑ House/Mod. Home ☐ Mobile Home ☐ Business ☐ Other

No. Bedrooms 4 No. Bathrooms 4 No. Employees _____


☐ Slab ☐ Crawl Space ☑ Basement w/plumbing ☐ Basement wo/plumbing

Water Supply: ☐ Individual ☑ Community ☐ Public


Comments:

Comments:

INITIAL SITE SKETCH

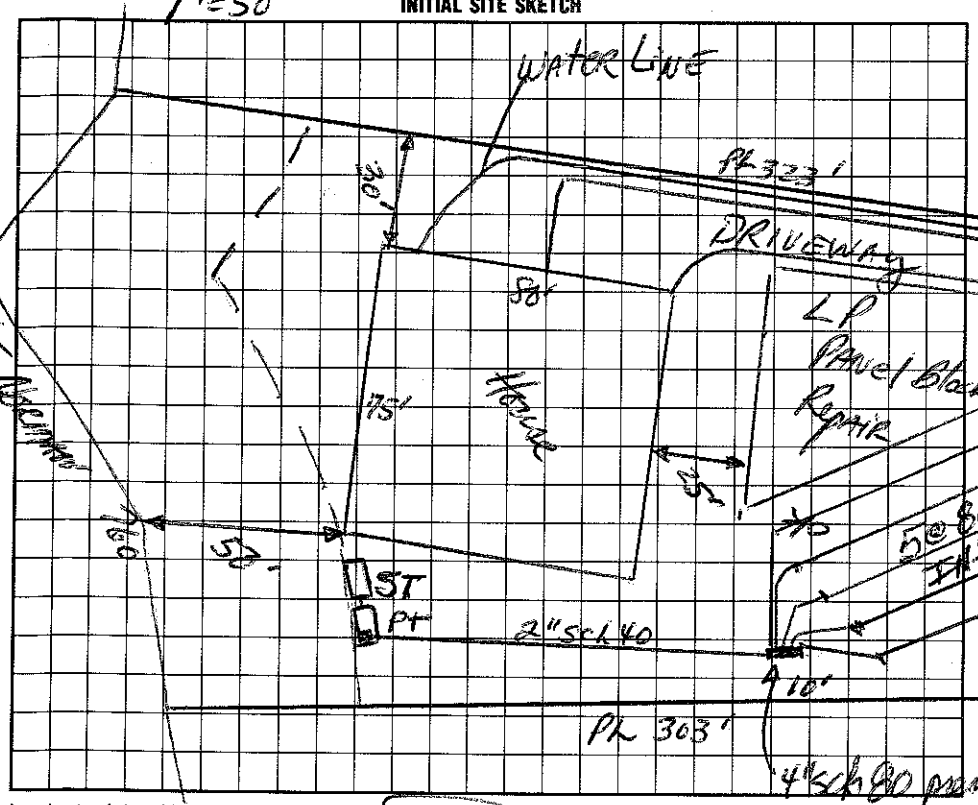

AS BUILT SKETCH

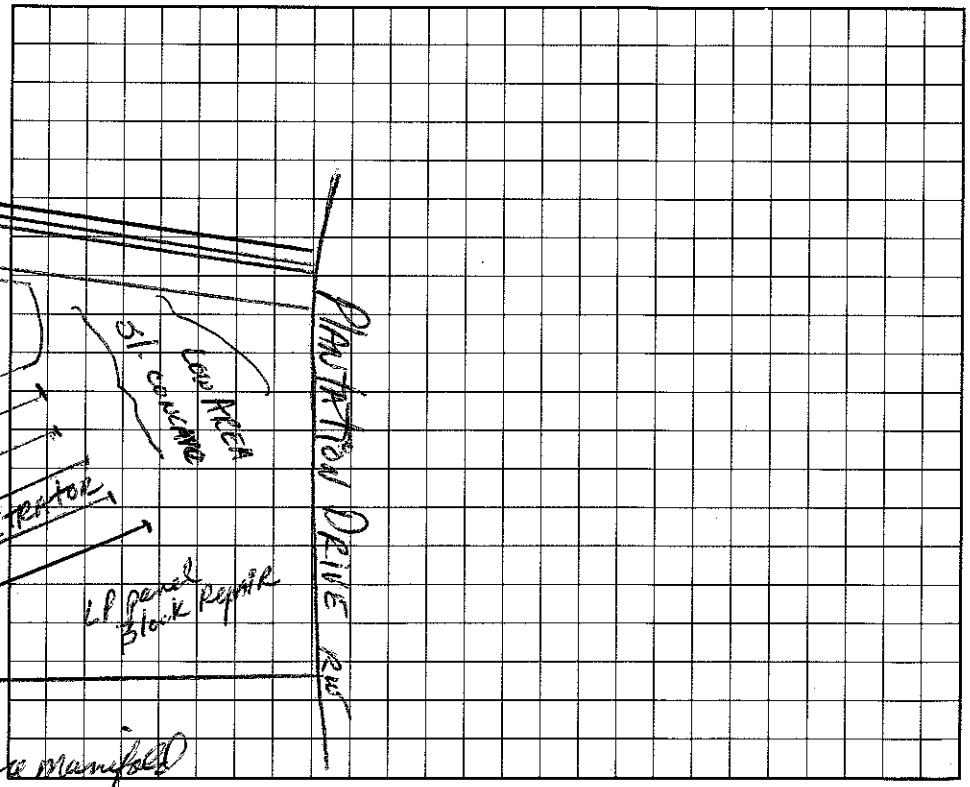

I understand that this permit can be suspended or revoked if any false information is supplied toward securing the permit/any unauthorized changes are made to the site/any unauthorized changes are made in the installation of the system.

Signed: Paul E. Stiles

Improvement Permit by: Jane L. Hanson RS date 11-2-95

Existing System Inspected by: Authorized Consultant: Wesley Sparks RS. date 6/28/96

Installed by: F I Ervin

Certificate of Completion by: _____ date _____

Operation Permit by: Wesley Sparks RS. date 1/28/97

HEALTH DEPT. COPY: WHITE INSPECTION COPY (FINAL): GREEN OWNER COPY (FINAL): YELLOW INSPECTION COPY (INITIAL): PINK OWNER COPY (INITIAL): GOLD