IREDELL COUNTY HEALTH DEPARTMENT

IMPROVEMENT PERMIT / CERTIFICATE OF COMPLETION / OPERATION PERMIT / EXISTING SYSTEM INSPECTION

STATESVILLE 704-878-5305 MOORESVILLE 704-664-5281

669-5418)

PROPERTY DESCRIPTION NO. 22220 DATE Nov. 2, '95 TAX MAP NO. part of 2NA20 4628 526420 Watershed: Yes No

OWNER OR CONTRACTOR Paul E. Stold PHONE: Business Home

ADDRESS 9362 Bulleymore Ln, Charlotte

LOCATION 150' W SR Pinnacle Shores Dr. Tr Plantation Manor on left

SUBDIVISION Pinnacle Shores BLOCK / SECTION LOT 87 LOT AREA 1.01 Ac SITE CLASS B and BX DESIGN FLOW 440 gpd L.T.A.R. .3

Septic Tank: 1000 Gallons: STB 1014 Date 10/27/96

Pump Tank: 1000 Gallons: PT 471 Date 10/22/96

Pump Make: Zoeller Model W66-5 Serial No. 6186165

Nitrification Field: No Fields 1 Square Feet 1200 Linear Feet 400

No Lines 5@ 80' Trench Width 36" Max Trench Bottom Depth 36"

☐ New System ☐ Repair System Type: I, II, III, IV, V, VI

System Description: Absorption w/ pump / Infiltrator

Repair System Description:

Maintenance Agreement Required: ☐ Yes ☑ No (available)

Gravel Depth NA ☐ Slab ☐ Crawl Space ☐ Basement w/plumbing ☐ Basement w/o plumbing

☑ House/Mod. Home No. Bedrooms 4

☐ Mobile Home No. Bathrooms 4

☐ Business No. Employees

☐ Other


Water Supply: ☐ Individual ☑ Community ☐ Public

Comments:


Comments:

INITIAL SITE SKETCH

1"=50'

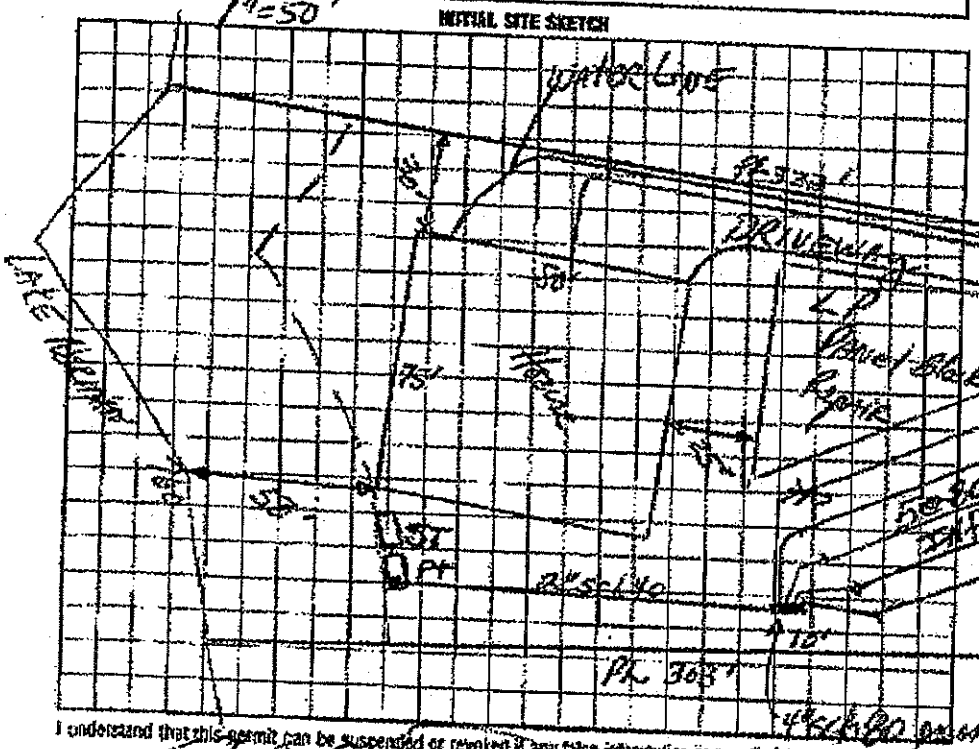

AS BUILT SKETCH

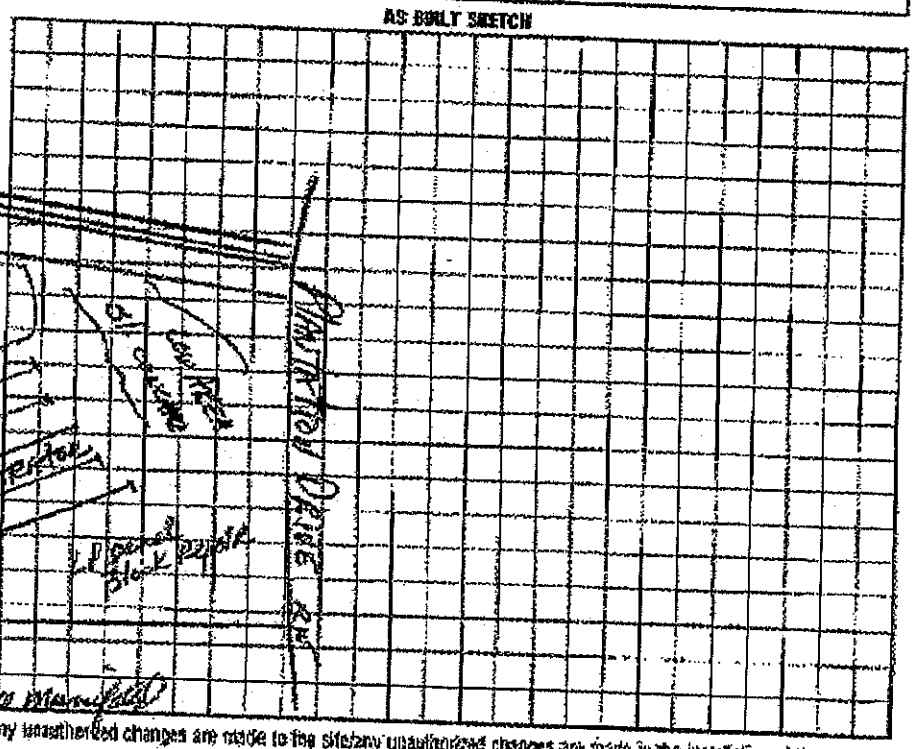

I understand that this permit can be suspended or revoked if any false information is supplied toward securing the permit, any unauthorized changes are made to the site, any unauthorized changes are made in the installation of the system.

Signed: Paul E. Stold

Improvement Permit by: Jane E. Stevens, RS date 11-2-95

Authority granted to Sanitarian Walter Sparks, RS date 1/29/96

Installed by: FJ Ervin

Certificate of Completion by:

Operation Permit by: Walter Sparks, RS. date 1/29/97

REHLTH DEPT. COPY: WHITE INSPECTION COPY (INITIAL): GREEN OWNER COPY (FINAL): YELLOW INSPECTION COPY (INITIAL): PINK OWNER COPY (INITIAL): GOLD

Feb. 21. 2014 12:07PM ARCHADECK OF CHARLOTTE No. 7866 P. 5