IREDELL COUNTY HEALTH DEPARTMENT

↑ AUTHORIZATION TO CONSTRUCT (3-4 yr)

STATESVILLE 704-878-5305 MOORESVILLE 704-664-5281

IMPROVEMENT PERMIT / ~~CERTIFICATE OF COMPLETION~~ / OPERATION PERMIT / EXISTING SYSTEM INSPECTION

PROPERTY DESCRIPTION NO. 22059 DATE 7/14/97 TAX MAP NO. pt of 2NA20 4628525765 Watershed: ☑ Yes ☐ No

OWNER OR CONTRACTOR ALFRED BYRNE PHONE: Business _____ Home 910-541-5966

ADDRESS 108 BEAR LN MOORESVILLE NC 28115

LOCATION ISD W-TR PINNACLE SHORES DR. - TL PLANTATION DR - ON RT

SUBDIVISION PINNACLE SHORES BLOCK / SECTION 10 LOT 65 LOT AREA 7 20,000 ft² SITE CLASS. PS DESIGN FLOW 480.00 L.T.A.R. .3 GPD/FT²

Septic Tank: 1000 Gallons; STB 794 Date 11/29/97

Pump Tank: 1000 Gallons; PT 27 Date 12/12/97

Pump Make: GOULD Model WE05111+ Serial No. 09744365

Nitrification Field: No Fields 1 Square Feet 1200 Linear Feet 400

No Lines 6@67' Trench Width 36" Max Trench Bottom Depth ≈30" Gravel Depth N/A

☑ New System ☐ Repair System Type: I, II, III, IV, V, VI

System Description: PUMP CHAMBERED

Repair System Description: PUMP PANEL

Maintenance Agreement Required: ☐ Yes ☑ No

☑ House/Mod. Home No. Bedrooms 4

☐ Mobile Home No. Bathrooms 4

☐ Business No. Employees ____

☐ Other ____


☐ Slab ☐ Crawl Space ☑ Basement w/plumbing ☐ Basement wo/plumbing

Water Supply: ☐ Individual ☑ Community ☐ Public


Comments:

Comments:

INITIAL SITE SKETCH 1"=50'

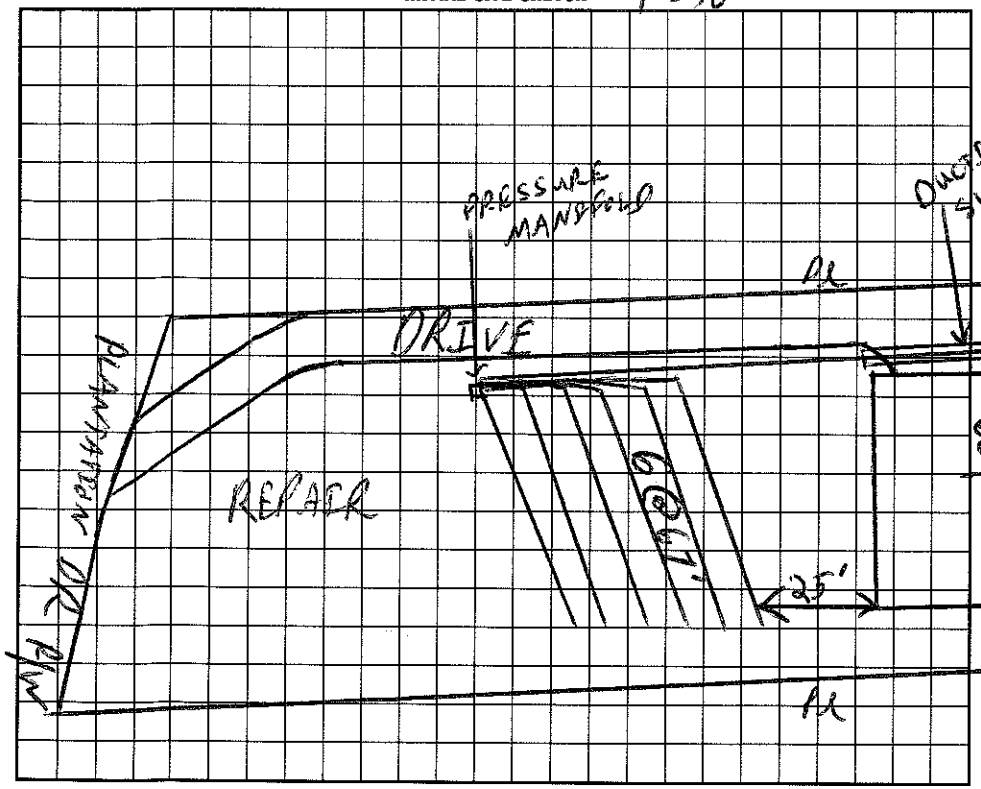

AS BUILT SKETCH

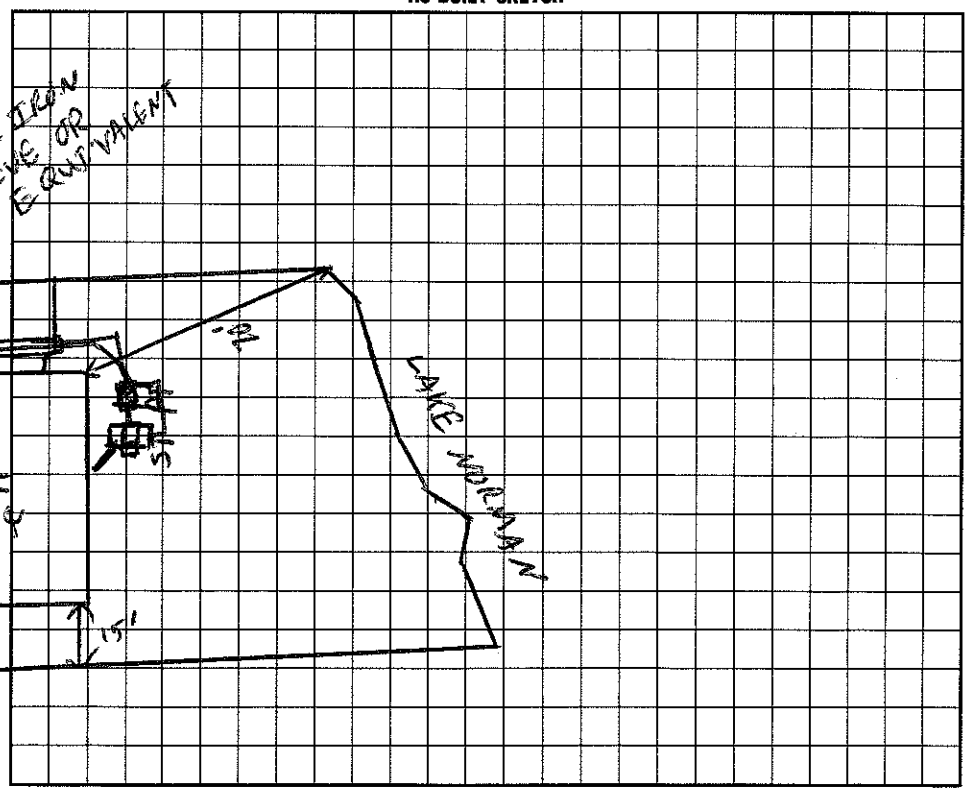

I understand that this permit can be suspended or revoked if any false information is supplied toward securing the permit/any unauthorized changes are made to the site/any unauthorized changes are made in the installation of the system. Improvement Permit is valid for 60 months from date of issuance.

Signed: Alfred S Byrne

Improvement Permit by: [signature] date 7/14/97

Existing System Inspection by: [signature] date 7/14/97

Installed by: F J Ervin

Certificate of Completion by: Wesley Sparks R.S. date 3/4/98

Operation Permit by: Wesley Sparks R.S. date 3/4/98

AUTHORIZATION TO CONSTRUCT

HEALTH DEPT. COPY: WHITE INSPECTION COPY (FINAL): GREEN OWNER COPY (FINAL): YELLOW INSPECTION COPY (INITIAL): PINK OWNER COPY (INITIAL): GOLD