# IREDELL COUNTY HEALTH DEPARTMENT

STATESVILLE 704-878-5305 MOORESVILLE 704-664-5281

## IMPROVEMENT PERMIT / AUTHORIZATION TO CONSTRUCT / OPERATION PERMIT / EXISTING SYSTEM INSPECTION

PERMIT# 140769 PIN# 4628526399 DATE 3/22/07

OWNER OR APPLICANT Glen & Sherrie MacDermond PHONE: Business _____ Home _____

ADDRESS 136 Tanager Ln Mooresville 28117

LOCATION Hwy 150 West Rt on Pinnacle Shores (Main Entrance), Lt on Plantation, Lt on left

SUBDIVISION Pinnacle Shores BLOCK / SECTION 1 LOT 82 LOT AREA 1.14 Ac SITE CLASS. PS DESIGN FLOW 480 L.T.A.R. .55

Septic Tank: 1000 Gallons; STB 312 Date 3/23/07
Pump Tank: 1000 Gallons; PT 283 Date 3/28/07
Pump Make: Gould's Model WE6-512 Serial No. _____
Nitrification Field: No Fields ___ Square Feet 684 Linear Feet 228
No Lines 3 Trench Width 24" Max Trench Bottom Depth 36" Gravel Depth N/A

☒ New System ☐ Repair ☐ Expansion System Type: I II III (IV) V VI
System Description: LPP PBPS
Repair System Description: Same
Maintenance Agreement Required: ☒ Yes ☐ No

☒ House/Mod. Home No. Bedrooms 4
☐ Mobile Home No. Persons ___
☐ Business No. Employees ___
☐ Other


Water Supply: ☒ Individual ☐ Public ☐ Community PINNACLE SHORES

☐ Gravity ☒ Pressure ☐ Slab ☒ Crawl Space ☒ Basement w/plumbing ☐ Basement wo/plumbing


Comments:/Conditions: Keep lines on contour & 15' above foundation cut. Grade around tree mound/gully if encroaching area with trenches. Well 50' or more from tanks

Comments:/Conditions: Dunning to provide Maintenance

INITIAL SITE SKETCH

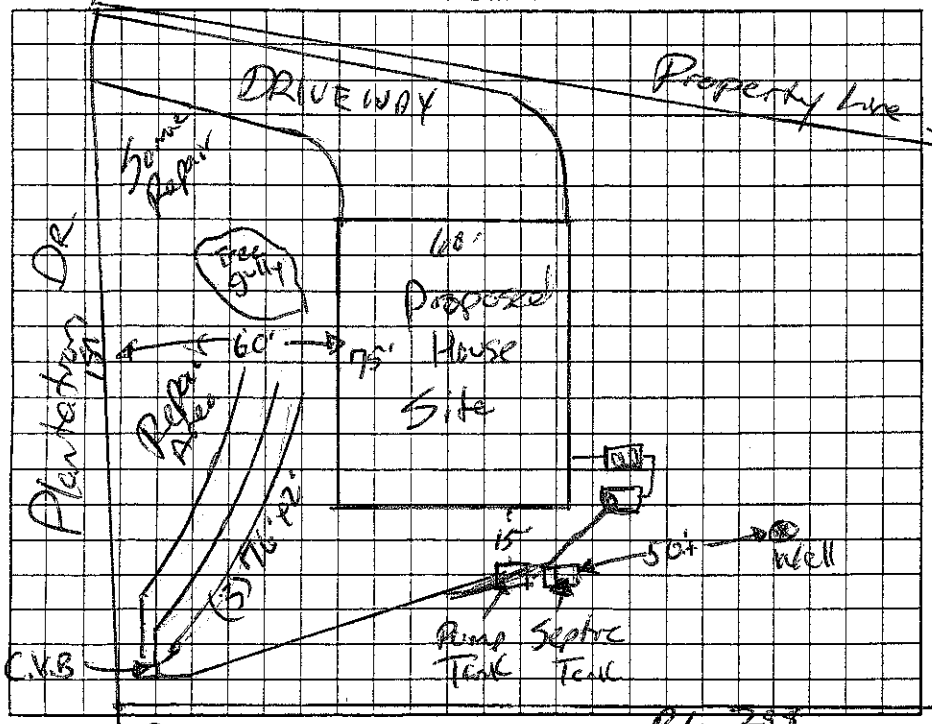


AS BUILT SKETCH

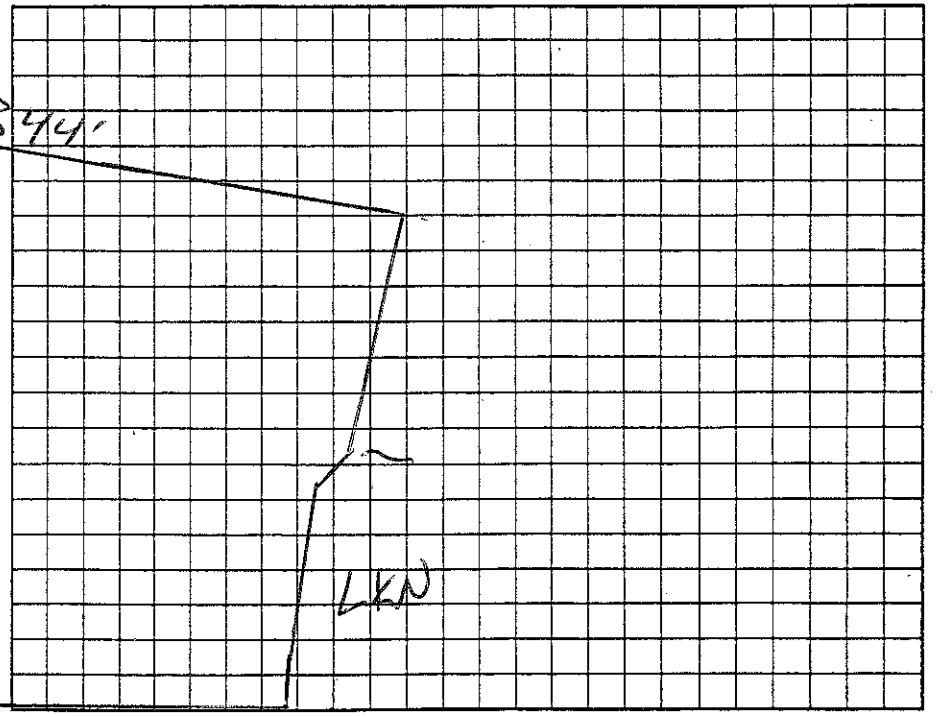


Permit can be suspended or revoked if any false information is supplied toward securing the permit/any unauthorized changes are made to the site/any unauthorized changes are made in the installation of the system. Improvement Permit with plat valid without expiration ☐ Improvement Permit with site plan valid for sixty months ☒ Authorization to Construct is valid for a period equal to that of Improvement Permit – not to exceed sixty months.

Signed: _____ date 3/28/07 Installed by: Lant Dunning

Improvement Permit by: Josh E Allen date 3/26/07 Operation Permit by: Wesley Sparks RS. date 12/20/07

Authorization to Construct by: Josh E Allen date 3/26/07 Existing System Inspection by: _____ date _____

HEALTH DEPT. COPY: WHITE OWNER COPY (FINAL): YELLOW OWNER COPY (INITIAL): PINK