COUNTY HEALTH DEPARTMENT

STATESVILLE 704-878-5305 MOORESVILLE 704-664-528

IMPROVEMENT PERMIT / CERTIFICATE OF COMPLETION / OPERATION PERMIT / EXISTING SYSTEM INSPECTIO

PROPERTY DESCRIPTION NO. 25748 DATE 1/14/97 TAX MAP NO. ~~2N A 20 pt~~ 2NA20 pt4 Watershed: ☑ Yes ☐ No

OWNER OR CONTRACTOR CARLO MCKOY PHONE: Business 4628 52 6758 Home 547-1461

ADDRESS 4516 NEW NEW HARDEN CT CHARLOTTE NC

LOCATION @ 150 W - TR PINNACLE LANE - TL PLANTATION-ON RT

SUBDIVISION PINNACLE SHORES BLOCK / SECTION I LOT 64 LOT AREA SITE CLASS. PS DESIGN FLOW 480 GAD L.T.A.R. .3 GPD/FT2

Septic Tank: 1000 Gallons; STB 1012 Date 7/4/97
Pump Tank: Gallons; PT 17 Date 9/9/97
Pump Make: GOULDS Model WE1012H Serial No. 14P
Nitrification Field: No Fields 1 Square Feet 16 Linear Feet 402
No Lines 6@61' Trench Width 36" Max Trench Bottom Depth 36" Gravel Depth N/A

☑ New System ☐ Repair System Type: I, II, III, IV, V, VI
System Description: PUMP CHAMBER OR SIMILAR
Repair System Description: PUMP ~~TANK~~ PANEL
Maintenance Agreement Required: ☐ Yes ☑ No

☑ House/Mod. Home No. Bedrooms 4
☐ Mobile Home No. Bathrooms 4
☐ Business No. Employees
☐ Other


☐ Slab ☑ Crawl Space ☑ Basement w/plumbing ☐ Basement wo/plumbing

Water Supply: ☐ Individual ☑ Community ☐ Public


Comments:

Comments: Checked fittings & float trees 10/23/97 MB

INITIAL SITE SKETCH 1"=60'

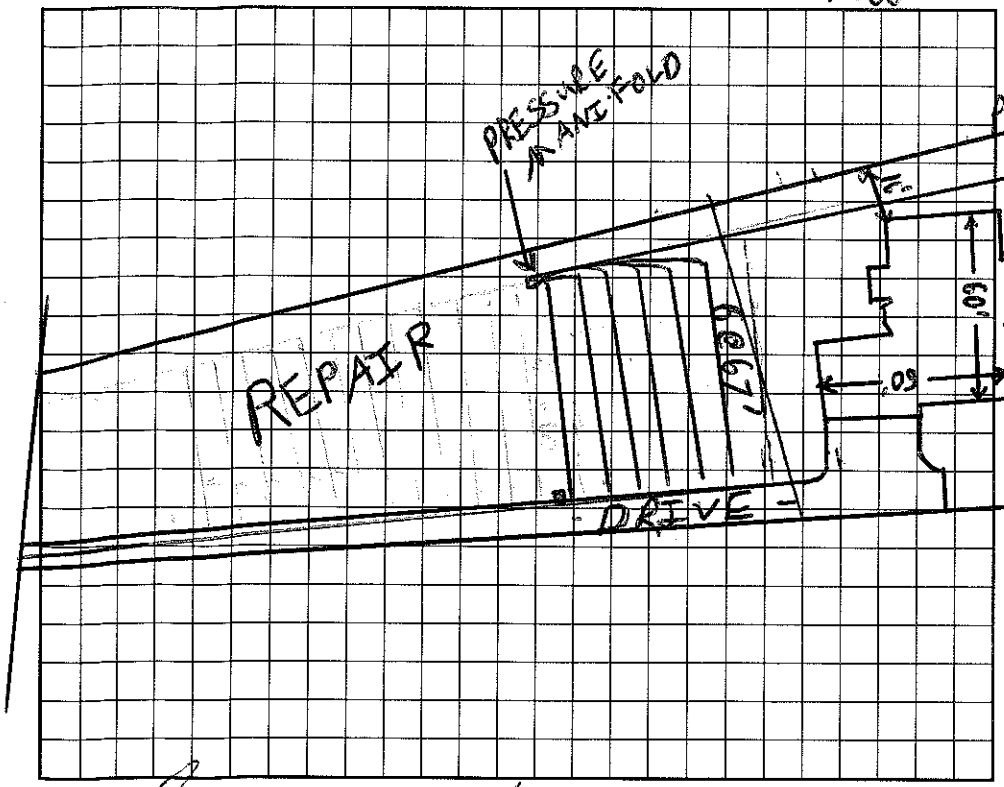

AS BUILT SKETCH

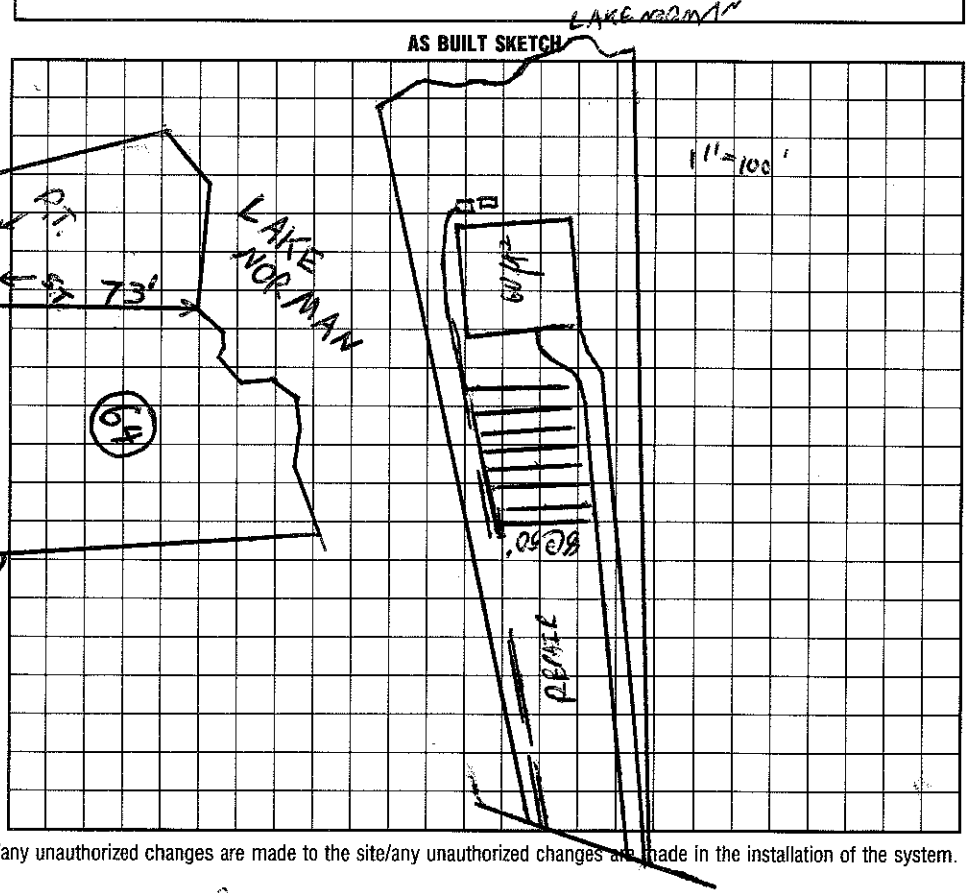

I understand that this permit can be suspended or revoked if any false information is supplied toward securing the permit/any unauthorized changes are made to the site/any unauthorized changes are made in the installation of the system. Improvement Permit is valid for 60 months from date of issuance.

Signed: C. Carlo McKoy

Improvement Permit by: C. Bly Zoe EHSI date 1/14/97

Existing System Inspection by: C. Bly Zoe EHSI date 1/14/97

Installed by: DONALD LACHEY

Certificate of Completion by: date

Operation Permit by: C. Bly Zoe date 11/12/97

HEALTH DEPT. COPY: WHITE INSPECTION COPY (FINAL): GREEN OWNER COPY (FINAL): YELLOW INSPECTION COPY (INITIAL): PINK OWNER COPY (INITIAL): GOLD