1:30

IREDELL COUNTY HEALTH DEPARTMENT

Authorization to Construct

STATESVILLE 704-878-5305 MOORESVILLE 704-664-5281

IMPROVEMENT PERMIT / ~~CERTIFICATE OF COMPLETION~~ / OPERATION PERMIT / EXISTING SYSTEM INSPECTION

PROPERTY DESCRIPTION NO. 22821 (89456) DATE 5/3/96 TAX MAP NO. 2N-8-A-87 Watershed: ☑ Yes ☐ No

OWNER OR CONTRACTOR Joanne C. West PHONE: Business 4628-52-8256 Home 895-0763

ADDRESS 16707 Spinaker Ln Huntersville NC

LOCATION Hwy 150 - TR Pinnacle Shores - 2nd Rt lot on left

123 Pinnacle Shores Dr.

SUBDIVISION Pinnacle Shores BLOCK / SECTION I LOT 84 LOT AREA .80 ac SITE CLASS. PS DESIGN FLOW 480 gpd L.T.A.R. .3 gpd/sf

Septic Tank: 1000 Gallons; STB 794 Date 8/1/00

Pump Tank: _____ Gallons; PT _____ Date _____

Pump Make: _____ Model _____ Serial No. _____

Nitrification Field: No Fields 1 Square Feet 1200 Linear Feet 400

No Lines 4 Trench Width 36" Max Trench Bottom Depth 36" Gravel Depth N/A

☑ New System ☐ Repair System Type: I, II, III, IV, V, VI

System Description: Gravity Chambers

Repair System Description: Same

Maintenance Agreement Required: ☐ Yes ☑ No

☑ House/Mod. Home No. Bedrooms 4

☐ Mobile Home No. Bathrooms 4

☐ Business No. Employees _____

☐ Other _____


☐ Slab ☐ Crawl Space ☑ Basement w/plumbing ☐ Basement wo/plumbing

Water Supply: ☐ Individual ☐ Community ☑ Public


Comments:

Comments:

INITIAL SITE SKETCH

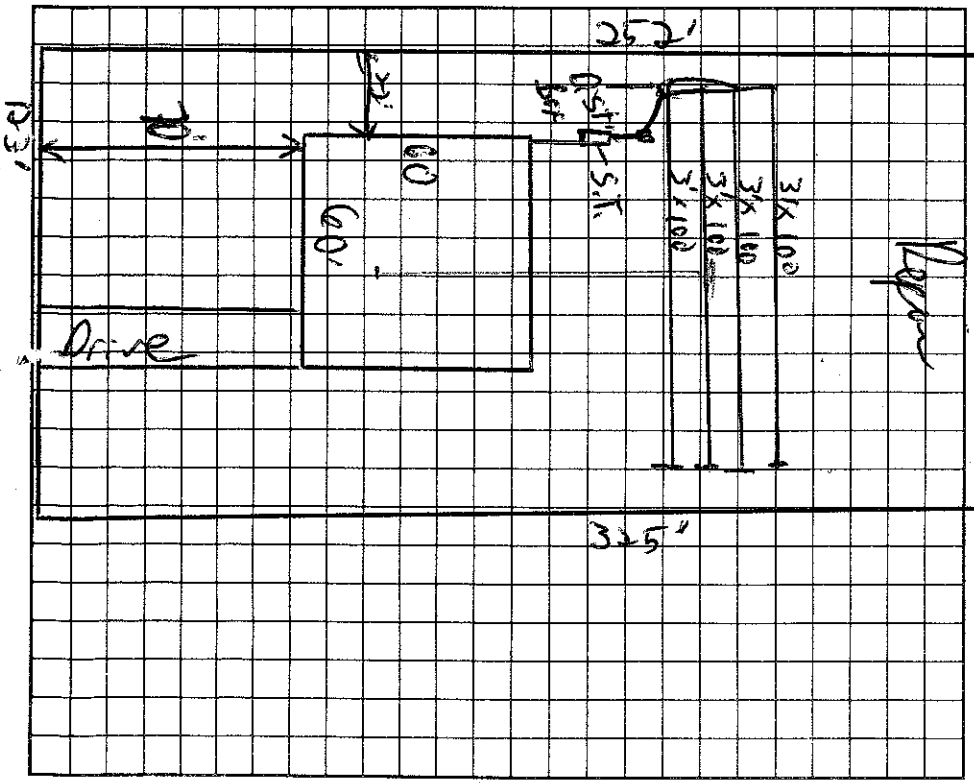

AS BUILT SKETCH

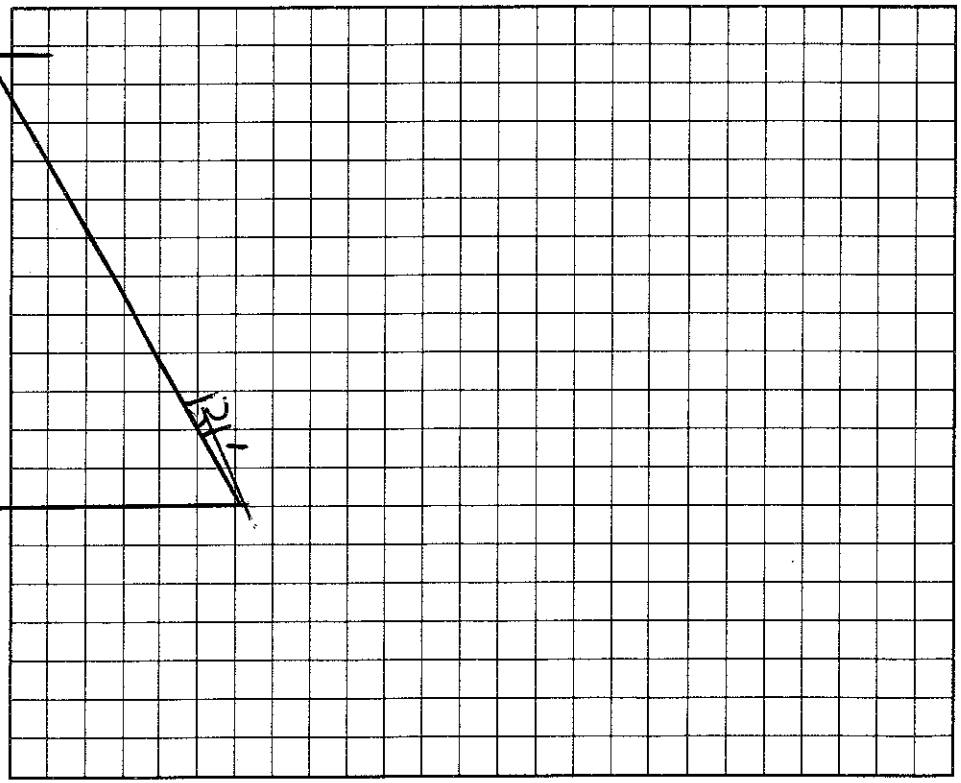

I understand that this permit can be suspended or revoked if any false information is supplied toward securing the permit/any unauthorized changes are made to the site/any unauthorized changes are made in the installation of the system.

Signed: * Joanne C West

Installed by: Atlantic Excavating

Improvement Permit by: C. Rob Freeman EHST date 5/3/96

Certificate of Completion by: Wesley Sparks R.S. date 9/7/00

Existing System Inspection by: C. Rob Freeman EHST date 5/3/96

Operation Permit by: Wesley Sparks R.S. date 9/7/00

HEALTH DEPT. COPY: WHITE INSPECTION COPY (FINAL): GREEN OWNER COPY (FINAL): YELLOW INSPECTION COPY (INITIAL): PINK OWNER COPY (INITIAL): GOLD

Authorization to Construct is valid for 60 months from issue date