IREDELL COUNTY HEALTH DEPARTMENT

Authorized to Construct

STATESVILLE 704-878-5305 MOORESVILLE 704-664-5281

IMPROVEMENT PERMIT / ~~CERTIFICATE OF COMPLETION~~ / OPERATION PERMIT / EXISTING SYSTEM INSPECTION

PROPERTY DESCRIPTION NO. 22250 DATE 4/5/97 TAX MAP NO. pt of 2N A 20 Watershed: X Yes ☐ No

OWNER OR CONTRACTOR ROBIN MIHALEVICH PHONE: Business 4628-52-9651 Home 528-6127 WS4 CA

ADDRESS 119 RED BARN LN STATESVILLE, NC 28677

LOCATION 150 W TR PINNACLE SHORES TL PLANTATION DRIVE ON RIGHT

SUBDIVISION PINNACLE SHORES BLOCK / SECTION 1 LOT 61 LOT AREA 720,000 FT2 SITE CLASS. PS.1954 DESIGN FLOW 480 L.T.A.R. .35

Septic Tank: 1000 Gallons; STB 794 Date 6/97

Pump Tank: _____ Gallons; PT _____ Date _____

Pump Make: _____ Model _____ Serial No. _____

Nitrification Field: No Fields 1 Square Feet 1080 Linear Feet 360

No Lines 3 Trench Width 36" Max Trench Bottom Depth 36" Gravel Depth SAND

X New System ☐ Repair System Type: I, II, III, IV, V, VI

System Description: GRAV - CH PLASTIC

Repair System Description: GRAV - PANEL

Maintenance Agreement Required: ☐ Yes X No

X House/Mod. Home ☐ Mobile Home ☐ Business ☐ Other

No. Bedrooms 4 No. Bathrooms 3 No. Employees _____


☐ Slab ☐ Crawl Space X Basement w/plumbing ☐ Basement wo/plumbing

Water Supply: ☐ Individual X Community ☐ Public


Comments: Lines on slope contour - Surface water must be managed above the drainfield

Comments:

INITIAL SITE SKETCH

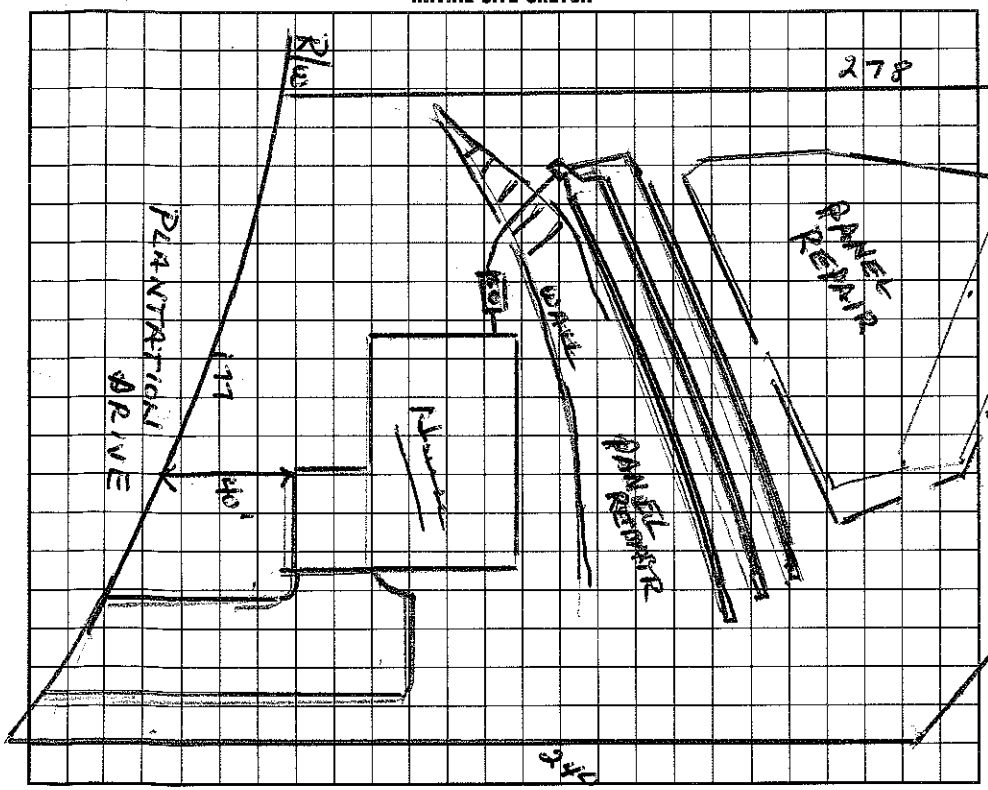

AS BUILT SKETCH

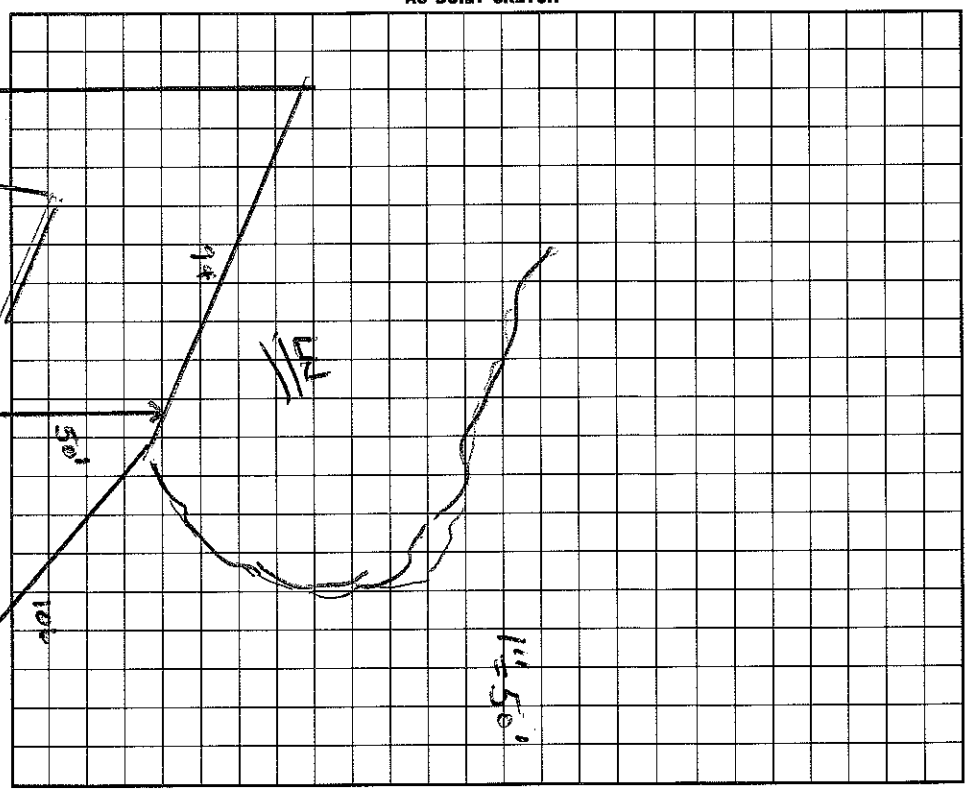

I understand that this permit can be suspended or revoked if any false information is supplied toward securing the permit/any unauthorized changes are made to the site/any unauthorized changes are made in the installation of the system. Improvement Permit is valid for 60 months from date of issuance.

Signed: X Glenis Brown Smith Spivey Construction Installed by: Mac Caldwell

Improvement Permit by: Wesley Sparks R.S. date 4/5/97 Certificate of Completion by: Wesley Sparks R.S. date ~~4/13/98~~ 4/13/98

Existing System Inspection by: Wesley Sparks R.S. date 4/5/97 Operation Permit by: Wesley Sparks R.S. date 4/13/98

Health Center

HEALTH DEPT. COPY: WHITE INSPECTION COPY (FINAL): GREEN OWNER COPY (FINAL): YELLOW INSPECTION COPY (INITIAL): PINK OWNER COPY (INITIAL): GOLD