IREDELL COUNTY HEALTH DEPARTMENT

STATESVILLE 704-878-5305 130.00 Paid MOORESVILLE 704-664-5281

IMPROVEMENT PERMIT / AUTHORIZATION TO CONSTRUCT / OPERATION PERMIT / EXISTING SYSTEM INSPECTION

PERMIT# 108 139 PIN# 4628-53-9262

OWNER OR CONTRACTOR Simonini Builders, Inc. DATE 8/5/02

ADDRESS 817 E Morehead St. #100 Charlotte NC 28202 PHONE: Business 704-358-9940 Home

LOCATION 150 W, TR Pinnacle Shores Dr., at end on Lt. at 243 Pinnacle

SUBDIVISION Pinnacle Shores BLOCK / SECTION 1 LOT 53/54 LOT AREA 0.49 AC SITE CLASS PS DESIGN FLOW 480 L.T.A.R. 0.3

Septic Tank: 1000 Gallons; STB 312 Date 2-21-03
Pump Tank: 1000 Gallons; PT 27 Date 2-14-03
Pump Make: Model Serial No.
Nitrification Field: No Fields 1 Square Feet 1200 Linear Feet 400
No Lines 4 @ 100' Trench Width 36" Max Trench Bottom Depth 36" Gravel Depth —

☒ New System ☐ Repair System Type: I, II, III, IV, V, VI
System Description: Press. Man. 25% Red.
Repair System Description: LP Panel Block
Maintenance Agreement Required: ☐ Yes ☒ No

☒ House/Mod. Home ☐ Mobile Home ☐ Business ☐ Other
No. Bedrooms 4 No. Bathrooms 4½ No. Employees


☐ Slab ☐ Crawl Space ☒ Basement w/plumbing ☐ Basement wo/plumbing

Water Supply: ☐ Individual ☐ Public ☒ Community

Comments:/Conditions:

Comments:/Conditions: Tanks & lines Checked 3/26/03

INITIAL SITE SKETCH

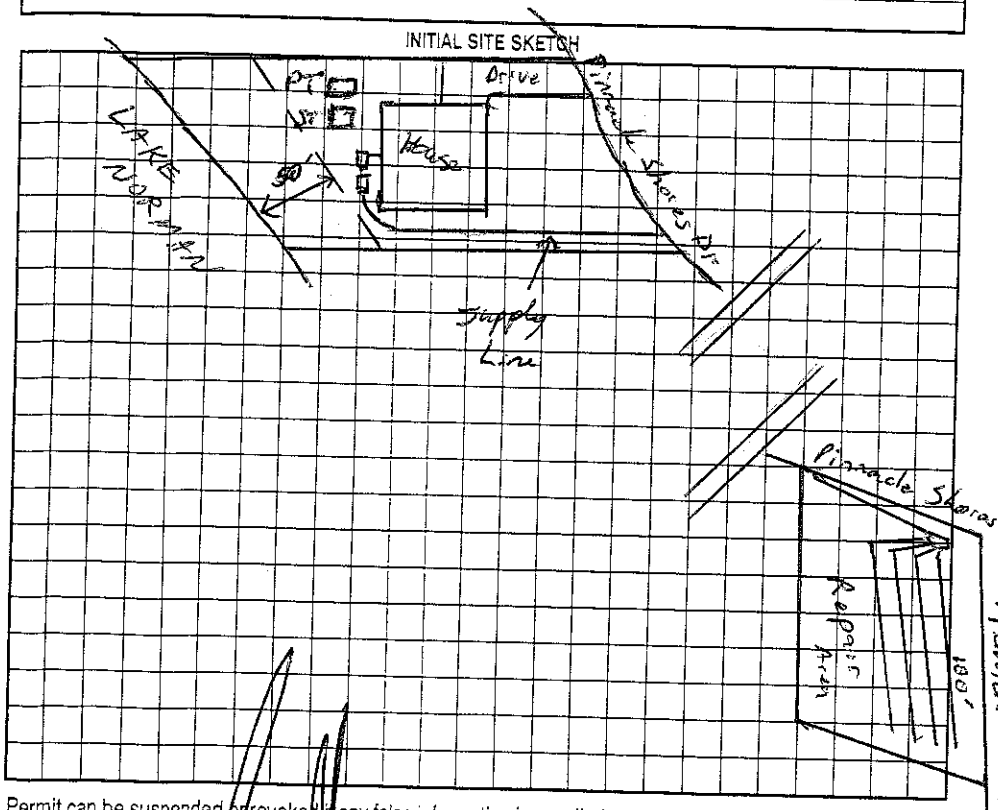

AS BUILT SKETCH

EZ Flow
Drainfield
Installed

Permit can be suspended or revoked if any false information is supplied toward securing the permit/any unauthorized changes are made to the site/any unauthorized changes are made in the installation of the system. Improvement Permit with plat valid without expiration. Improvement Permit with site plan valid for sixty months. Authorization to Construct is valid for a period equal to that of Improvement Permit – not to exceed sixty months.

Signed: date 9/7/02

Improvement Permit by: RS date 8/5/02

Authorization to Construct by: RS date 8/5/02

Installed by: K & H Inc RS

Operation Permit by: date 6/16/03

Existing System Inspection by: date

HEALTH DEPT. COPY: WHITE OWNER COPY (FINAL): YELLOW OWNER COPY (INITIAL): PINK