IREDELL COUNTY HEALTH DEPARTMENT

STATESVILLE 704-878-5305 MOORESVILLE 704-664-5281

IMPROVEMENT PERMIT / AUTHORIZATION TO CONSTRUCT / OPERATION PERMIT / EXISTING SYSTEM INSPECTION

3,500 Paid 11:30

PERMIT# 17492 PIN# 4628616337 Cell DATE 1-15-04

OWNER OR CONTRACTOR John Ghencian PHONE: Business 704 657-8026 Home (704) 658-1163

ADDRESS 107 Red Brook Ln Mooresville, NC 28117

LOCATION Hwy 150 West TR Pinnacle Shores Dr TR Manitoba Ln on rt just before Cul-de-sac

SUBDIVISION Pinnacle Shores BLOCK / SECTION X LOT 12 LOT AREA 21,780 Ft^2 SITE CLASS. PS DESIGN FLOW 480 gpd L.T.A.R. .3

Septic Tank: 1000 Gallons; STB 825 Date 10-8-04
Pump Tank: 1000 Gallons; PT 302 Date 8-16-04
Pump Make: Zoeller Model N98 Serial No.
Nitrification Field: No Fields 1 Square Feet 540' Linear Feet 270'
No Lines 3090' Trench Width 24"-36" Max Trench Bottom Depth 36" Gravel Depth N/A

☒ New System ☐ Repair System Type: I, II, III, IV, V, VI
System Description: Pump-LP-Panel Block
Repair System Description: Pump-LP-Panel Block
Maintenance Agreement Required: ☒ Yes ☐ No

☒ House/Mod. Home ☐ Mobile Home ☐ Business ☐ Other
No. Bedrooms 4 No. Bathrooms 4 No. Employees
☐ Slab ☐ Crawl Space ☒ Basement w/plumbing ☐ Basement wo/plumbing


Water Supply: ☐ Individual ☒ Public ☒ Community

Comments:/Conditions: Keep Septic System at least 10' from PL. Install drainlines on Contour. Very tight site.


Comments:/Conditions: Lines, tanks & pressure checked 12/22/04 MZ

Scale 1"=50'

INITIAL SITE SKETCH

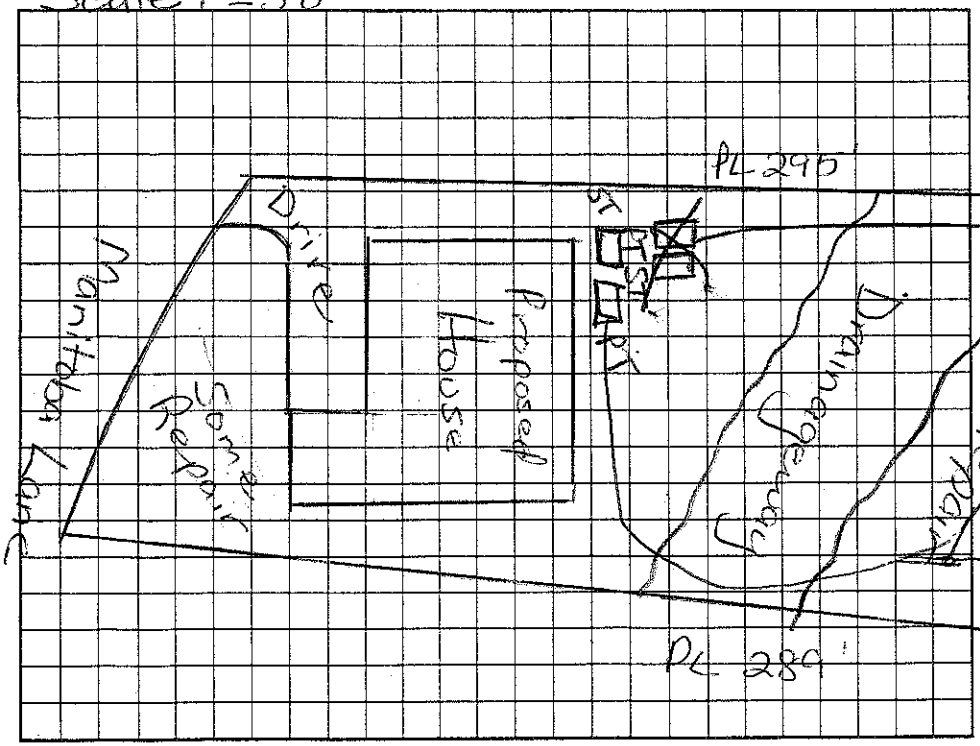

AS BUILT SKETCH

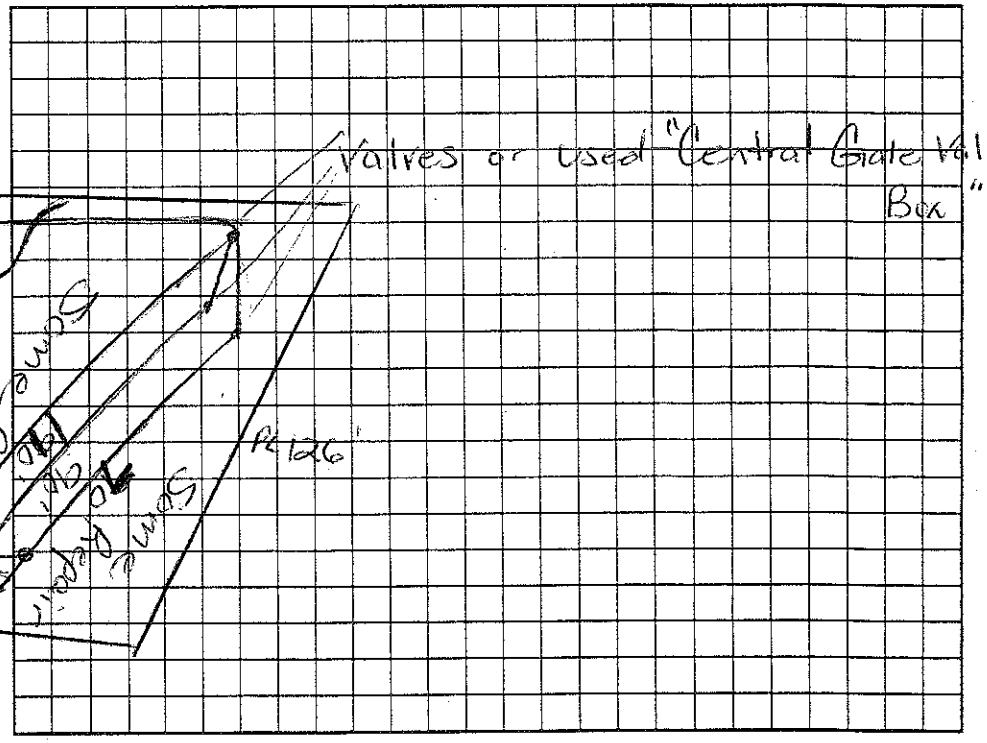

Permit can be suspended or revoked if any false information is supplied toward securing the permit/any unauthorized changes are made to the site/any unauthorized changes are made in the installation of the system. Improvement Permit with plat valid without expiration. Improvement Permit with site plan valid for sixty months. Authorization to Construct is valid for a period equal to that of Improvement Permit – not to exceed sixty months.

Signed: date 1-20-04 Installed by: Rowan Septic

Improvement Permit by: Maria H. Dotson RS date 1/16/03 Operation Permit by: RS date 9/29/05

Authorization to Construct by: Maria H. Dotson RS date 1/16/03 Existing System Inspection by: date

HEALTH DEPT. COPY: WHITE OWNER COPY (FINAL): YELLOW OWNER COPY (INITIAL): PINK