IREDELL COUNTY HEALTH DEPARTMENT

Authorization to Construct 11:30

STATESVILLE 704-878-5305 MOORESVILLE 704-664-5281

IMPROVEMENT PERMIT / ~~CERTIFICATE OF COMPLETION~~ / OPERATION PERMIT / EXISTING SYSTEM INSPECTION

PROPERTY DESCRIPTION NO. 21308 DATE 11/15/96 TAX MAP NO. Pt of 2NA20 4628 61 1627 Watershed: X Yes ☐ No

OWNER OR CONTRACTOR TOM ECONOMOS PHONE: Business 896-4424 Home

ADDRESS 135 Ashford Hollow Ln. Mooresville, NC. 28115

LOCATION 150' W TR Pinnacle Shores TR Manitoba Ln. on (L) Corner

SUBDIVISION PINNACLE SHORES BLOCK / SECTION I LOT 18 LOT AREA ~ 21000 Ft² SITE CLASS. PS DESIGN FLOW 360 L.T.A.R. .3

Septic Tank: 1000 Gallons; STB 794 Date 2/11/97

Pump Tank: 1000 Gallons; PT 27 Date 3/1/97

Pump Make: Goulds Model WE05114 Serial No. L96122397

Nitrification Field: No Fields 1 Square Feet 900 Linear Feet 300

No Lines 3 Trench Width 36" Max Trench Bottom Depth 32" Gravel Depth SAND

X New System ☐ Repair System Type: I, II, (III) IV, V, VI

System Description: PRESMAN → CH PLASTIC

Repair System Description: CH PLASTIC

Maintenance Agreement Required: ☐ Yes X No

☐ Slab ☐ Crawl Space ☐ Basement w/plumbing ☐ Basement wo/plumbing

X House/Mod. Home No. Bedrooms 3

☐ Mobile Home No. Bathrooms 3

☐ Business No. Employees

☐ Other


Water Supply: ☐ Individual X Community ☐ Public

Comments:

Comments: LINES, TANKS, PRESSURE check 4/15/97

5/16/97 - Conduit between Riser and Electrical Connections ~~AS BUILT SKETCH~~ needs to be sealed with Vapor proof sealant. AWS

INITIAL SITE SKETCH

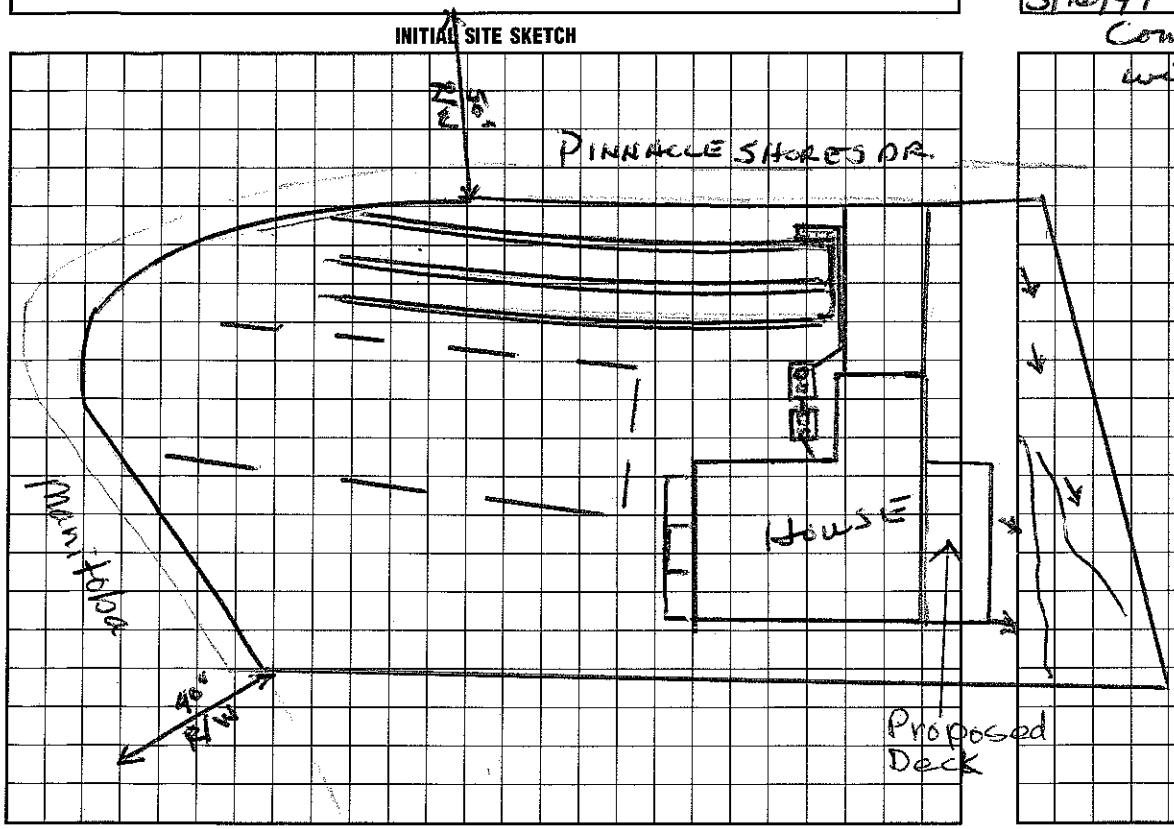

Sure

as

S/R

Sketch

The location of the proposed Deck addition does not appear to impact the existing septic system.

**NOTE:

Audrey Melville REHS

Date: 8-17-12

ICHD-Environmental Health Division

I understand that this permit can be suspended or revoked if any false information is supplied toward securing the permit/any unauthorized changes are made to the site/any unauthorized changes are made in the installation of the system.

Signed: [signature]

Improvement Permit by: Wesley Sparks R.S. date 11/15/96

~~Authorization to Construct~~ Existing System Inspection by: Wesley Sparks R.S. date 11/18/96

Installed by: FJ ERVIN

Certificate of Completion by: Wesley Sparks R.S. date 5/16/97

Operation Permit by: Wesley Sparks R.S. date 5/16/97

HEALTH DEPT. COPY: WHITE INSPECTION COPY (FINAL): GREEN OWNER COPY (FINAL): YELLOW INSPECTION COPY (INITIAL): PINK OWNER COPY (INITIAL): GOLD